


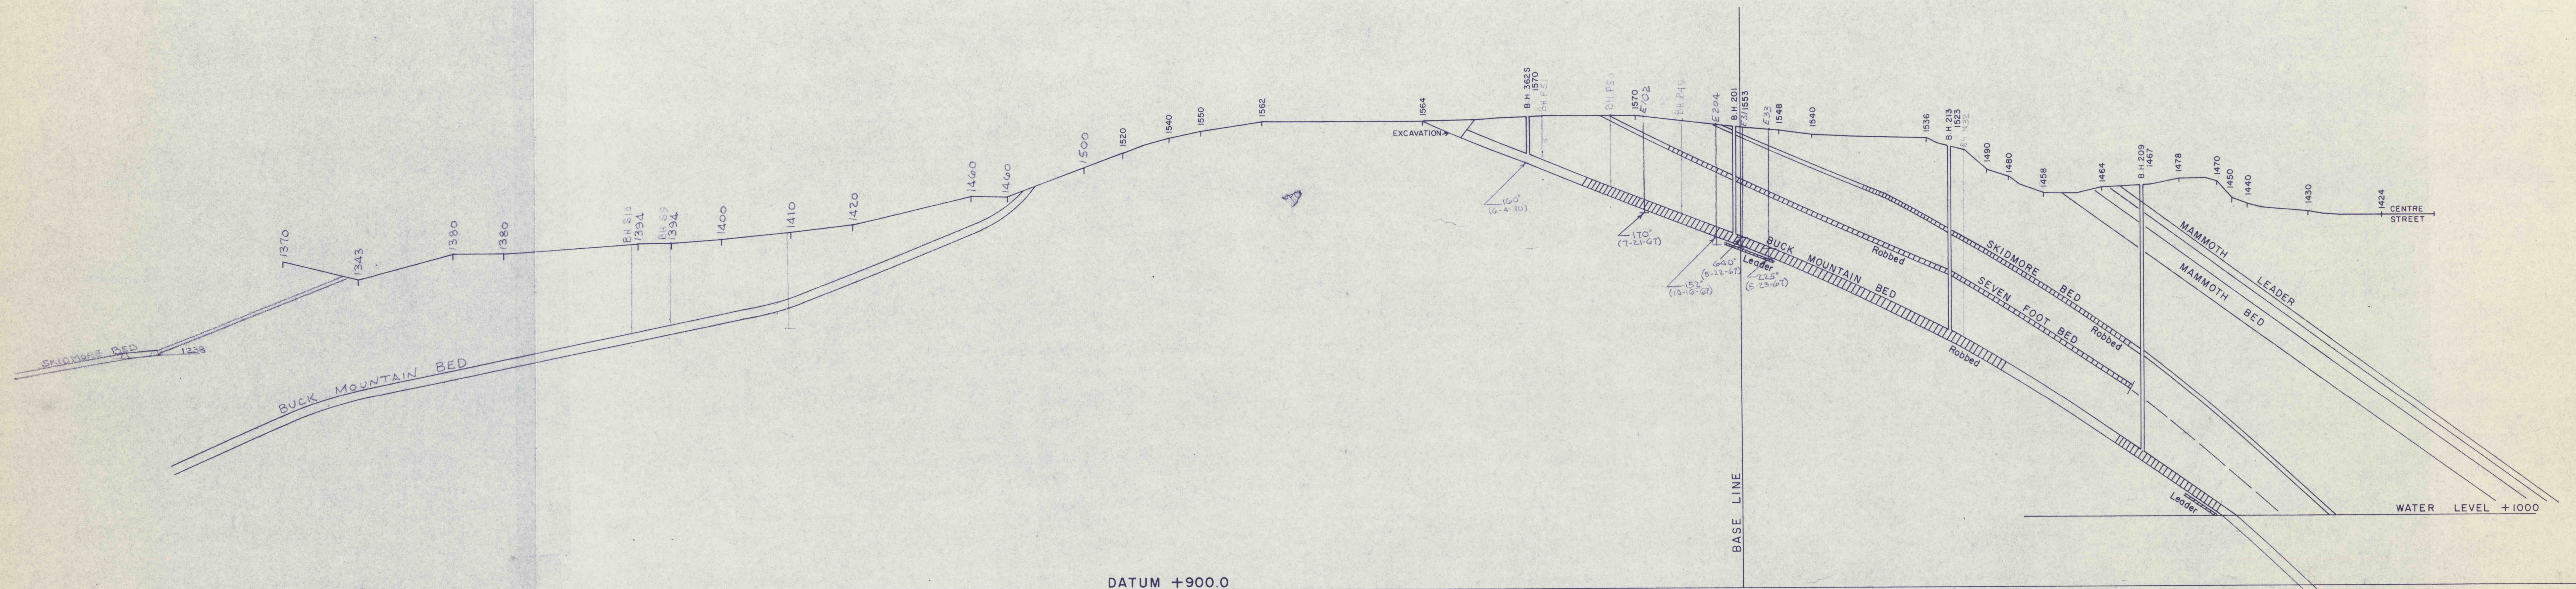

SECTION 7 LOOKING WEST SCALE 1"=100'
CENTRALIA