


DAM 26" THICK
HITCH 1'-6" DEEP
7000 BRICK
70 BAGS CEMENT
4 TONS SAND

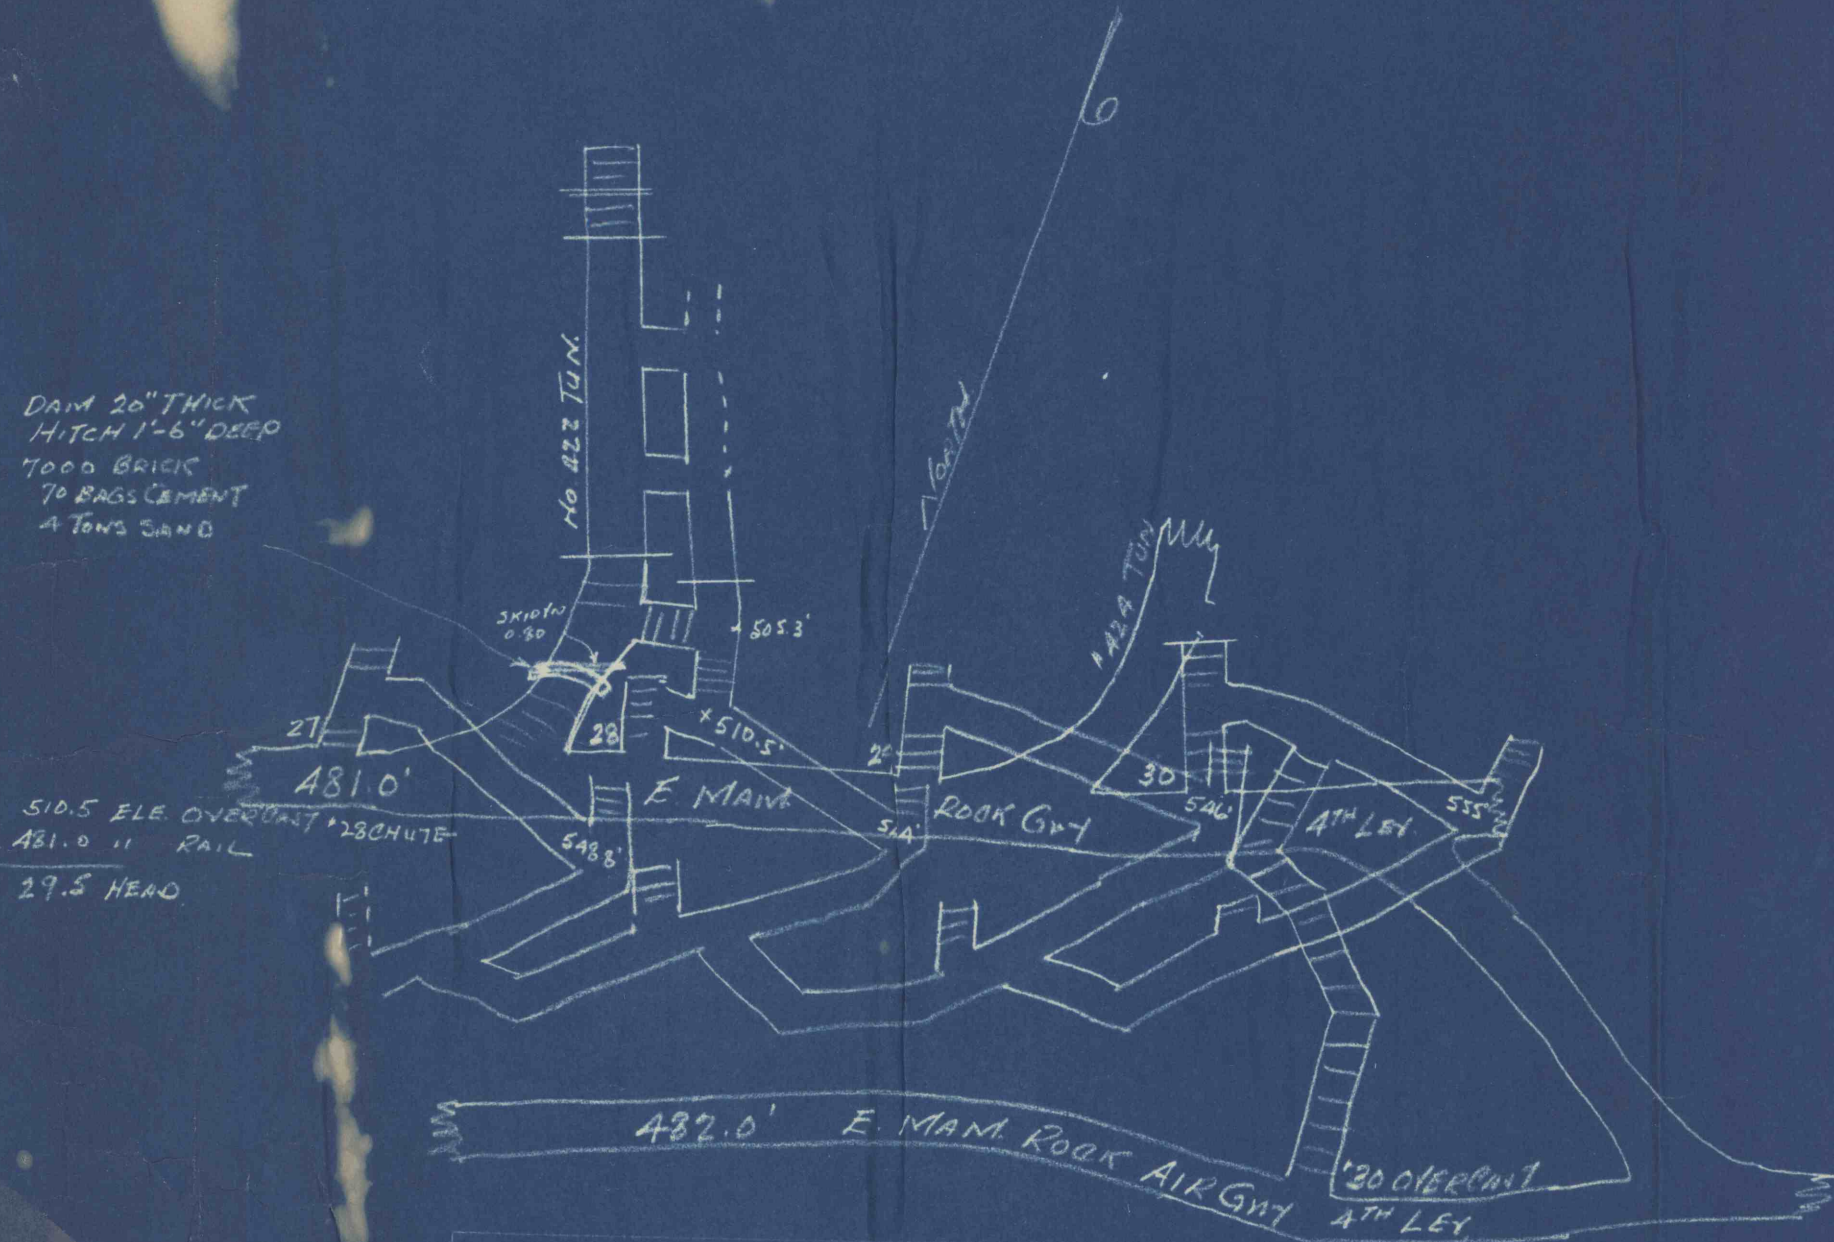

PLAN SHOWING LOCATION OF DAM
IN '222 TUN. 4TH LEVEL * 9 MINES
COALDALE COLLIERY
SCALE 1" = 40'