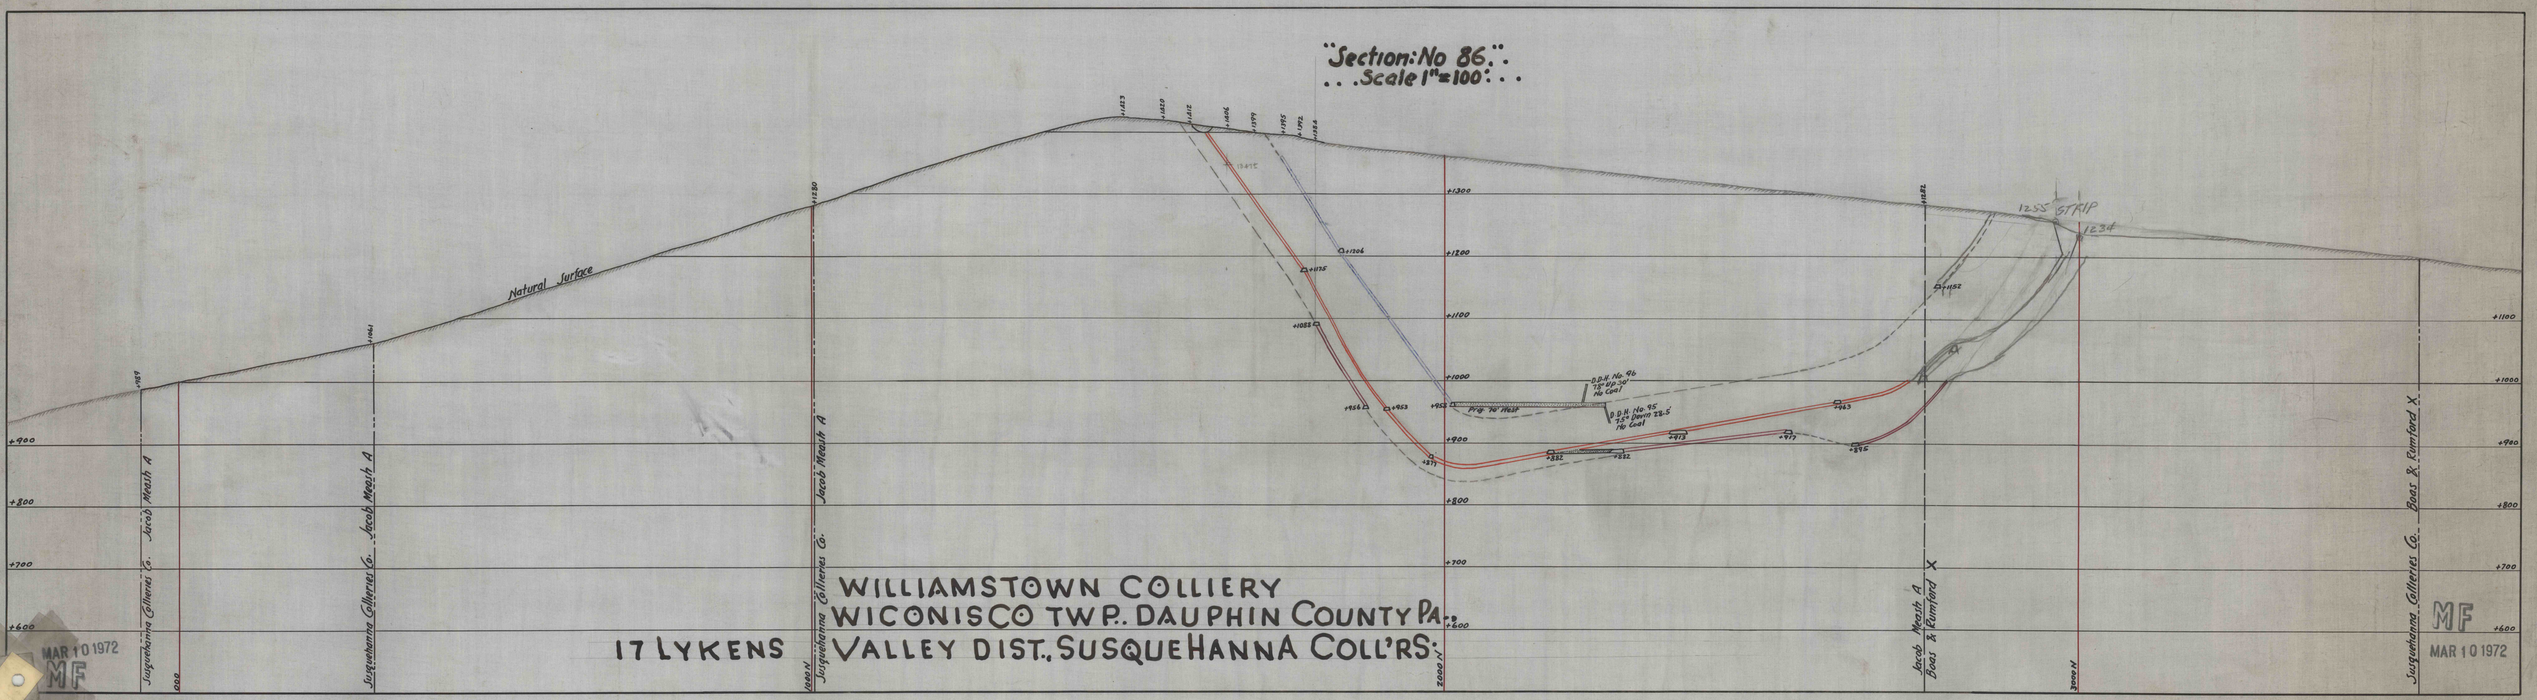

MAR 10 1972
MF