


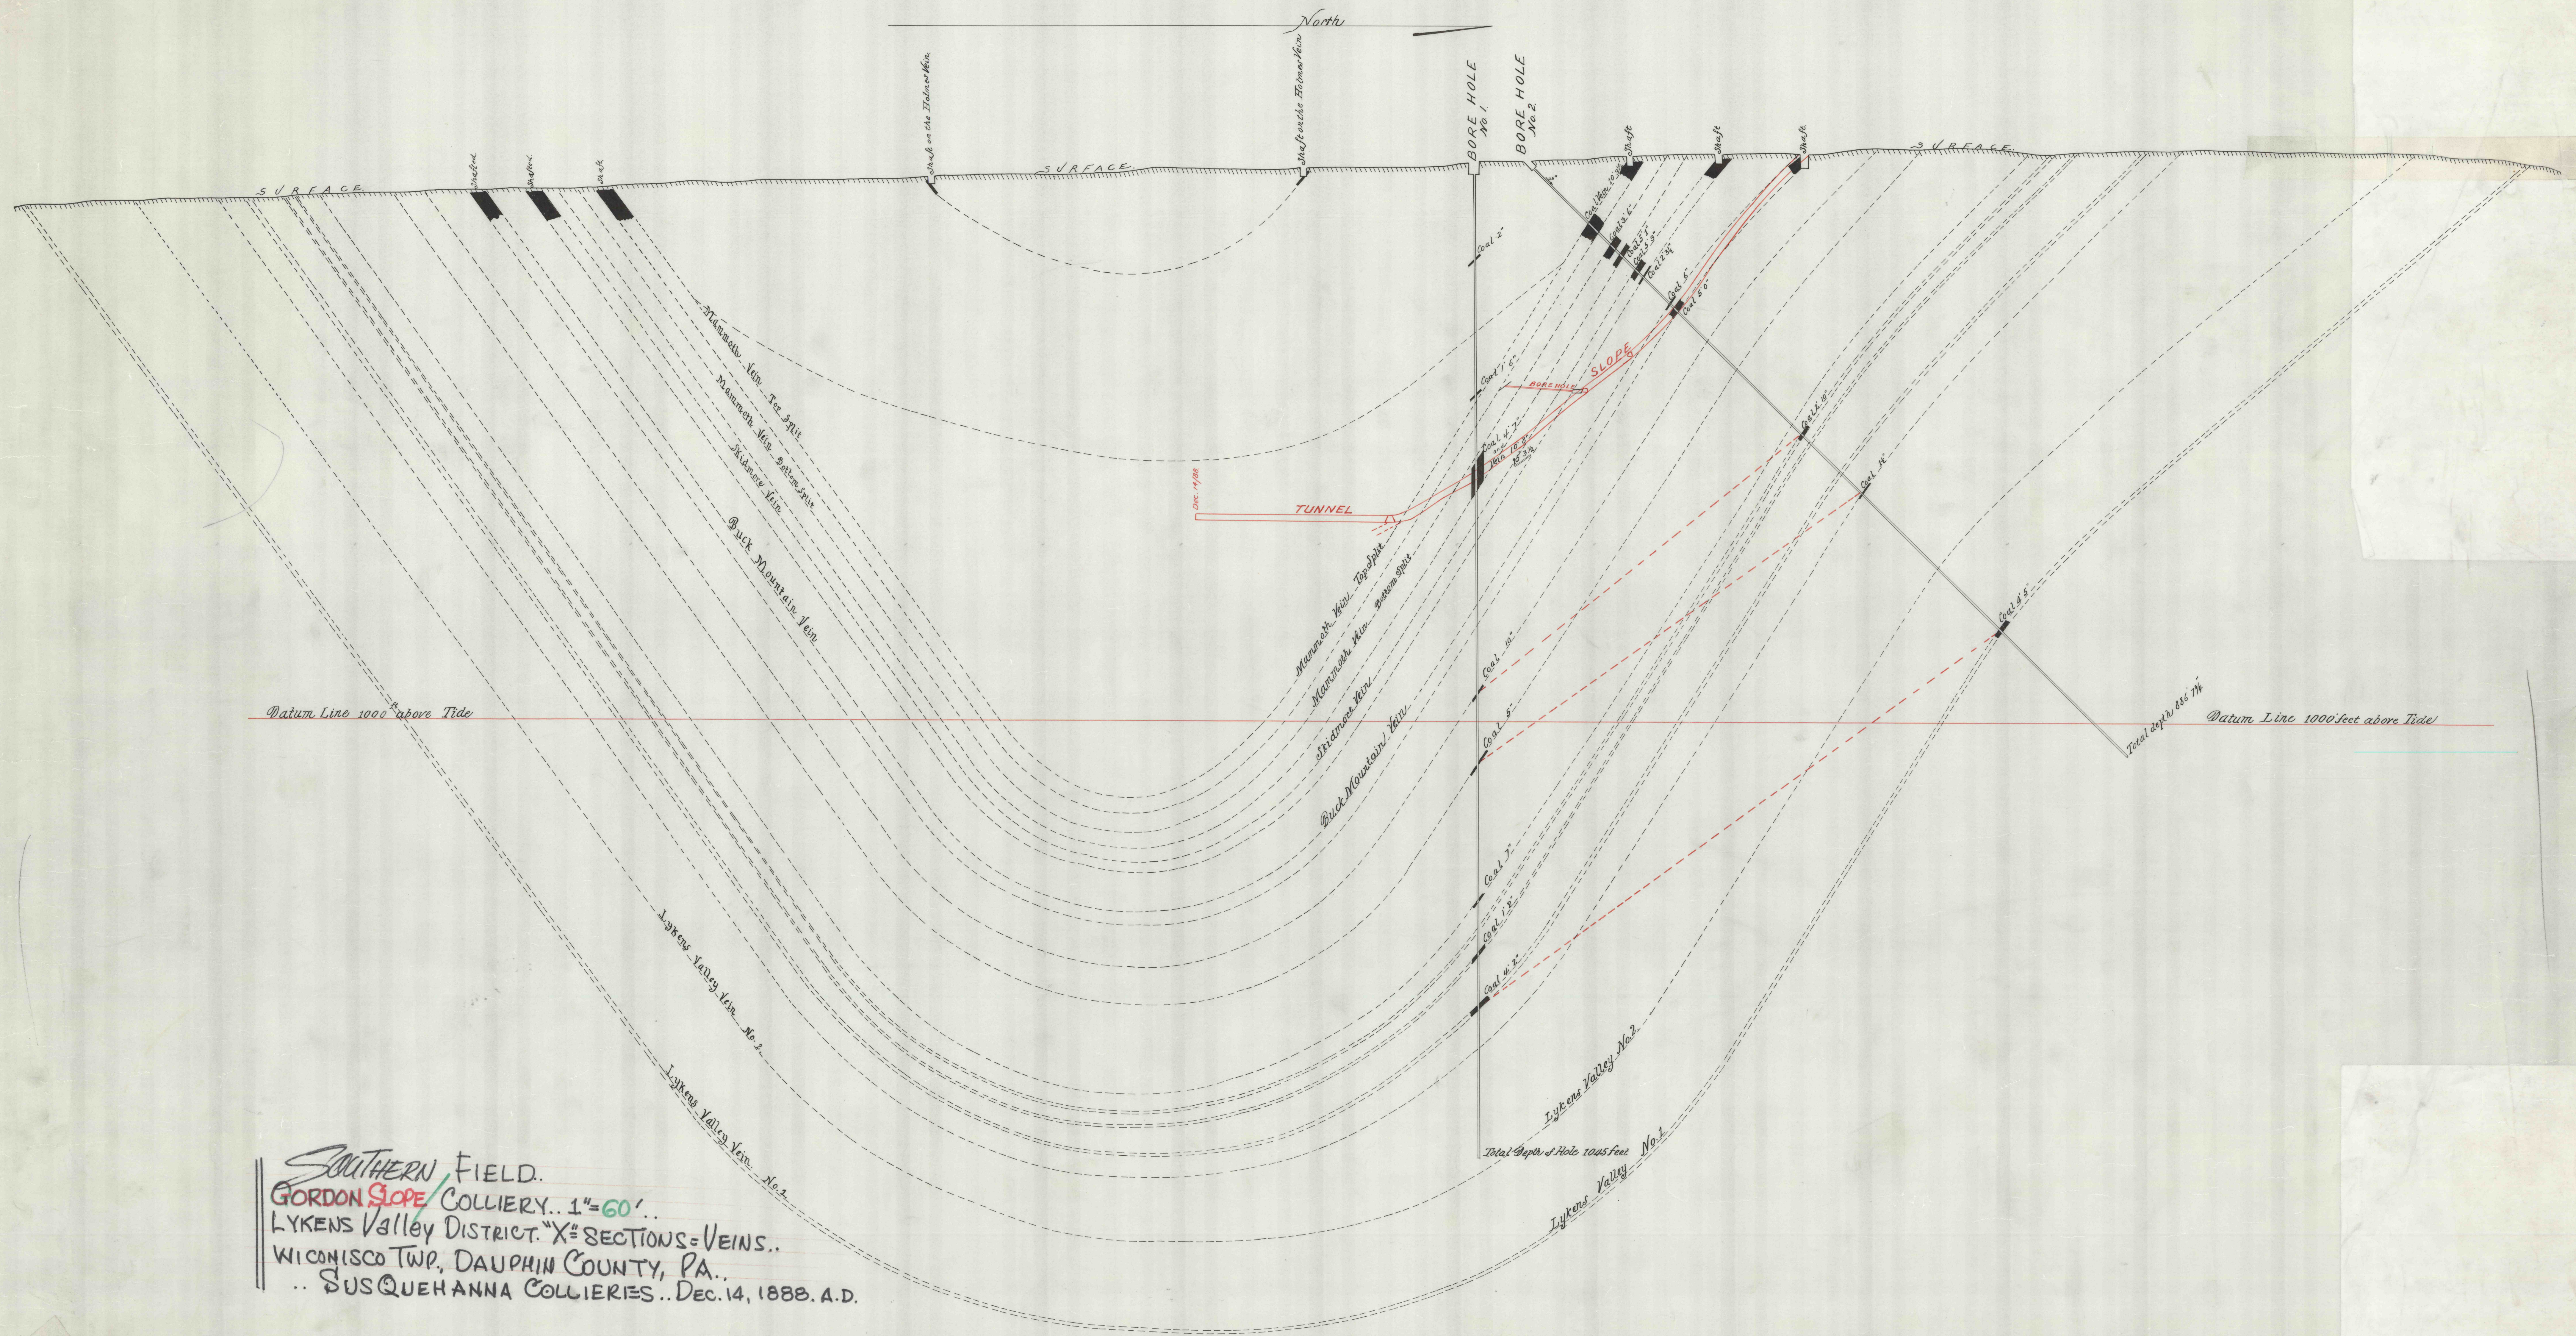

SOUTHERN FIELD.
 GORDON SLOPE COLLIERY.. 1"=60'..
 LYKENS VALLEY DISTRICT.. "X" SECTIONS=VEINS..
 WICONISCO TWP., DAUPHIN COUNTY, PA..
 .. SUSQUEHANNA COLLIERIES.. DEC. 14, 1888. A.D.


