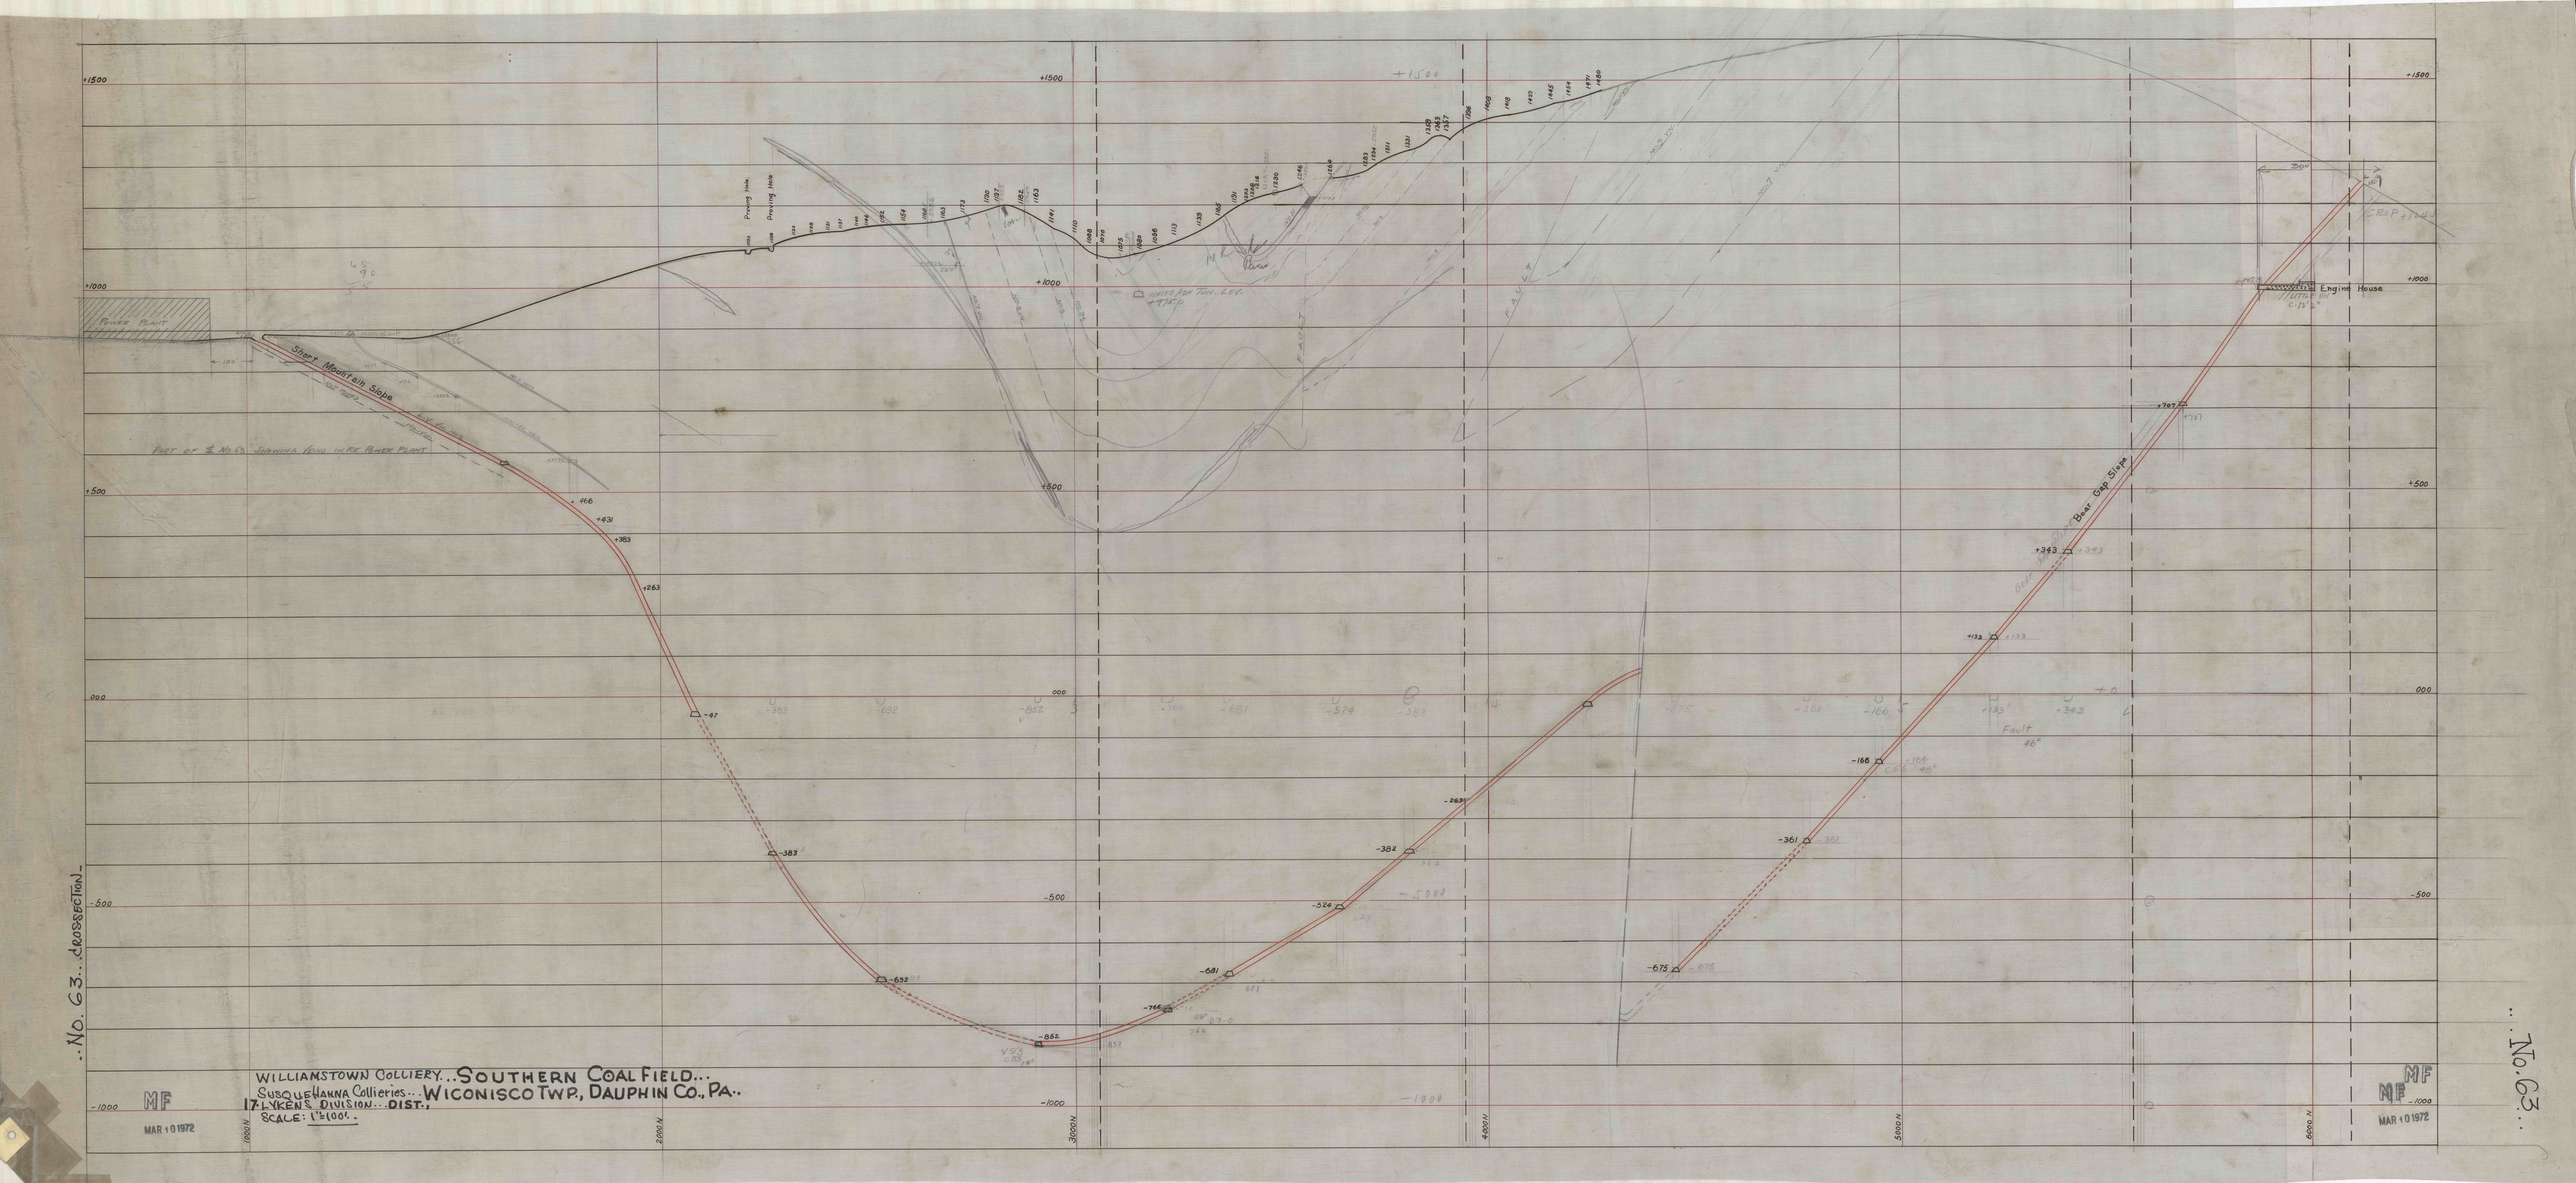


..No. 63.. Crossection..

WILLIAMSTOWN COLLIERY..SOUTHERN COAL FIELD...
SUSQUEHANNA Collieries..WICONISCO TWP., DAUPHIN CO., PA..
17. LYKENS DIVISION...DIST.;
SCALE: 1"=100'..

MF
MAR 10 1972

MF
MF
MAR 10 1972

..No. 63...