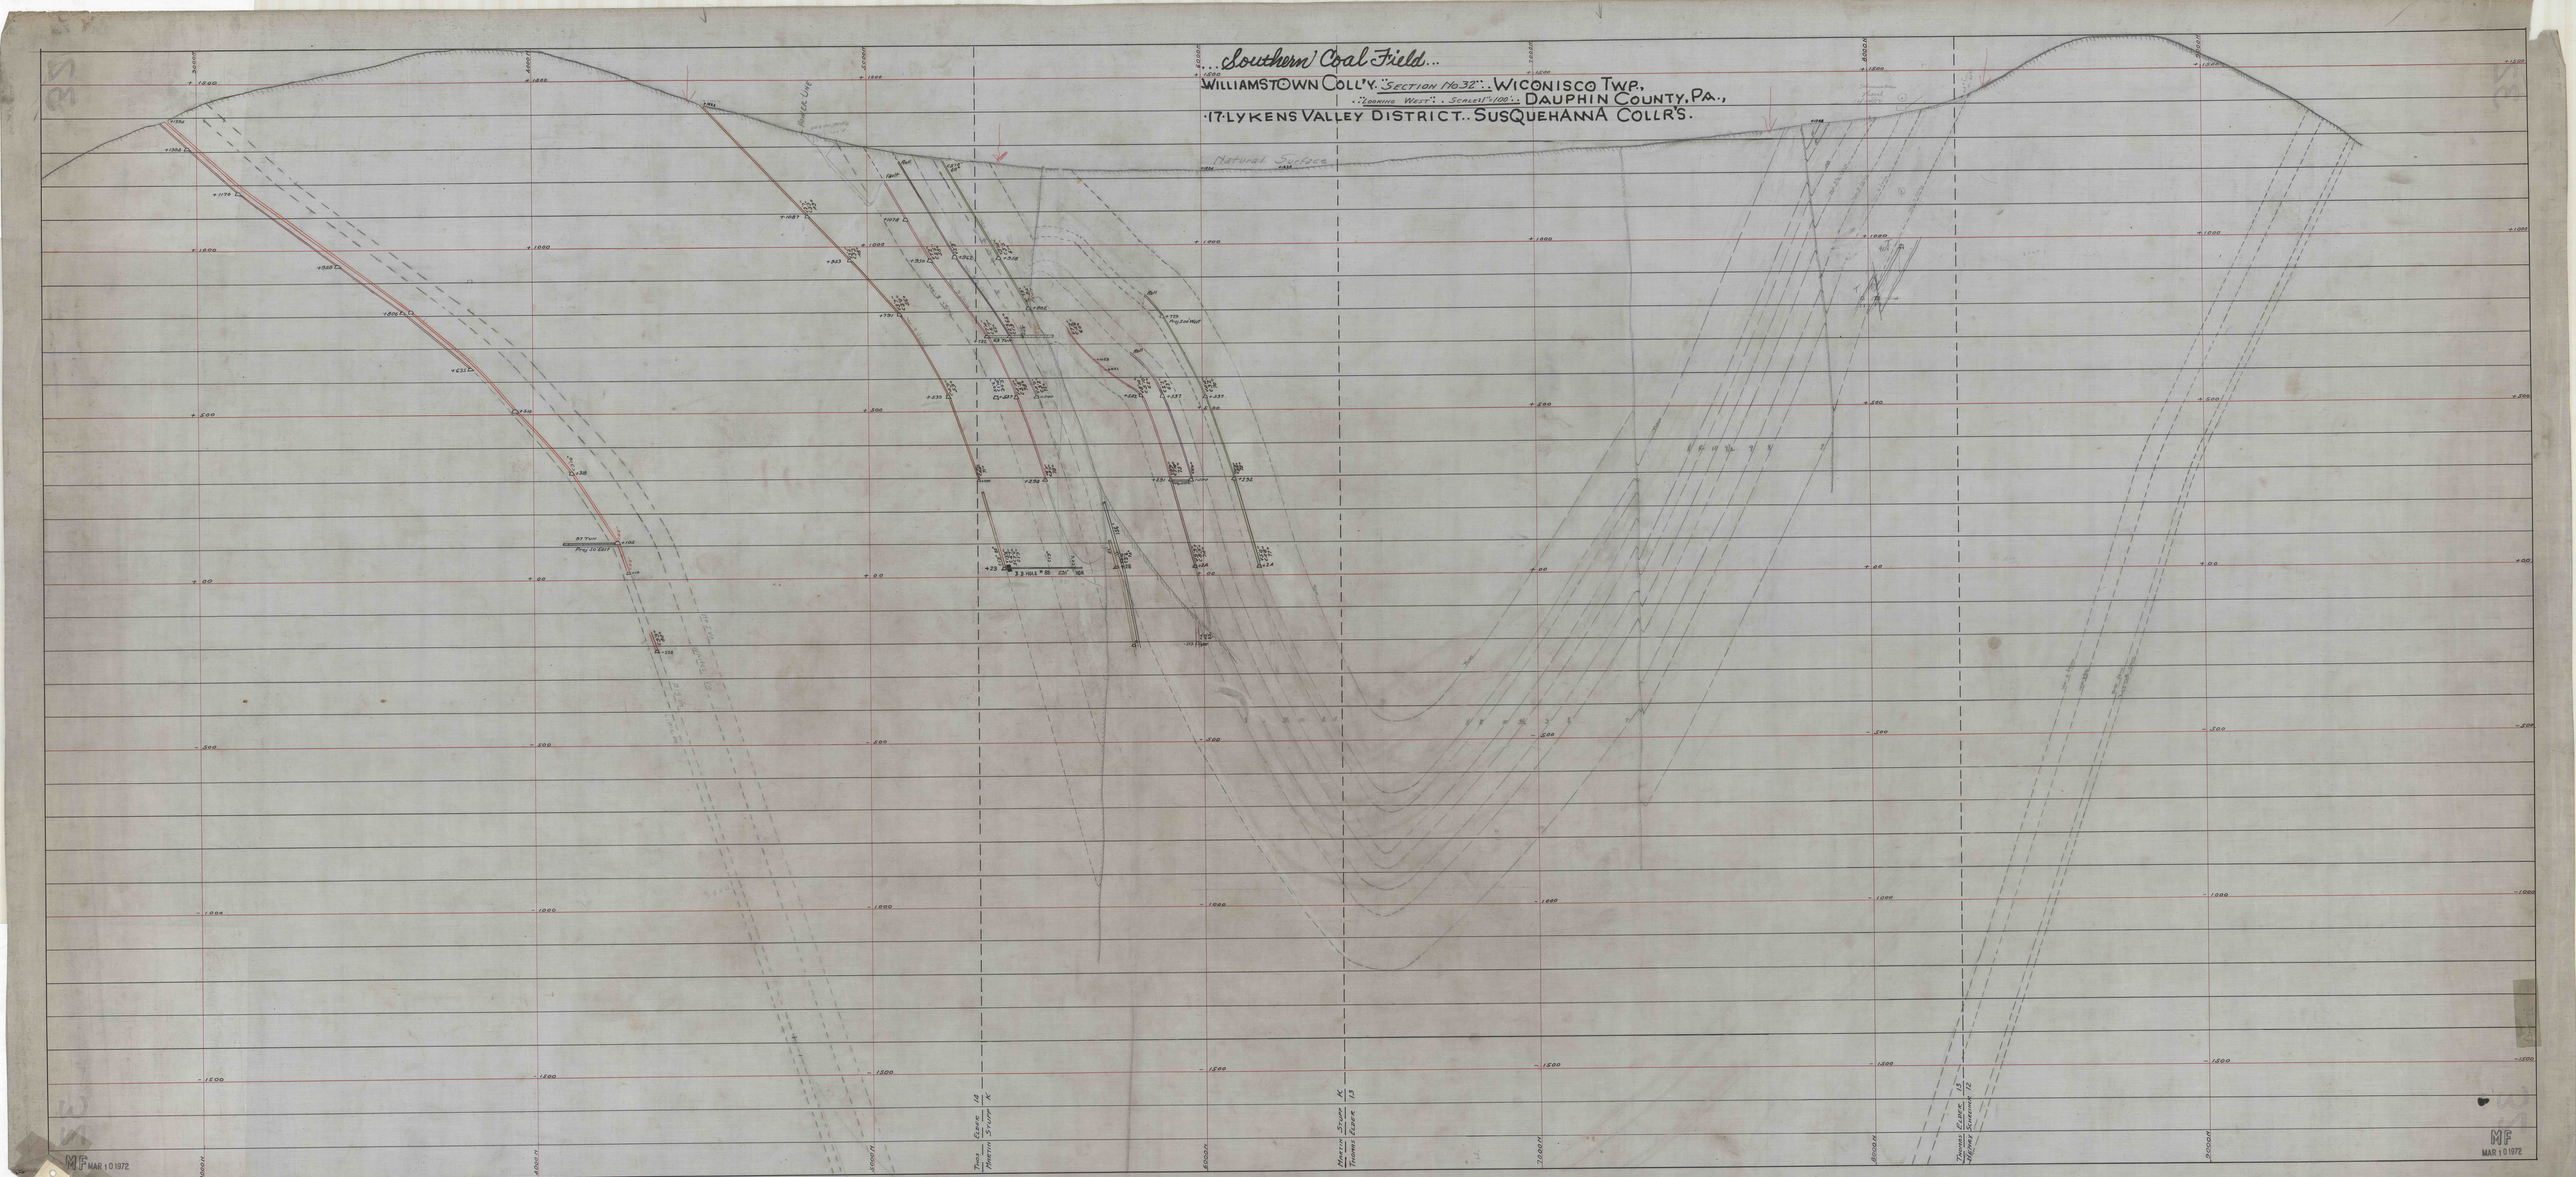

...Southern Coal Field...
WILLIAMSTOWN COLL'Y. "SECTION NO 32"... WICONISCO TWP.,
"LOOKING WEST". SCALE 1"=100'... DAUPHIN COUNTY, PA.,
17. LYKENS VALLEY DISTRICT.. SUSQUEHANNA COLL'RS.
Natural Surface
Tunn. Clark 14
Martin Stump K
Martin Stump K
Thomas Keiser 13
Thomas Clark 14
Michael Scotchman 12
MF MAR 10 1972
MF MAR 10 1972