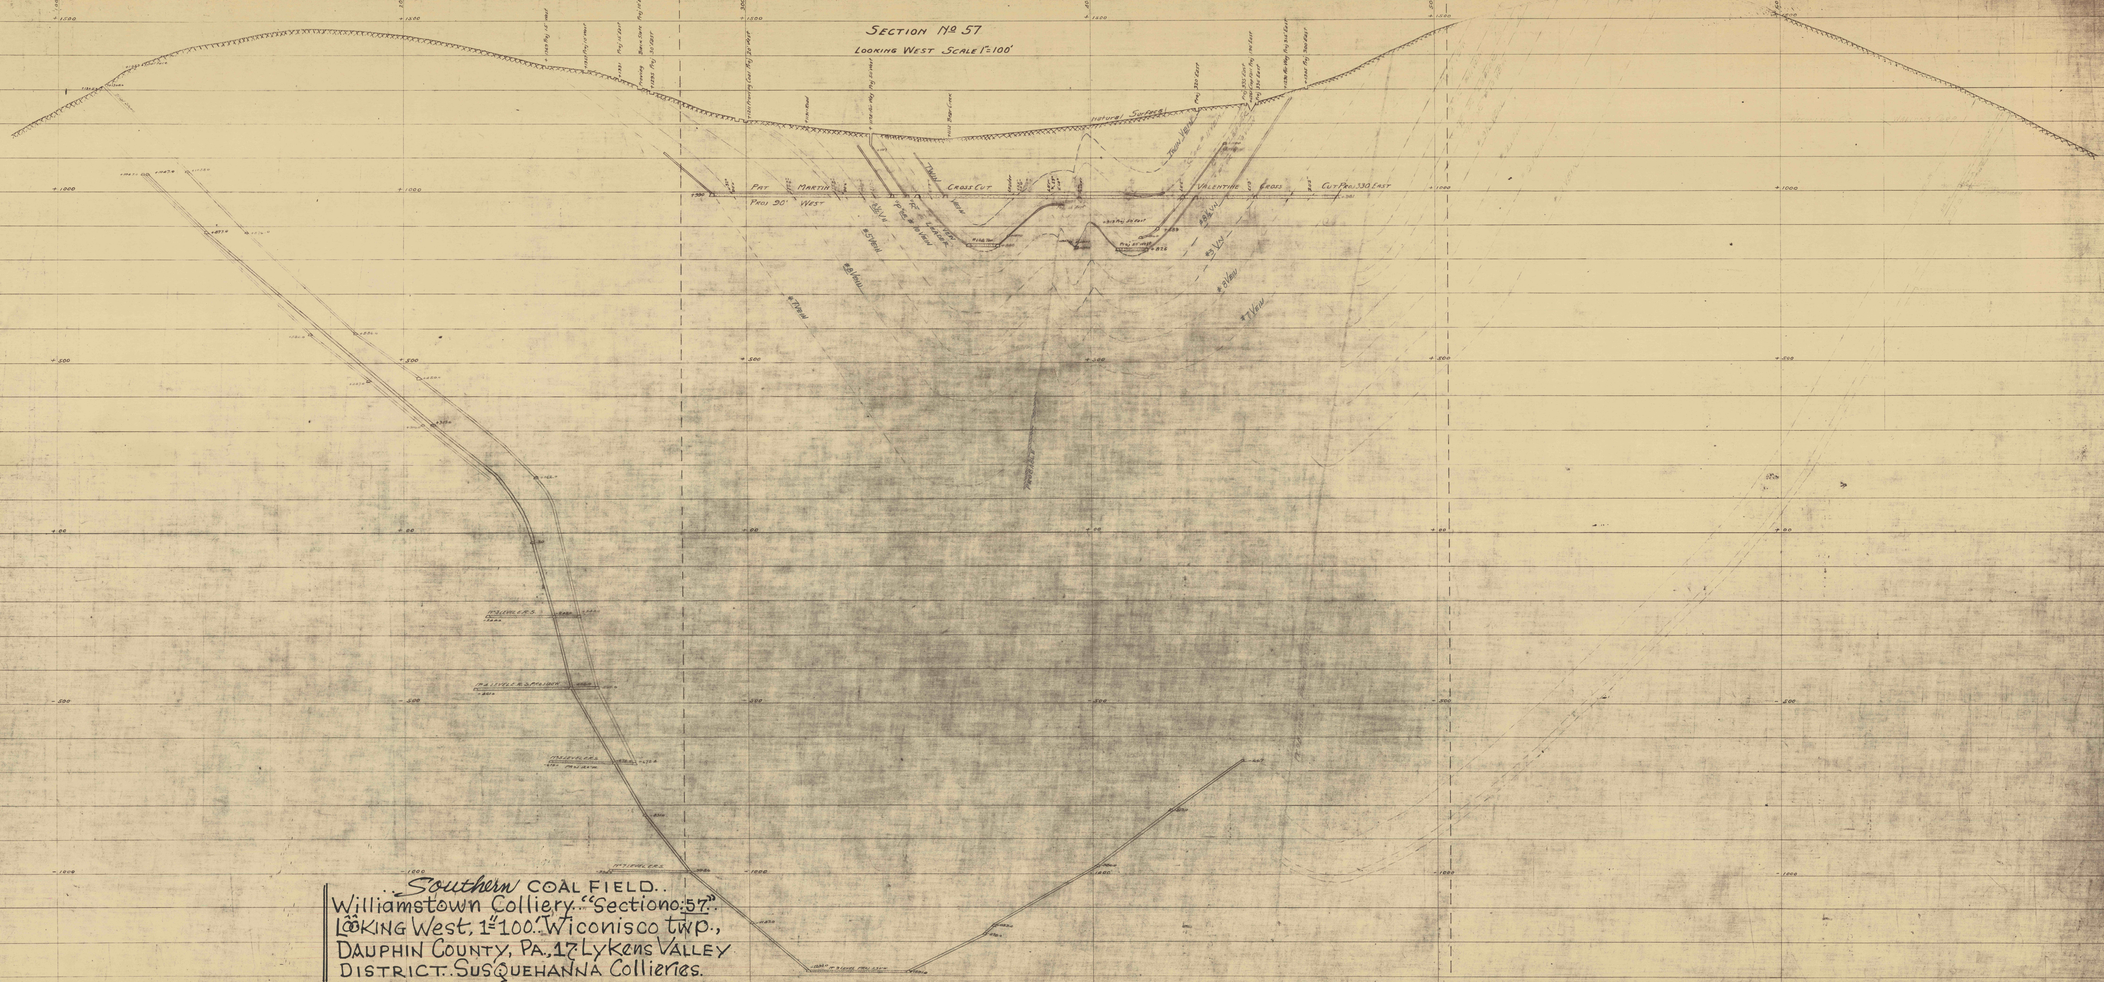


Southern COAL FIELD.
Williamstown Colliery. "Section No. 57".
LOOKING West, 1"=100'. Wiconisco twp.,
DAUPHIN COUNTY, PA., 17 Lykens VALLEY
DISTRICT. SUSQUEHANNA Collieries.

MAR 10 1972 MF

MAR 10 1972 MF