


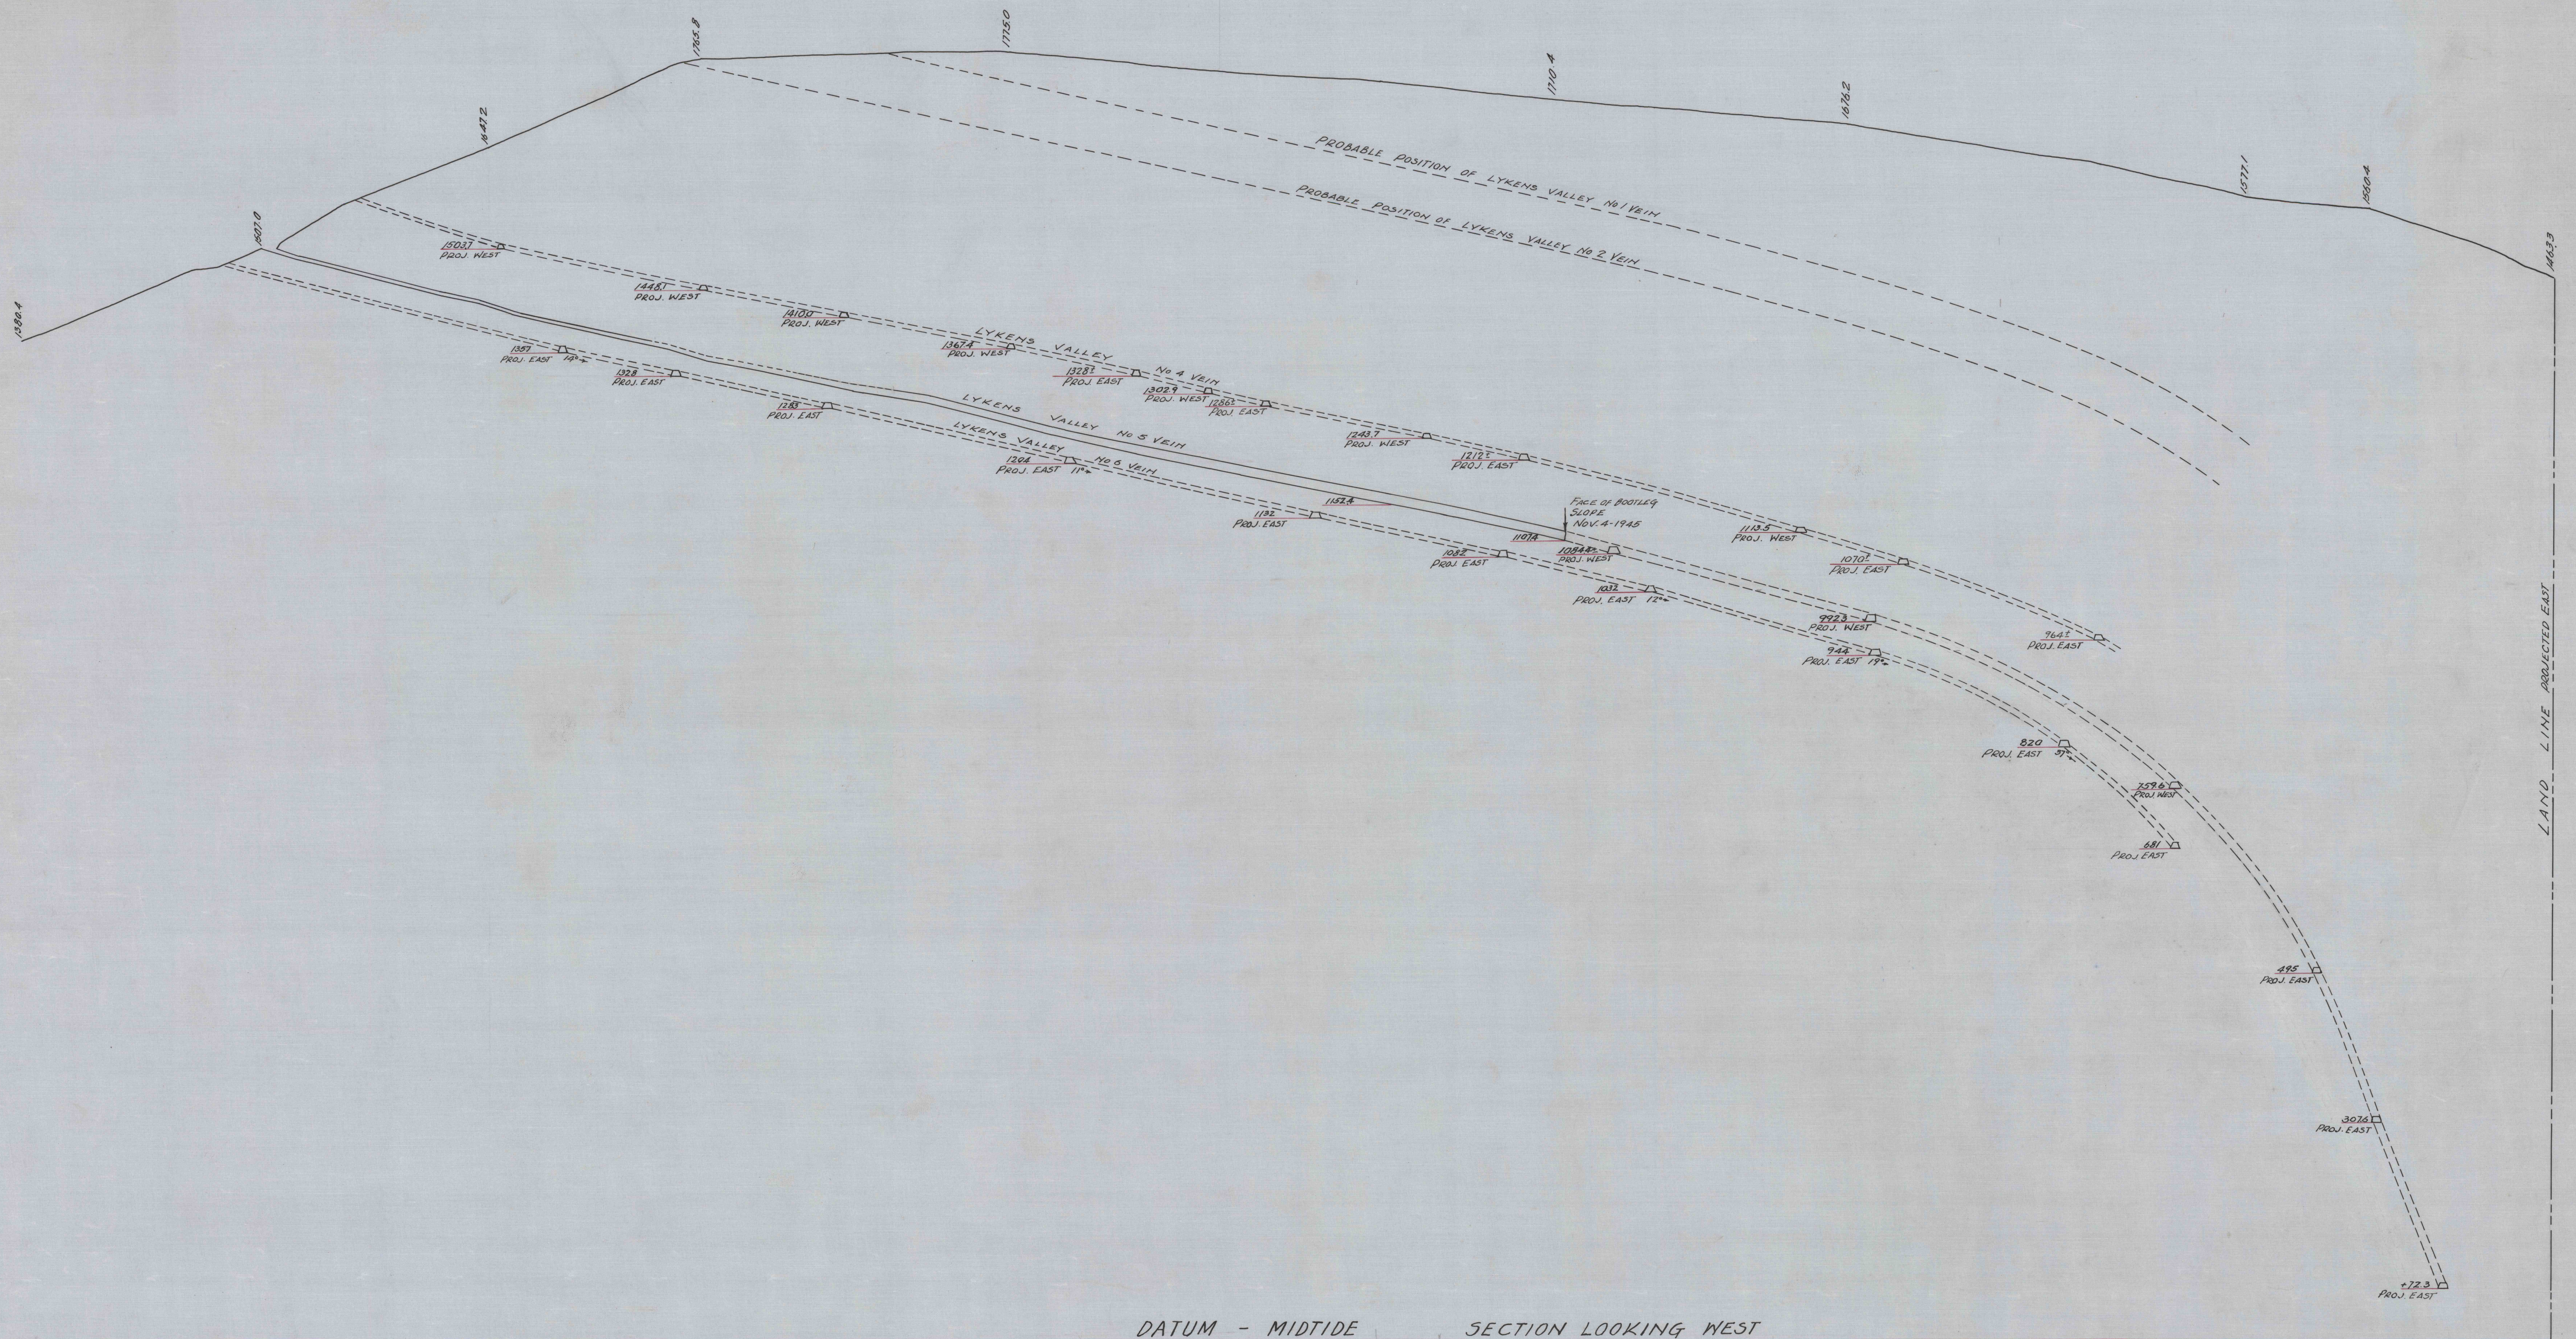

DATUM - MDTIDE SECTION LOOKING WEST

..Southern Coal Field..
 CROSS SECTION THROUGH BARRIER PILLAR
 BETWEEN :WICONISCO TWP. DAUPHIN COUNTY,
 :WILLIAMSTOWN AND BROOKSIDE COLLIERIES..PORTER TWP. SCHUYLKILL CO. PA..
 SCALE 1"=100 FT NOVEMBER 4-1945 ..SHEET: 1-OF-2..
 THOMAS J. LEWIS CONSULTING ENGINEER
 FRACKVILLE PA.