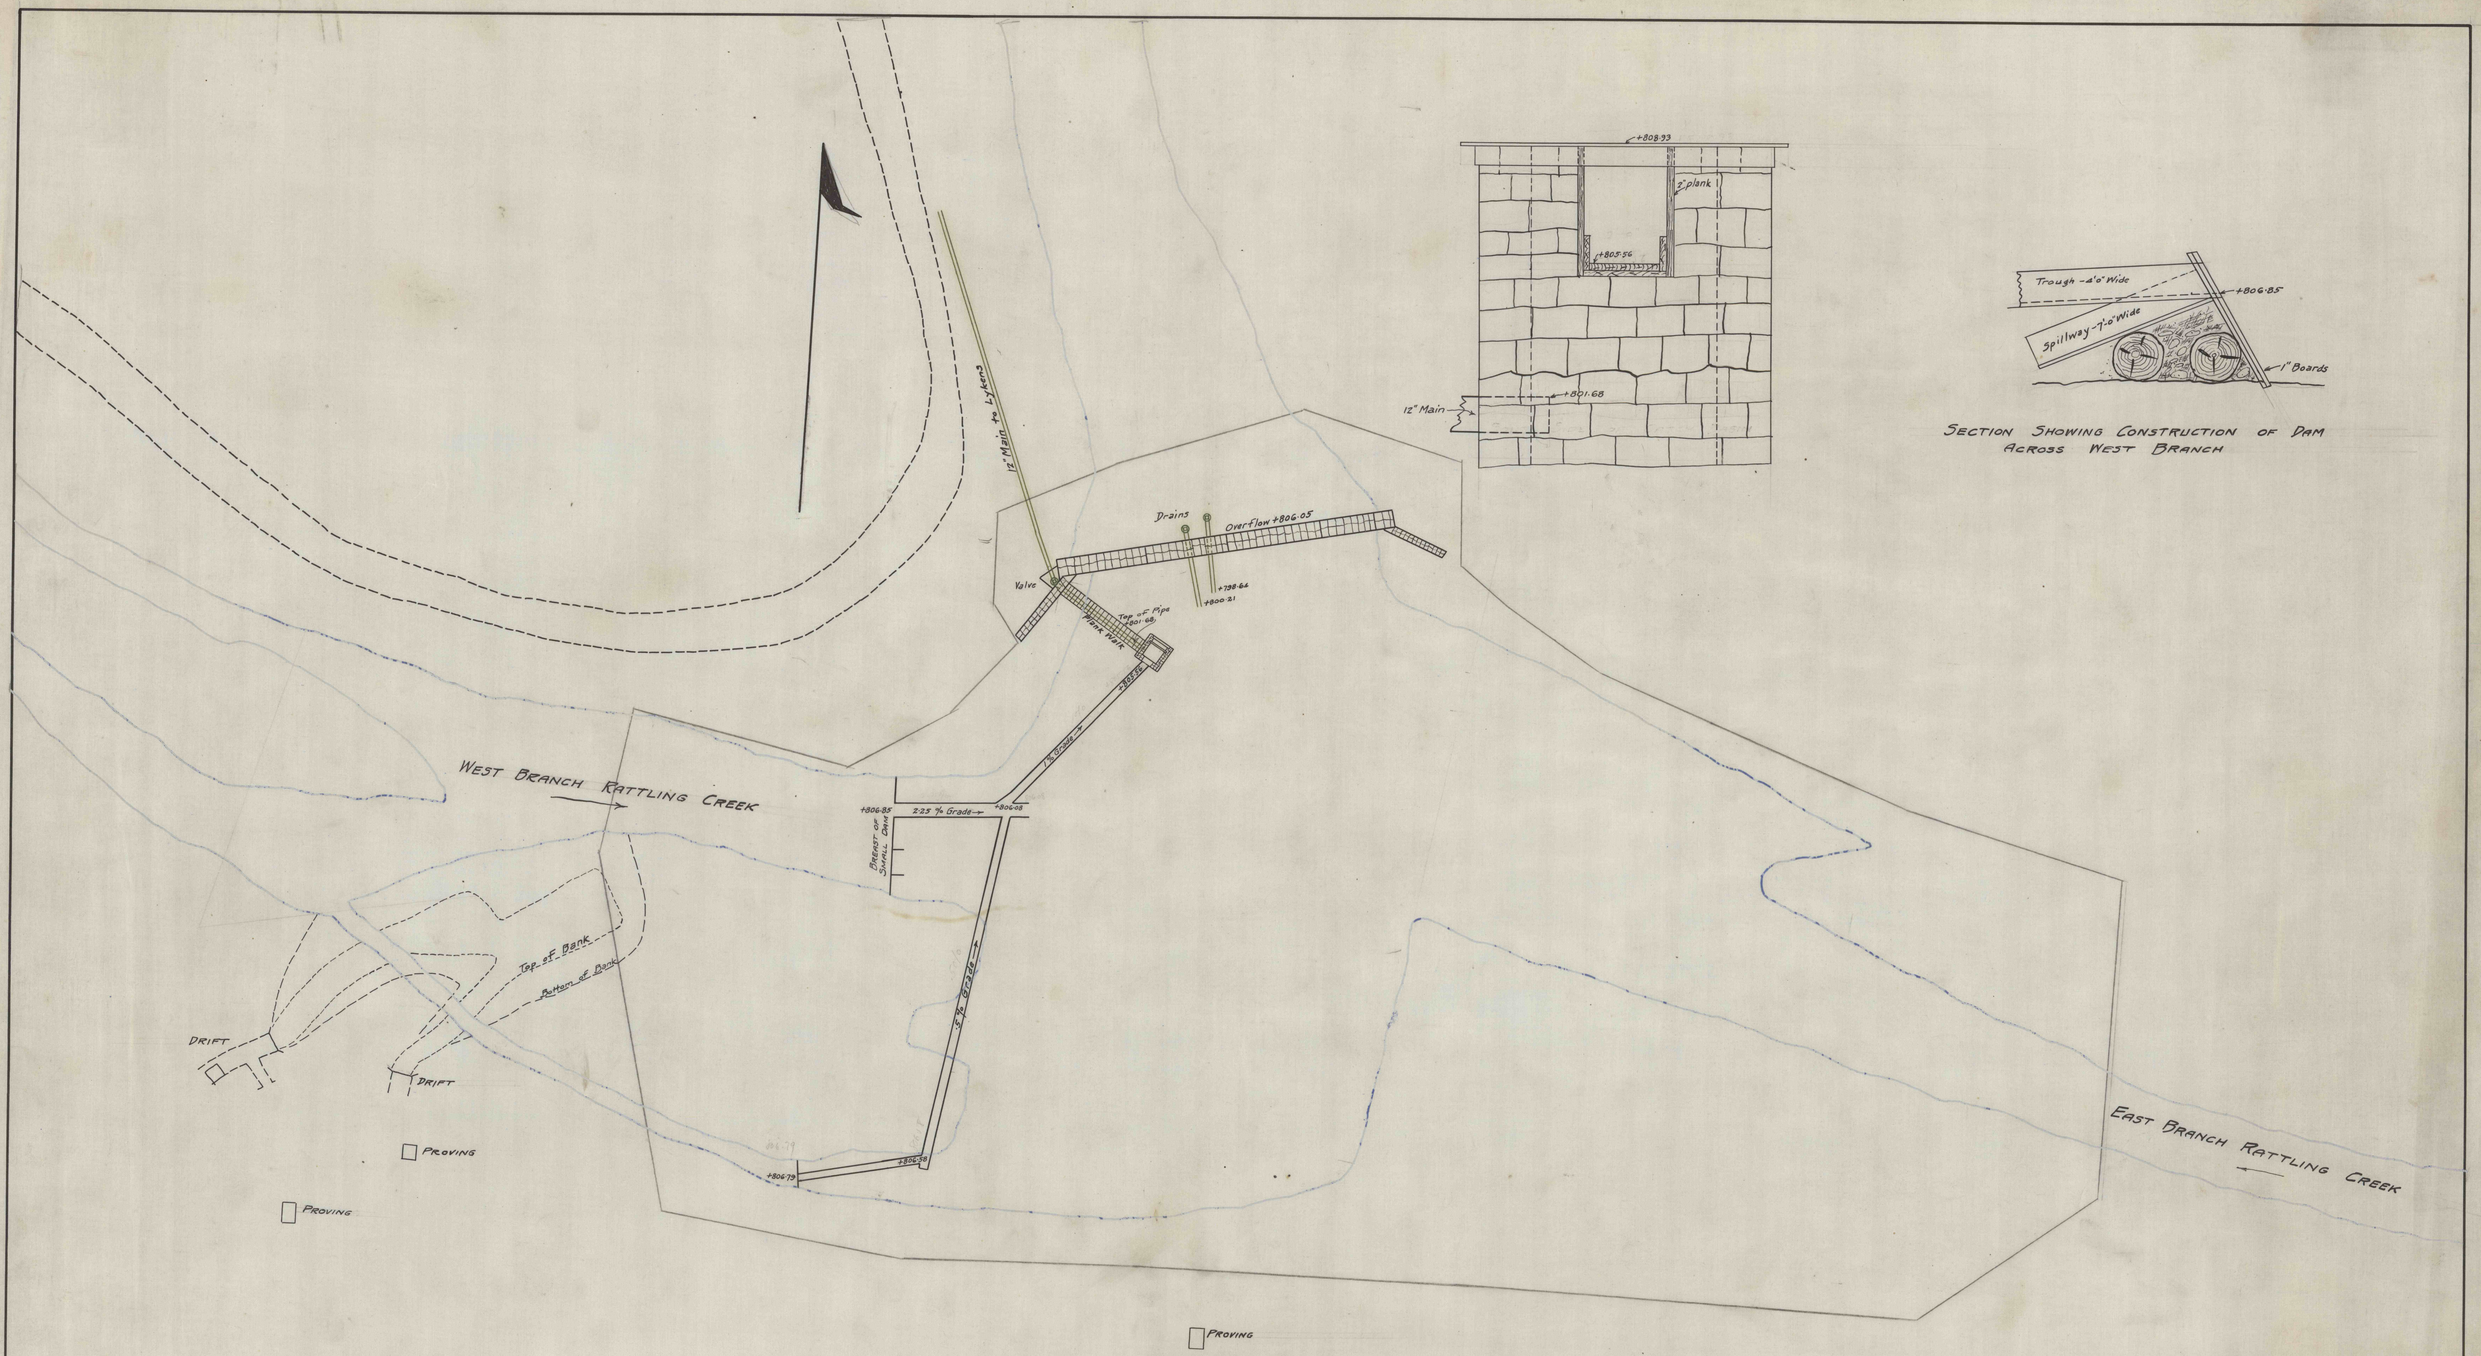

MAP OF LYKENS WATER CO'S. RESERVOIR
SHOWING TROUGHS AND DAMS
BUILT FOR PURPOSE OF CLEANING RESERVOIR
LYKENS PA. SEPT. 19, 1913 SCALE 1"=20'

X/32

X/32