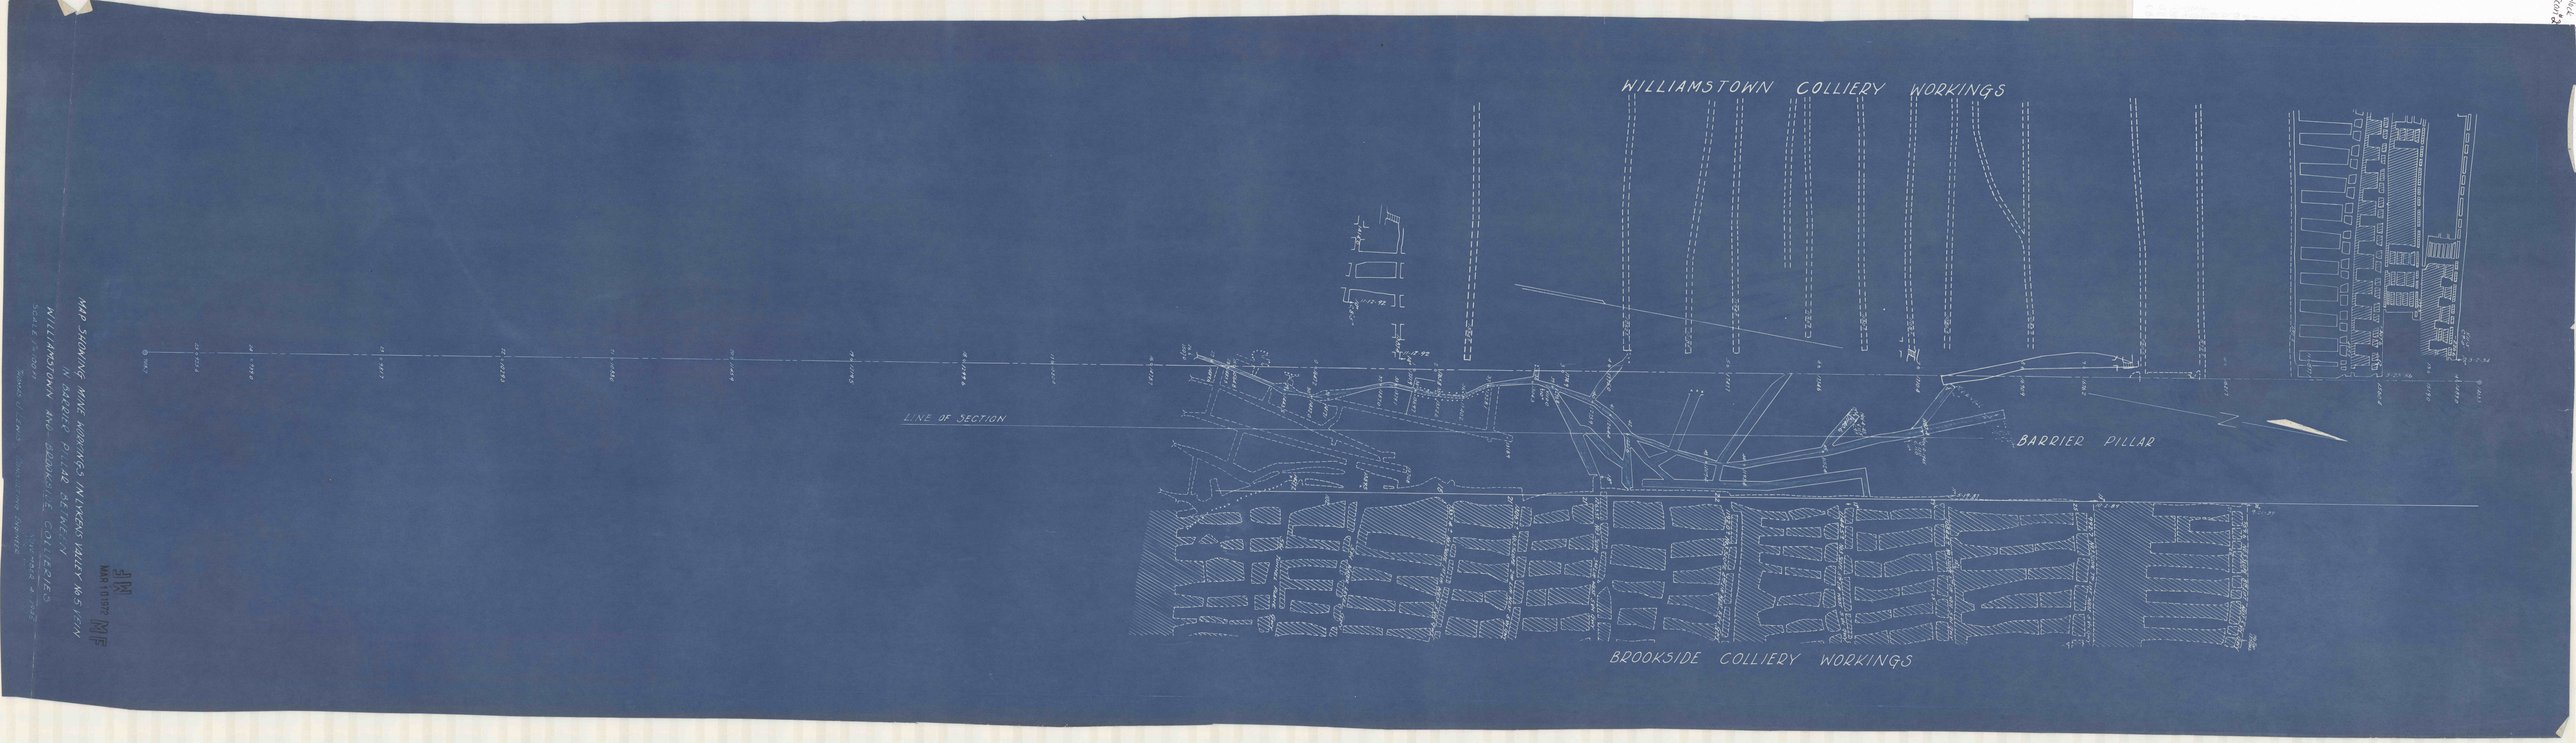

MAP SHOWING MINE WORKINGS IN LYKENS VALLEY NO. 5 VEIN IN BARRIER PILLAR BETWEEN WILLIAMSTOWN AND BROOKSIDE COLLIERIES

SCALE 1" = 200'

THOMAS L. KIMS CONSULTING ENGINEER

MAR 10 1972

MF