


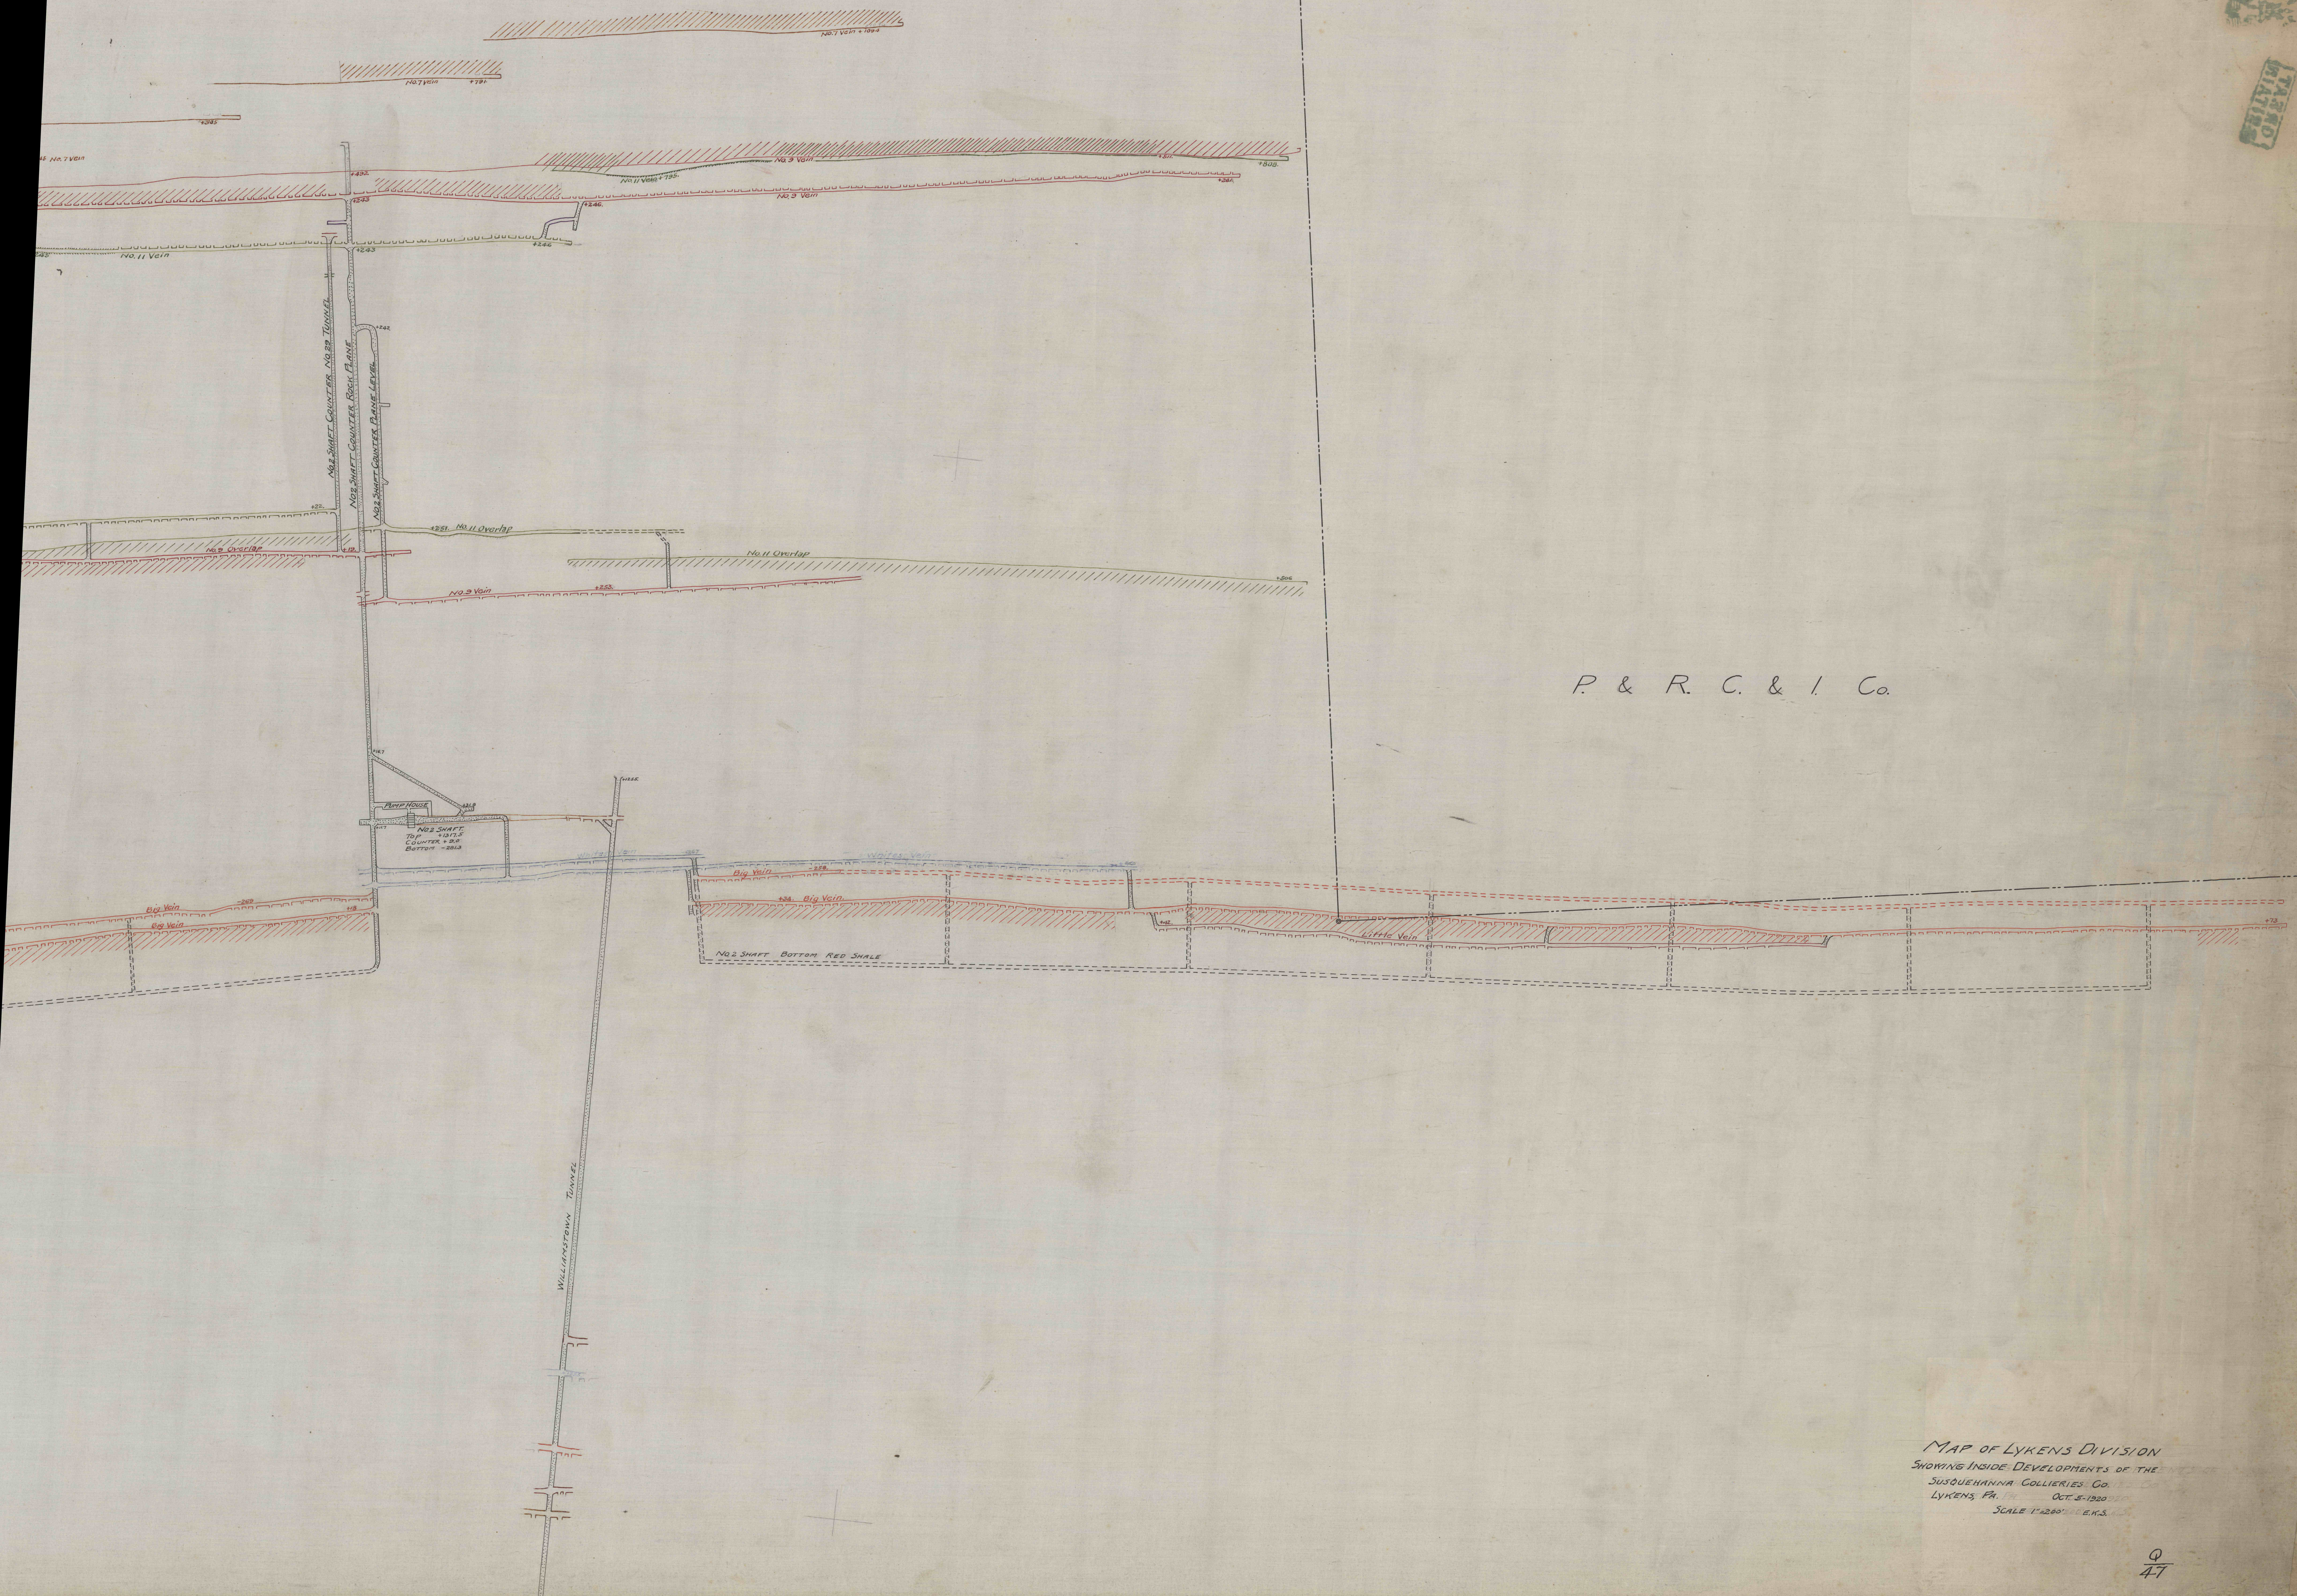

P. & R. C. & I. Co.

MAP OF LYKENS DIVISION
 SHOWING INSIDE DEVELOPMENTS OF THE
 SUSQUEHANNA COLLIERIES CO.
 SCALE 1"=200' U.S.M.S.