


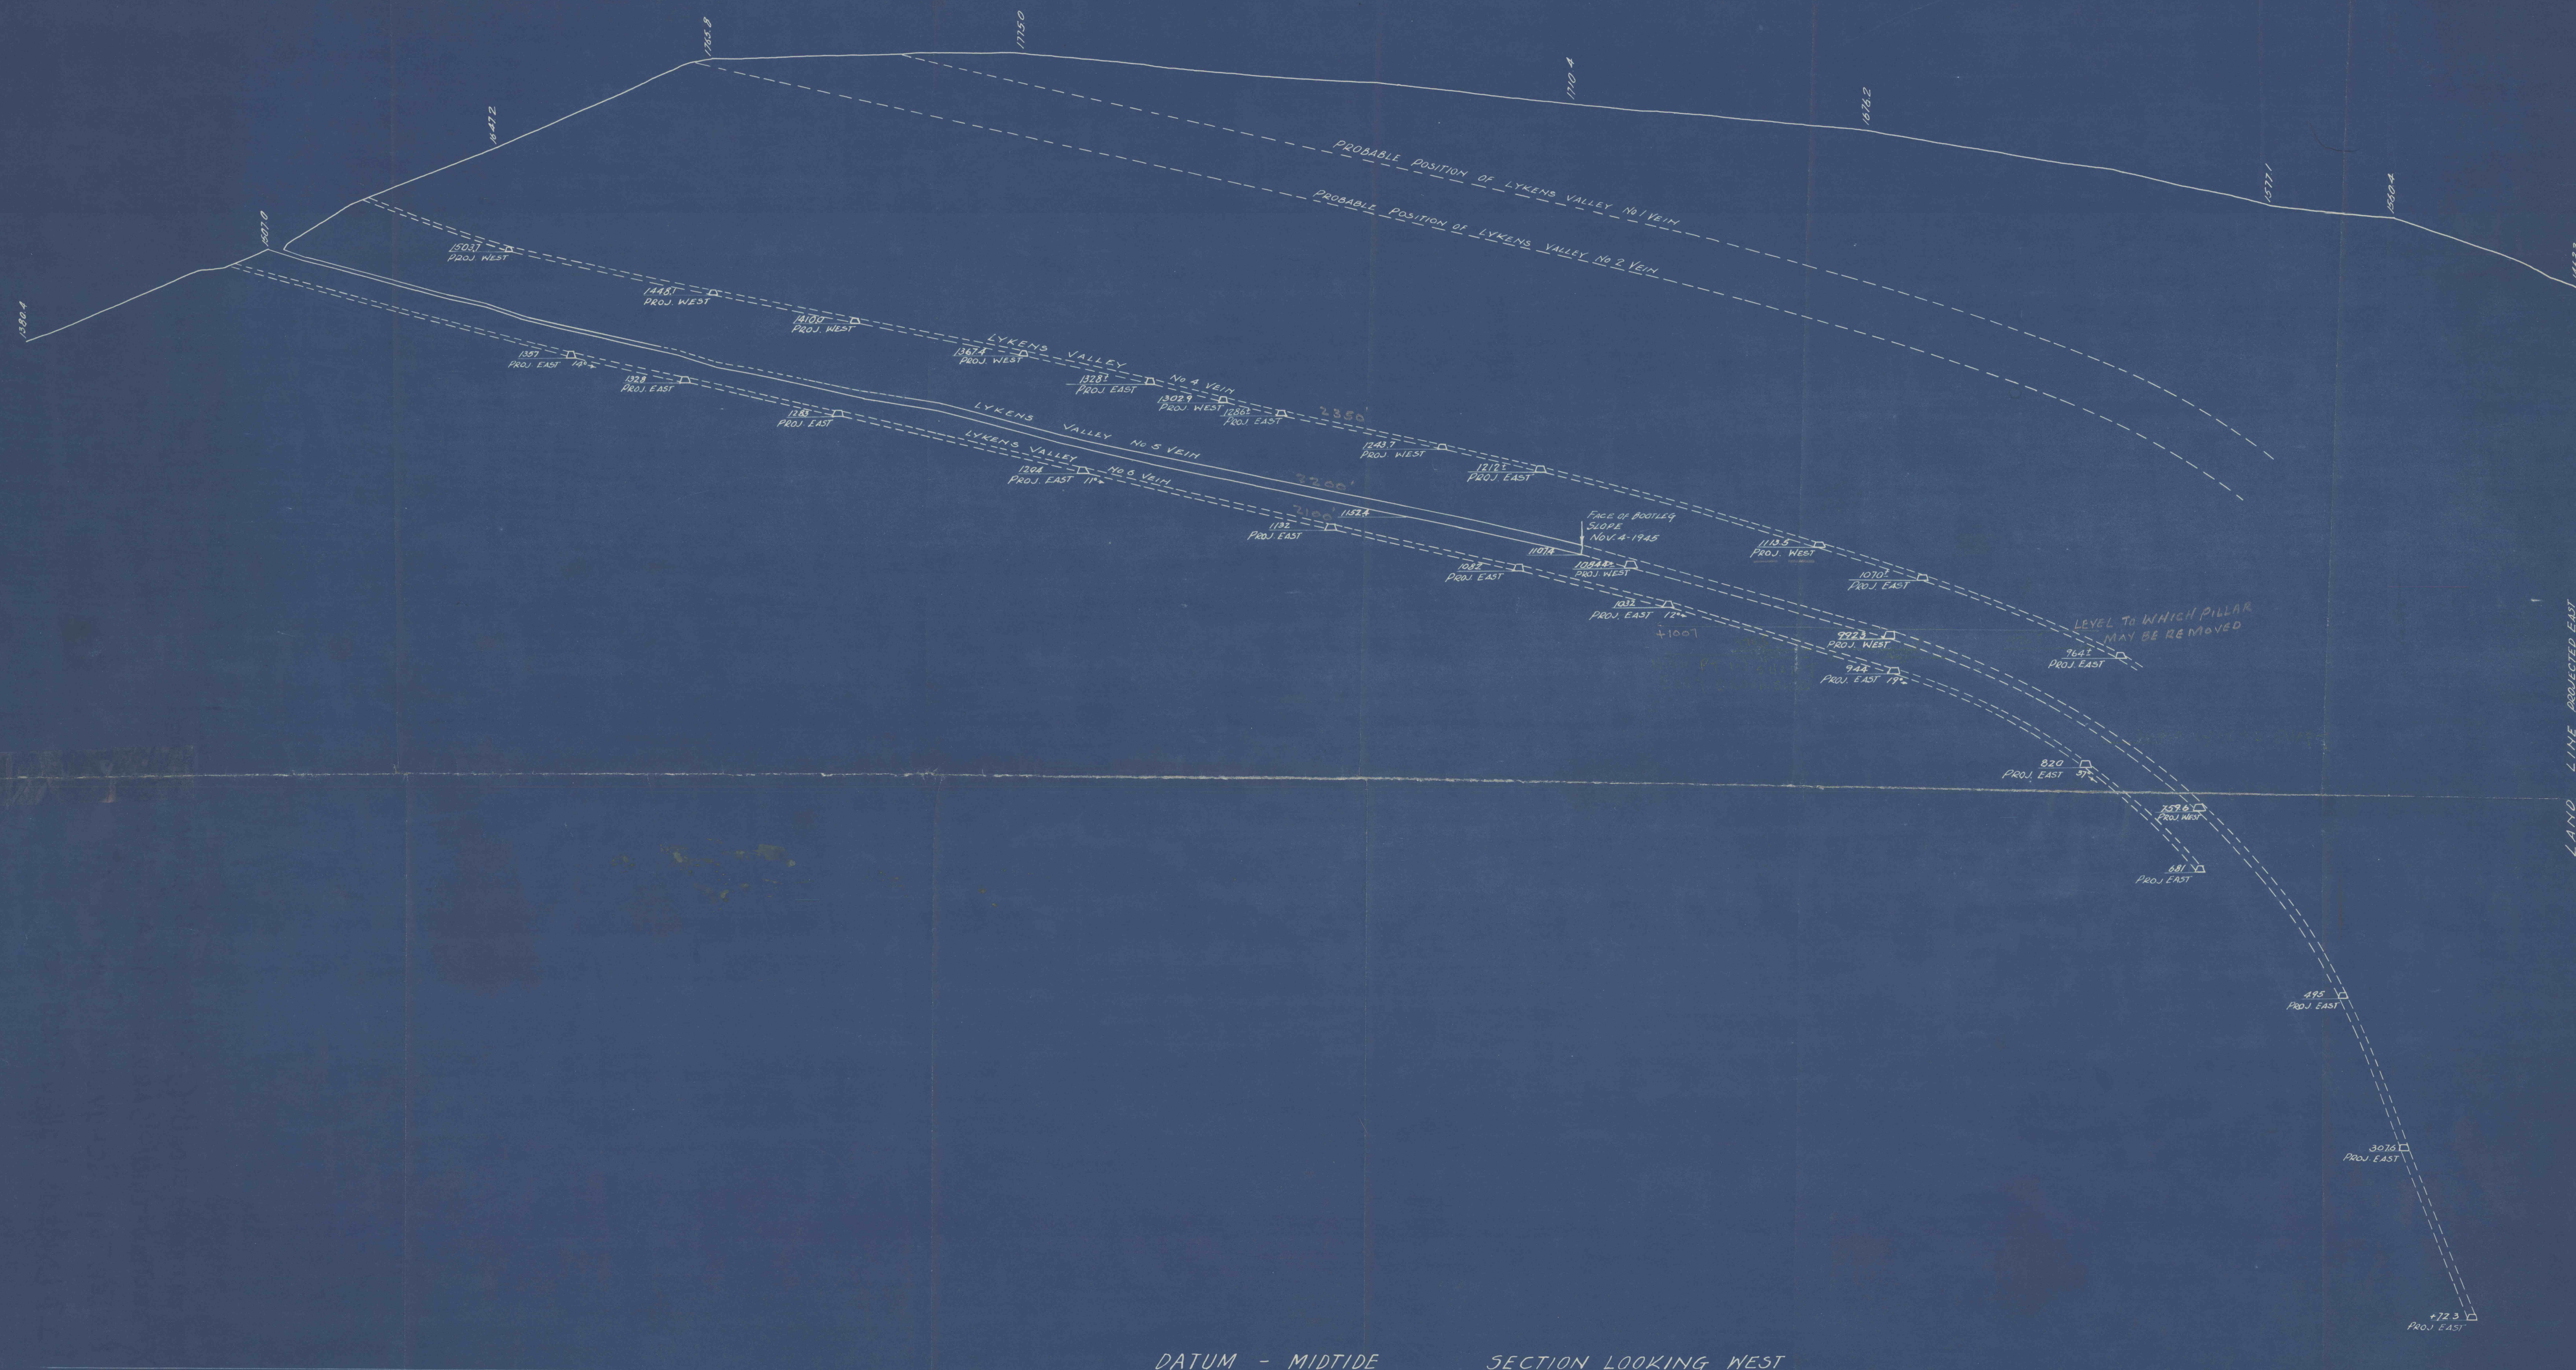

:: SOUTHERN FIELD ::
 CROSS SECTION THROUGH BARRIER PILLAR
 PORTER TWP. BETWEEN SCHUYLKILL CO., PA.,
 WILLIAMSTOWN AND BROOKSIDE COLLIERIES
 SCALE 1"=100 FT NOVEMBER 4, 1945
 THOMAS J. LEWIS CONSULTING ENGINEER
 FRACKVILLE PA.

George Hartman, Chief
 Schuylkill County Mining Section
 The State Capitol Bldg., Third Floor
 Harrisburg, PA. 17103

MAR 21 1977