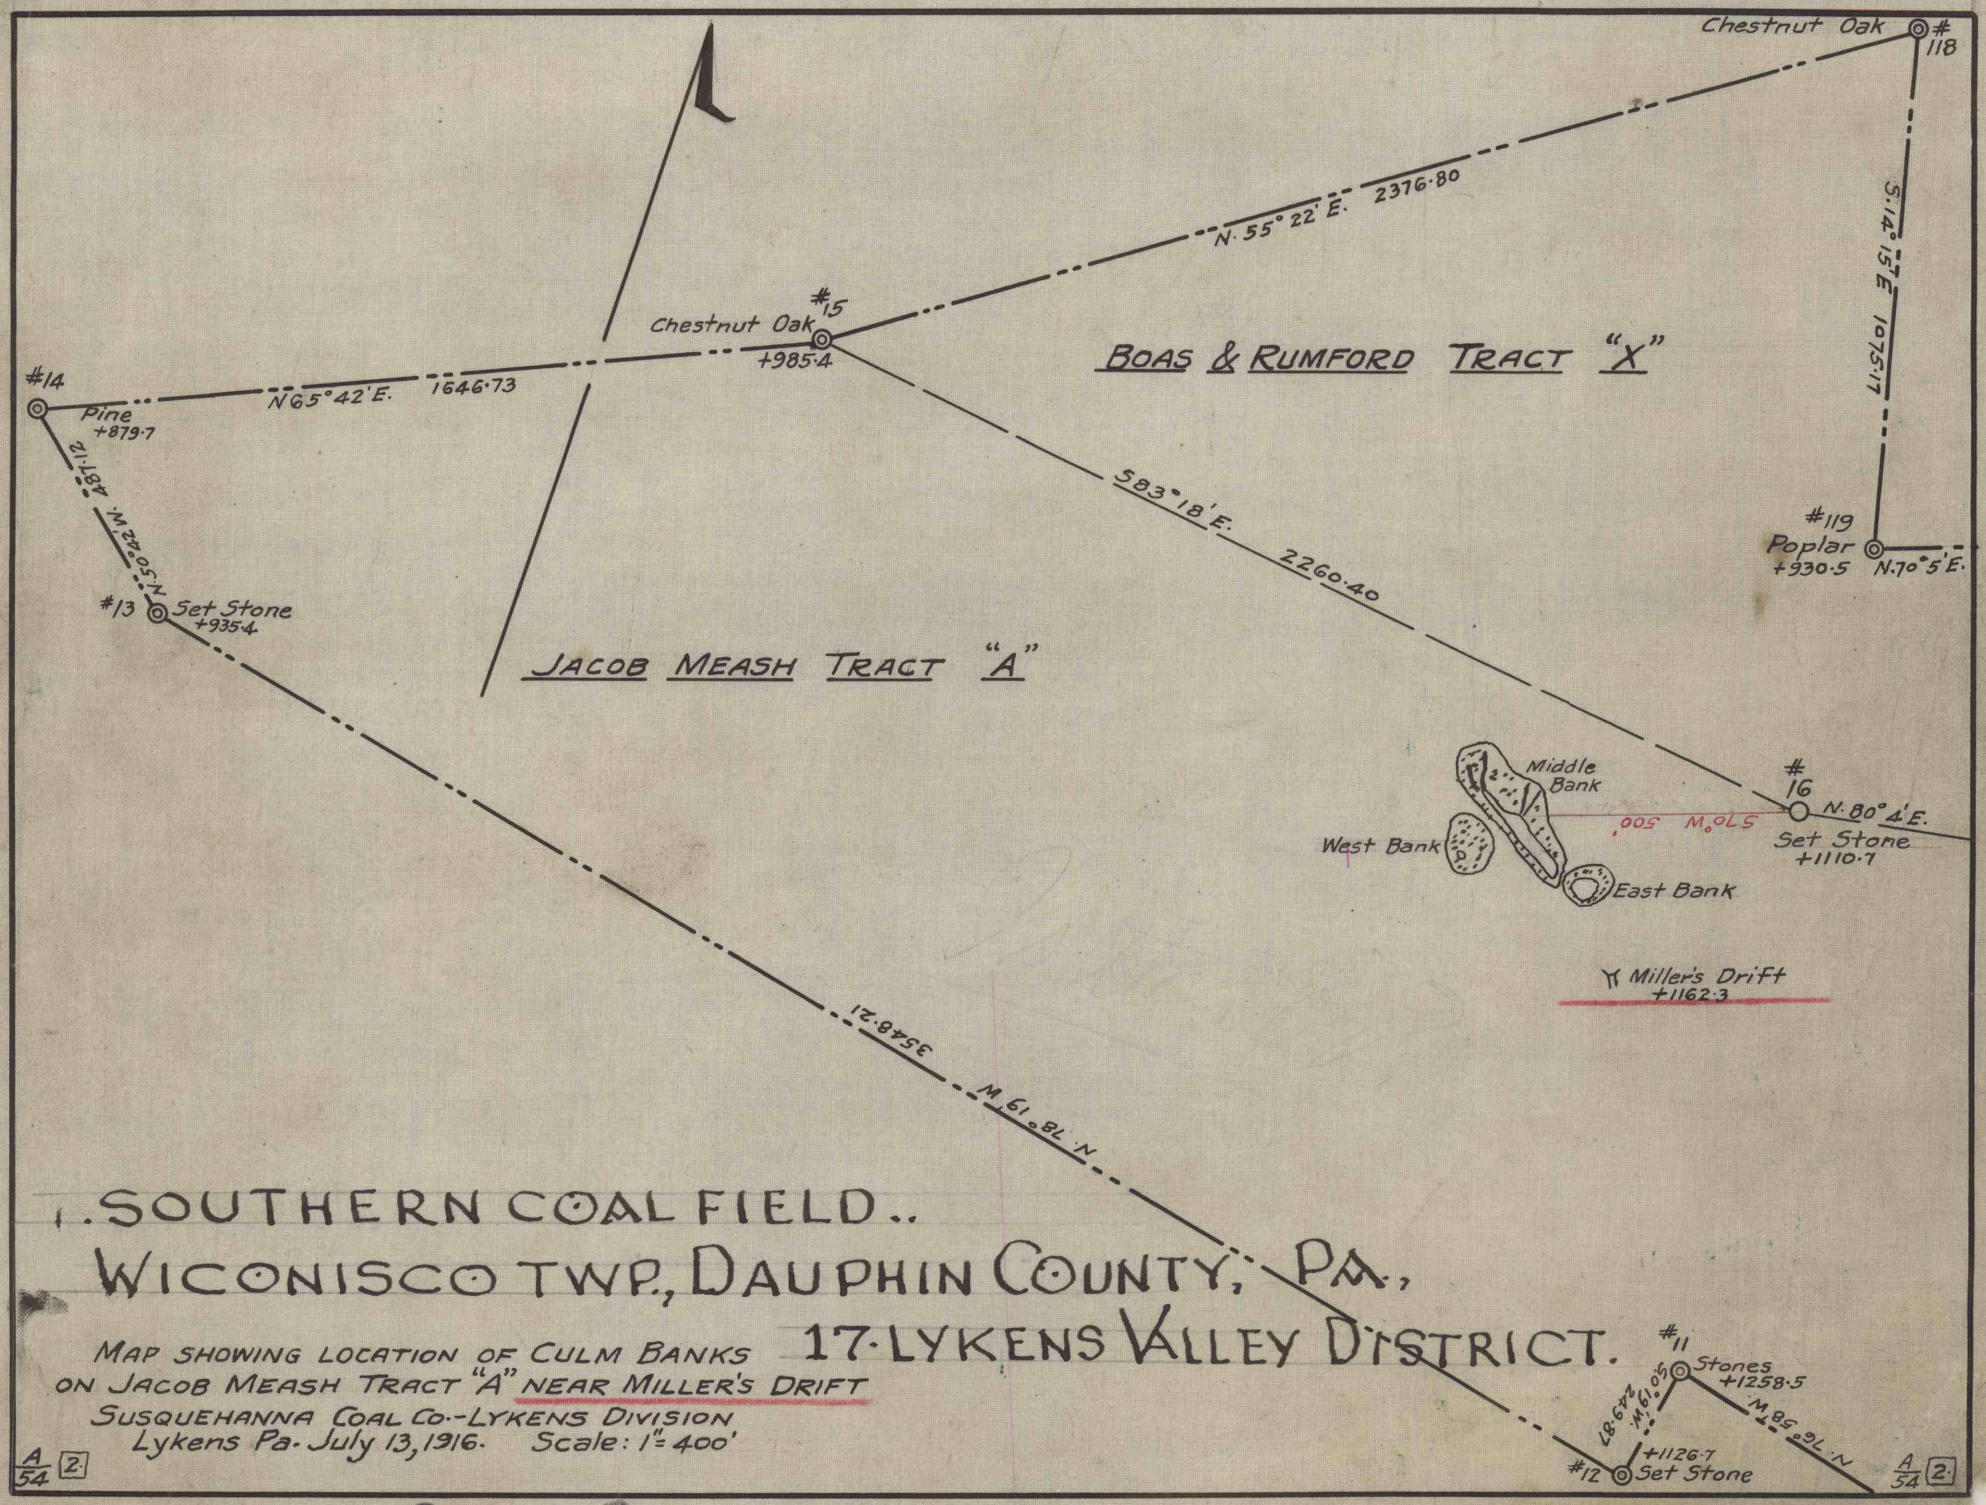

SOUTHERN COAL FIELD..

WICONISCO TWP., DAUPHIN COUNTY, PA.,

17. LYKENS VALLEY DISTRICT.

MAP SHOWING LOCATION OF CULM BANKS ON JACOB MEASH TRACT "A" NEAR MILLER'S DRIFT

SUSQUEHANNA COAL CO.-LYKENS DIVISION

Lykens Pa. July 13, 1916. Scale: 1" = 400'

A/54 2.

A/54 2.