


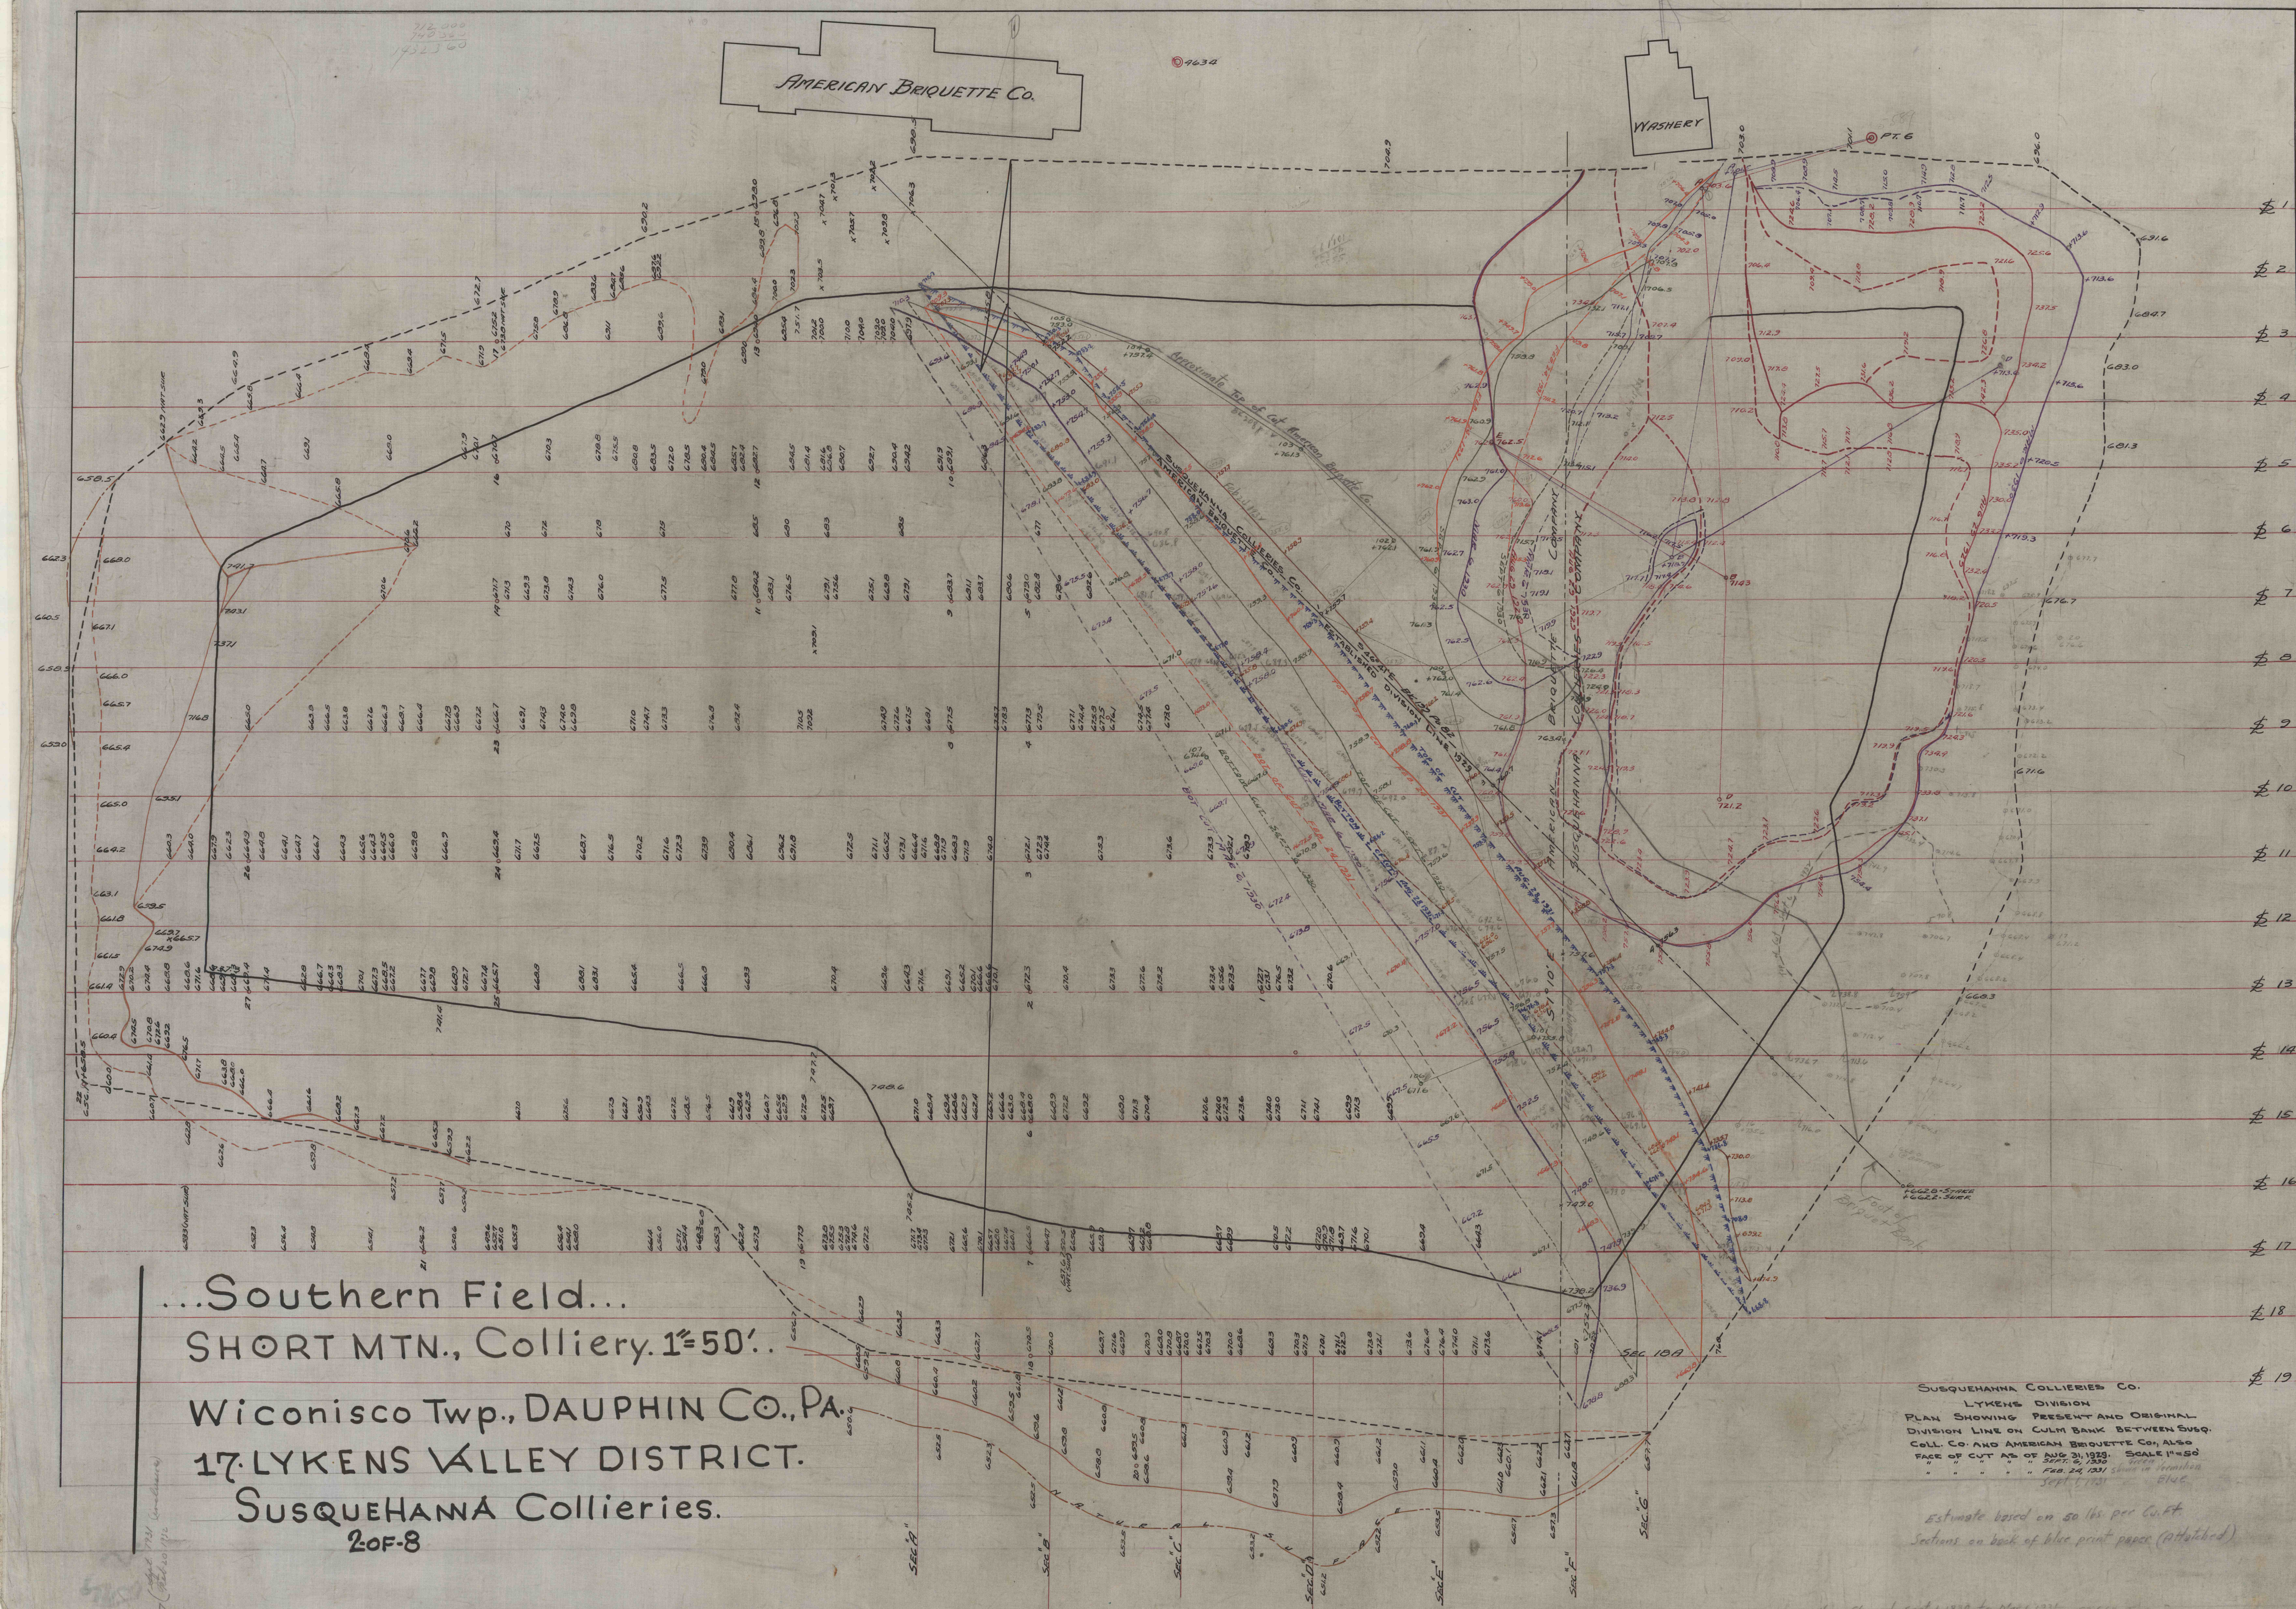

Sections on back of blue print paper (Attached)