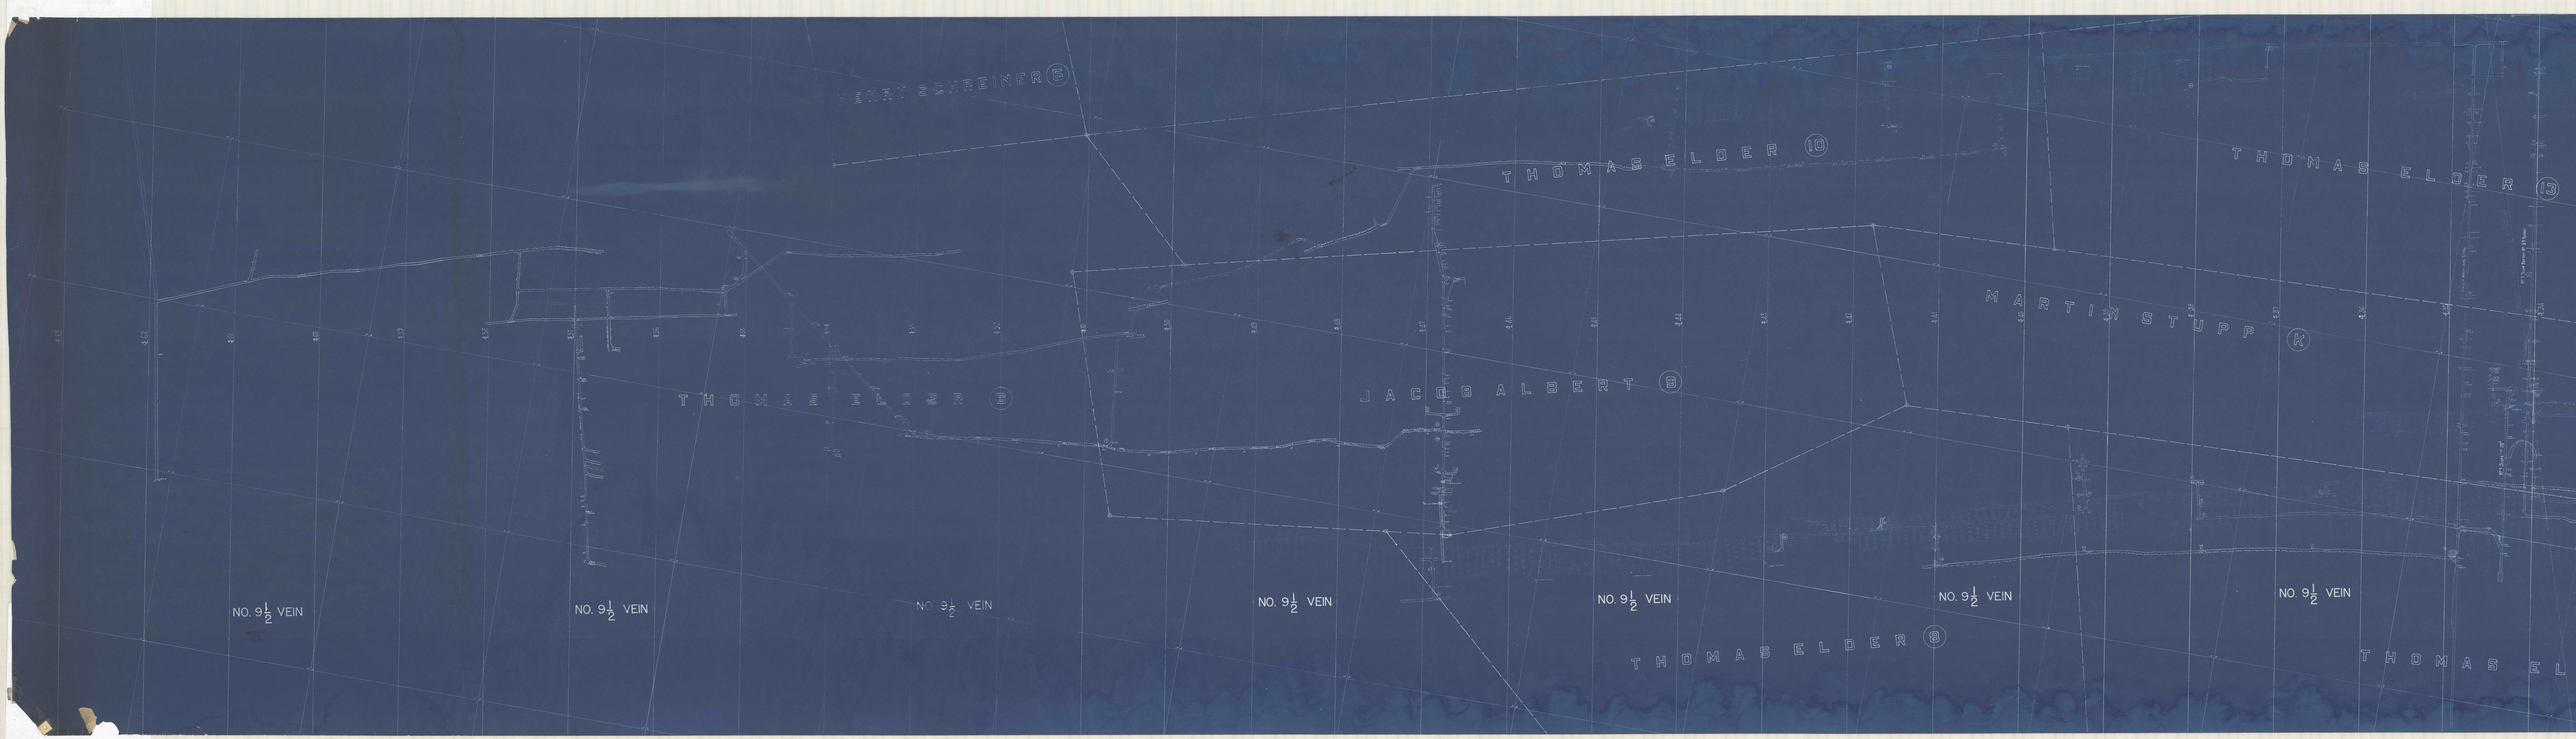

JENEY SCHREINER (5)
THOMAS ELDER (10)
THOMAS ELDER (13)
MARTIN STUPP (K)
THOMAS ELDER (8)
JACOB ALBERT (9)
THOMAS ELDER
NO. 9½ VEIN
NO. 9½ VEIN
NO. 9½ VEIN
NO. 9½ VEIN
NO. 9½ VEIN
NO. 9½ VEIN
NO. 9½ VEIN
THOMAS EL