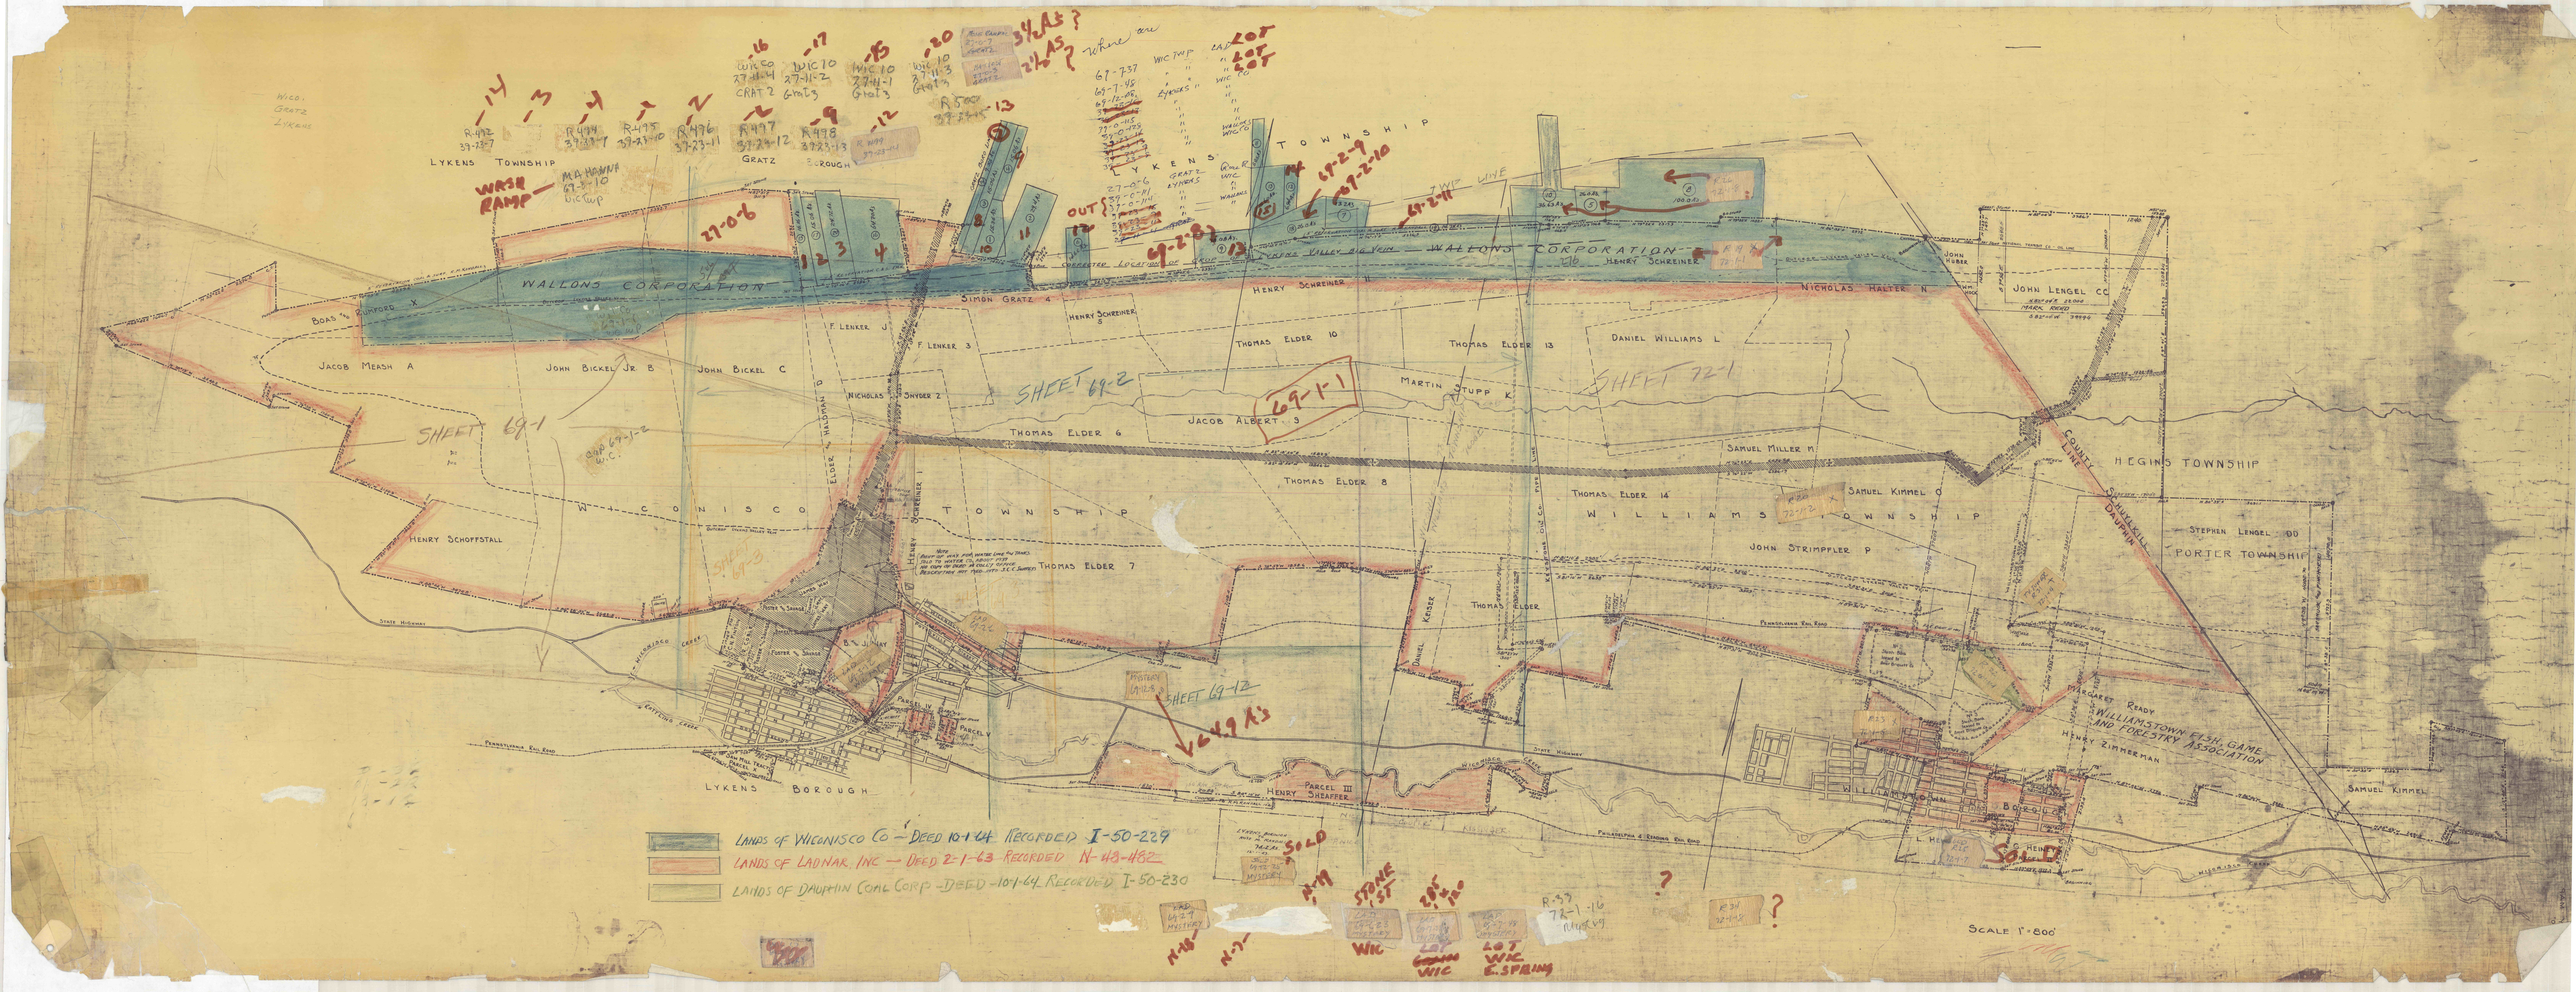

WICO.
GRATZ
LYKENS
-14
-13
-7
-7
-2
-6
-9
-12
-16
-17
-15
-20
R-492
39-23-7
R494
39-23-7
R-495
39-23-10
R496
39-23-11
R497
39-23-12
R498
39-23-13
R 499
39-23-14
WICO
27-11-4
GRAT 2
WIC 10
27-11-2
Gratz 3
WIC 10
27-11-1
Gratz 3
WIC 10
27-11-3
Gratz 3
R 500
39-23-15
13
ROSE RANDAL
27-0-7
GRATZ
HANYOST
27-0-3
GRATZ
3½ A's ?
2½ A's ?
Where are
69-7-37
69-7-48
69-12-8
~~39-23-16~~
~~39-23-12~~
39-0-115
39-0-128
~~39-23-14~~
~~39-23-13~~
~~39-23-9~~
~~39-23-8~~
WIC TWP
LYKENS
WIC CO
WALLONS
WIC CO
LOT
LOT
LOT
27-0-6
39-0-111
39-0-114
~~39-23-15~~
~~39-23-9~~
~~39-23-11~~
~~27-11-4~~
OUT
GRATZ
LYKENS
WIC
WALLONS
LYKENS TOWNSHIP
GRATZ BOROUGH
WASH RAMP
MAHANNA
69-3-10
WIC TWP
27-0-6
1
2
3
4
8
9
10
11
12
13
14
15
69-2-8
69-2-9
69-2-10
69-2-11
TWP LINE
R 24
72-1-8
R 19
72-1-1
16.16 A's
15.06 A's
24.72 A's
64.70 A's
9.58 A's
15.06 A's
15.36 A's
29.4 A's
14.65 A's
78.0 A's
26.0 A's
13.2 A's
5.85 A's
6.9 A's
11.75 A's
36.63 A's
26.0 A's
100.0 A's
GRATZ BORO LINE
WALLONS CORPORATION
5' RESERVATION COAL & SURF. R. M. KANDALL
OUTCROP LYKENS VALLEY VEIN
CORRECTED LOCATION OF CROP OF LYKENS VALLEY BIG VEIN
BOAS AND RUMFORD X
WICO 69-1-1 WC TWP
JACOB MEASH A
JOHN BICKEL JR. B
JOHN BICKEL C
ELDER AND HALDMAN D
F. LENKER J
F. LENKER 3
SIMON GRATZ 4
HENRY SCHREINER 5
HENRY SCHREINER 11
NICHOLAS SNYDER 2
THOMAS ELDER 10
THOMAS ELDER 13
THOMAS ELDER 6
THOMAS ELDER 8
THOMAS ELDER 7
THOMAS ELDER 14
THOMAS ELDER
JACOB ALBERT 9
MARTIN STUPP K
DANIEL WILLIAMS L
SAMUEL MILLER M
SAMUEL KIMMEL O
NICHOLAS HALTER N
JOHN HUBER
WM. HOCK
JOHN LENGEL CC
MARK REED
NATIONAL TRANSIT CO. - OIL LINE
Private Road
SHEET 69-1
SHEET 69-2
SHEET 72-1
SHEET 69-3
SHEET 69-12
69-1-1
69-1-2 W.C.
WICONISCO TOWNSHIP
WILLIAMS TOWNSHIP
WICONISCO / WILLIAMS TOWNSHIP
HEGINS TOWNSHIP
PORTER TOWNSHIP
COUNTY LINE
SCHUYLKILL
DAUPHIN
HENRY SCHOFFSTALL
JOHN STRIMPFLER P
STEPHEN LENGEL DD
SAUSHOCK AND PINKHOSKI
R 20 X
72-1-2
T.V. TOWER
R 31
72-1-4
KEYSTONE OIL CO. PIPE LINE
DANIEL KEISER
STATE HIGHWAY
WICONISCO CREEK
RATTLING CREEK
PENNSYLVANIA RAIL ROAD
PHILADELPHIA & READING RAIL ROAD
Note
Right of way for water line and tanks
sold to water co. about 1939
No copy of deed in coll'y office
Description not tied into S.C.C. Surveys
C.N. FINTON
R. COBLE
FOSTER AND SAVAGE
JAMES WAY
ZIGNER
BARRETT
B. AND J. WAY
LAD
69-3-12
WIC NAT
LAD
69-2-6
MYSTERY
69-12-8
PARCEL IV
PARCEL V
SAW MILL TRACT
PARCEL X
MAIN STREET
SOUTH SECOND ST.
POTTSVILLE STREET
WALNUT ST.
CENTRE ST.
OAK ST.
WICONISCO
LYKENS BOROUGH
64.9 A's
PARCEL III
HENRY SHEAFFER
COOPER TO R.M. RANDALL
NICE
COOPER
KISSINGER
RAMSEY
LYKENS BOROUGH TO ROSE M. RANDALL 74.2 As. 12-1-47
SOLD
SOLD
69-12-25
MYSTERY
LAD
69-2-9
MYSTERY
N-18
N-7
N-19
STONE 1ST
WIC
LAD
69-6-23
MYSTERY
28 & 120
LAD
69-7-37
MYSTERY
LOT
WIC
LAD
69-7-48
MYSTERY
LOT
WIC
E. SPRING
R-33
72-1-16
Mystery
?
R 34
72-1-8
?
Pennsylvania Rail Road
No 2 Slush Bank leased to Amer Briquett Co
No 3 Slush Bank leased to Amer Briquett Co.
R 22
72-1-4
WILLIAMSTOWN TUNNEL
WILLIAMSTOWN BREAKER
R 23 X
72-1-5
MARGARET READY
WILLIAMSTOWN FISH, GAME AND FORESTRY ASSOCIATION
HENRY ZIMMERMAN
SAMUEL KIMMEL
WILLIAMSTOWN BOROUGH
L. HEISOLD
R 25
72-1-7
G. HEINEY
PARCEL II
SOLD
R-33
81-22
18-14

🟦 LANDS OF WICONISCO CO — DEED 10-1-64 RECORDED I-50-229

🟥 LANDS OF LADNAR, INC — DEED 2-1-63 RECORDED N-48-482

🟨 LANDS OF DAUPHIN COAL CORP - DEED 10-1-64 RECORDED I-50-230

SCALE 1" = 800'