



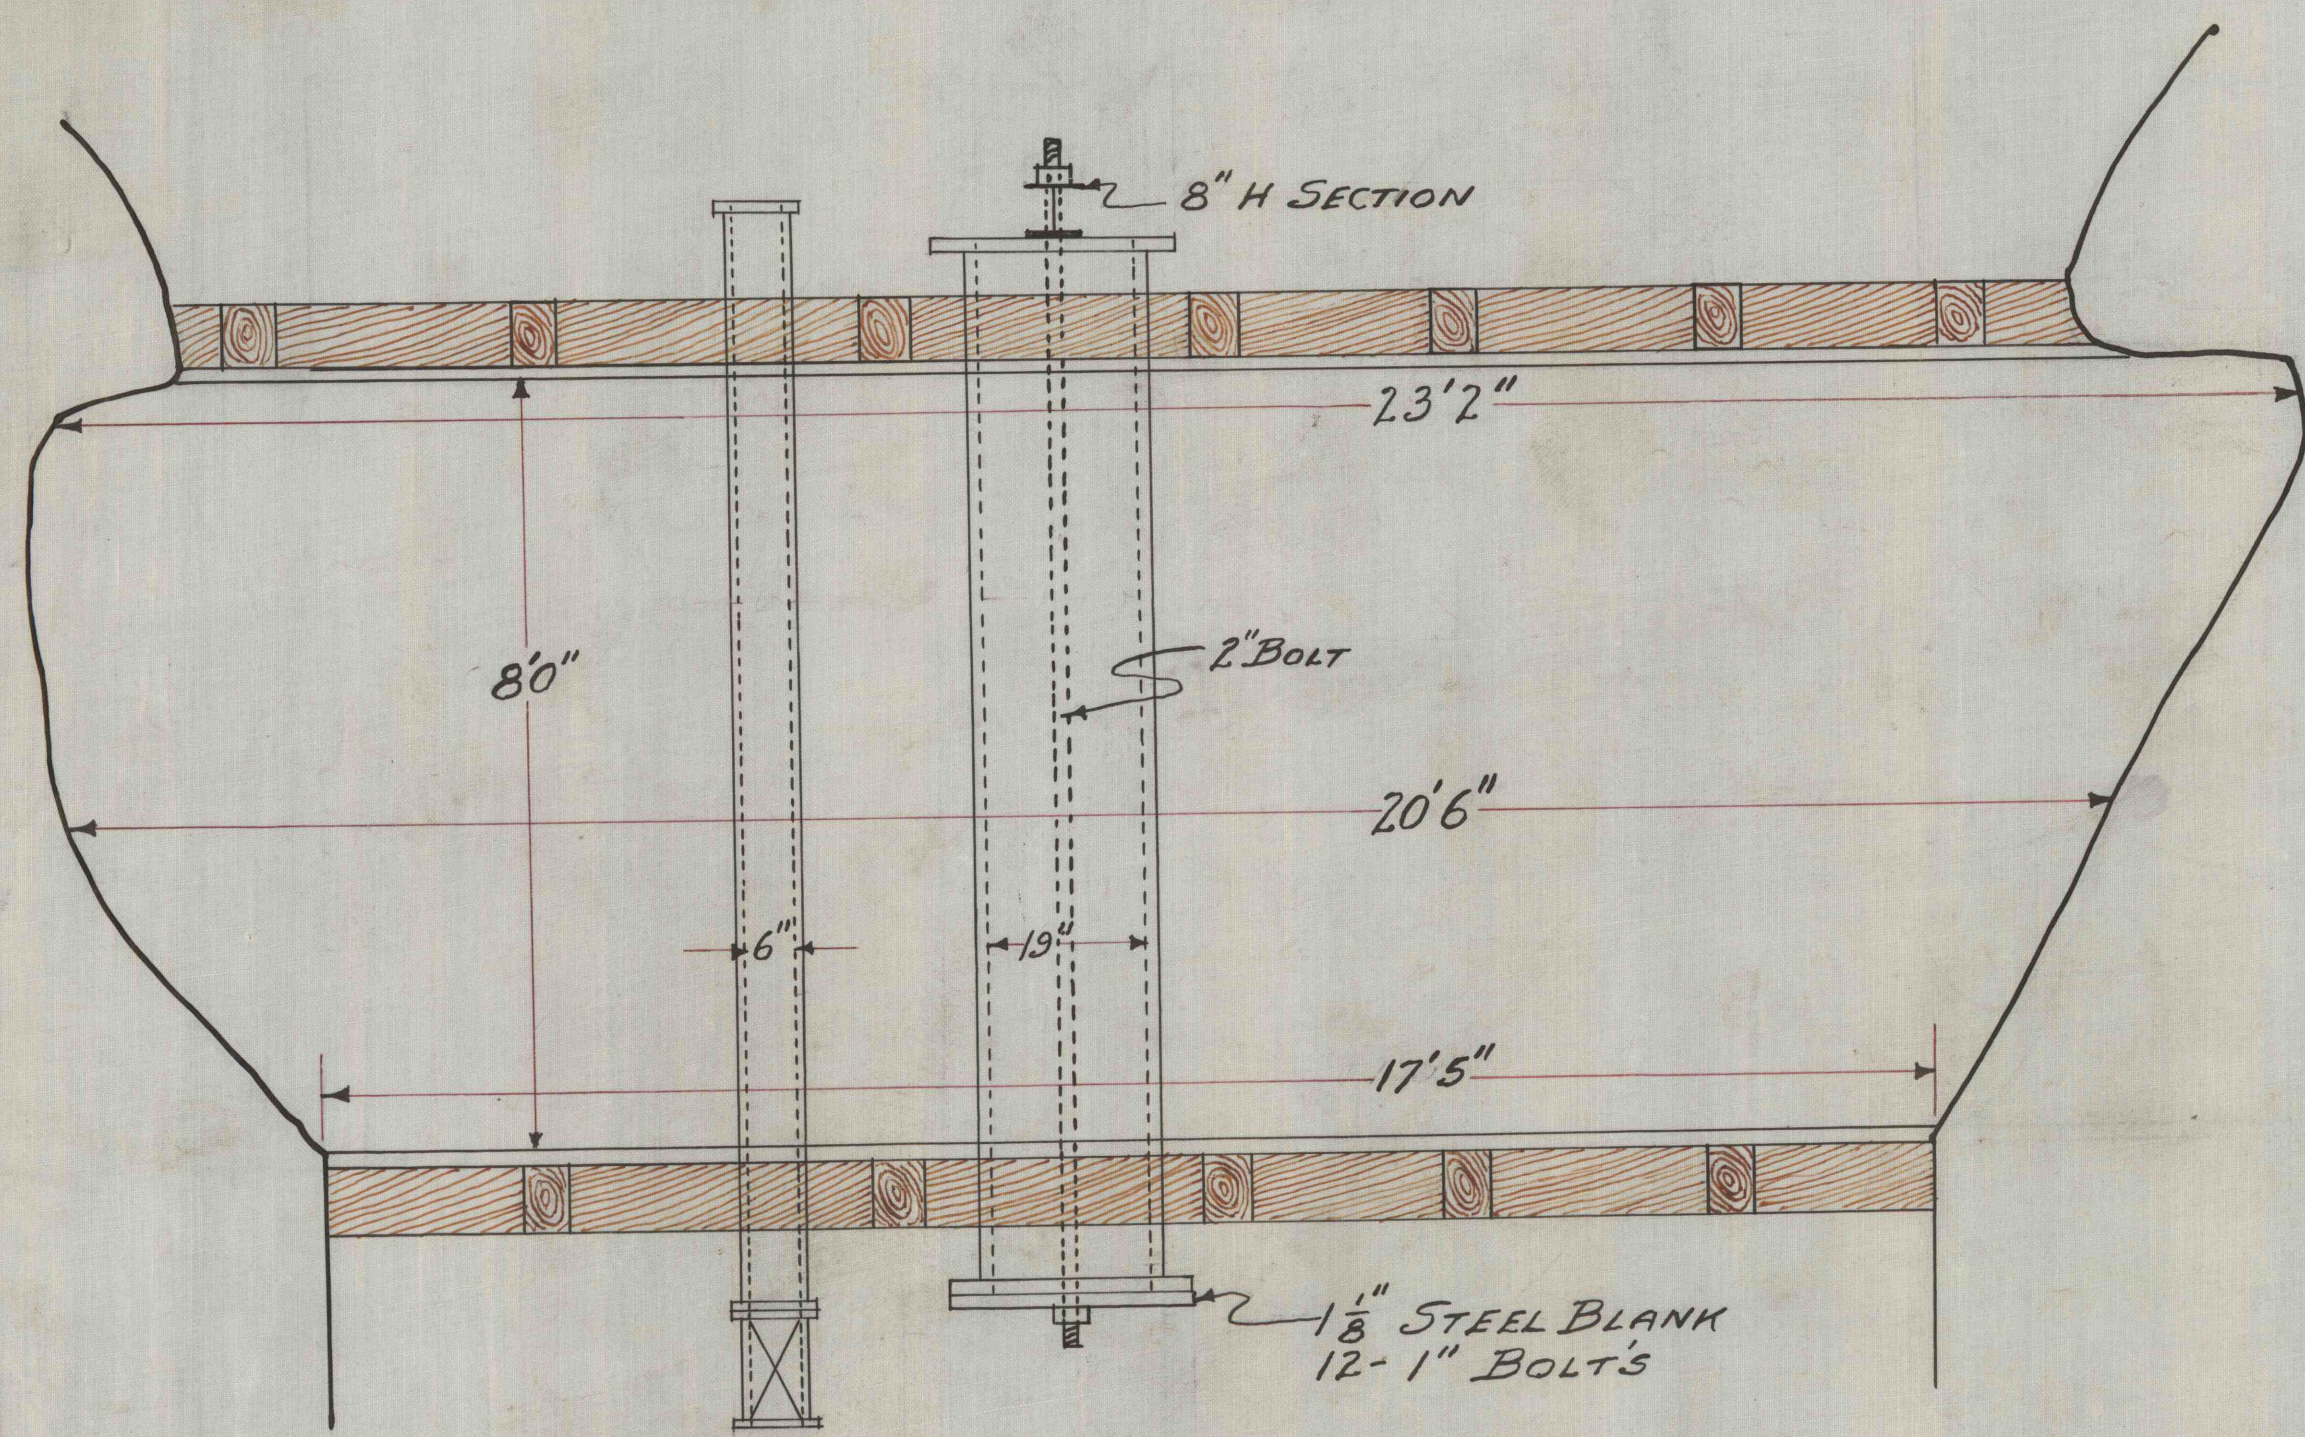


PLAN

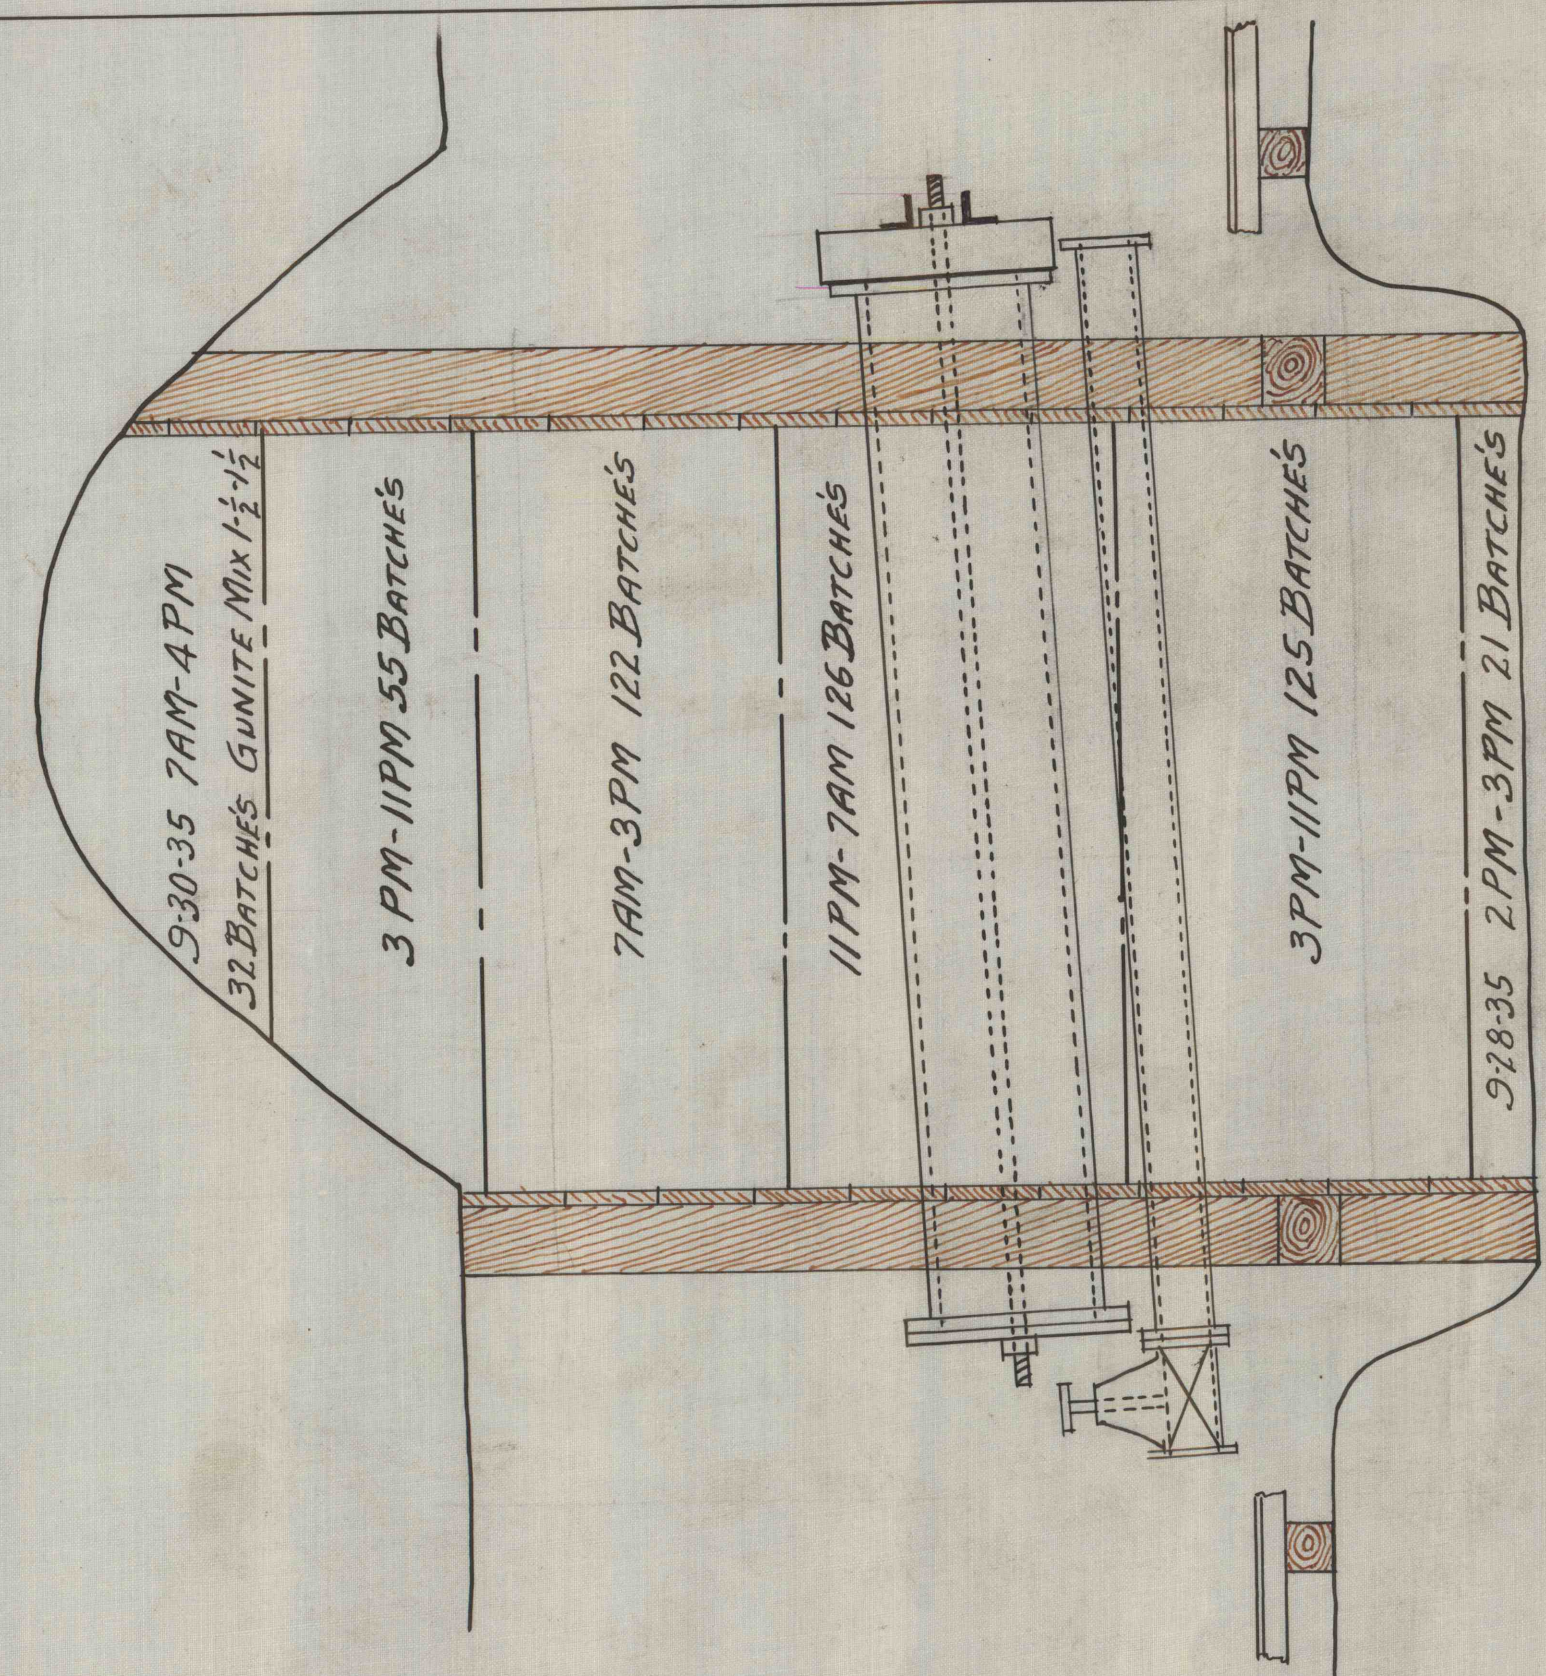

PROFILE LOOKING EAST

CONTENTS OF DAM 1880 CU FT
 MIX 1-2-4 6 GAL'S WATER
 481 BAG'S INCOR CEMENT (QUICK SETTING)
 930 CU FT SAND
 1800 CU FT 1" STONE
 50 CU FT CRACKER DUST

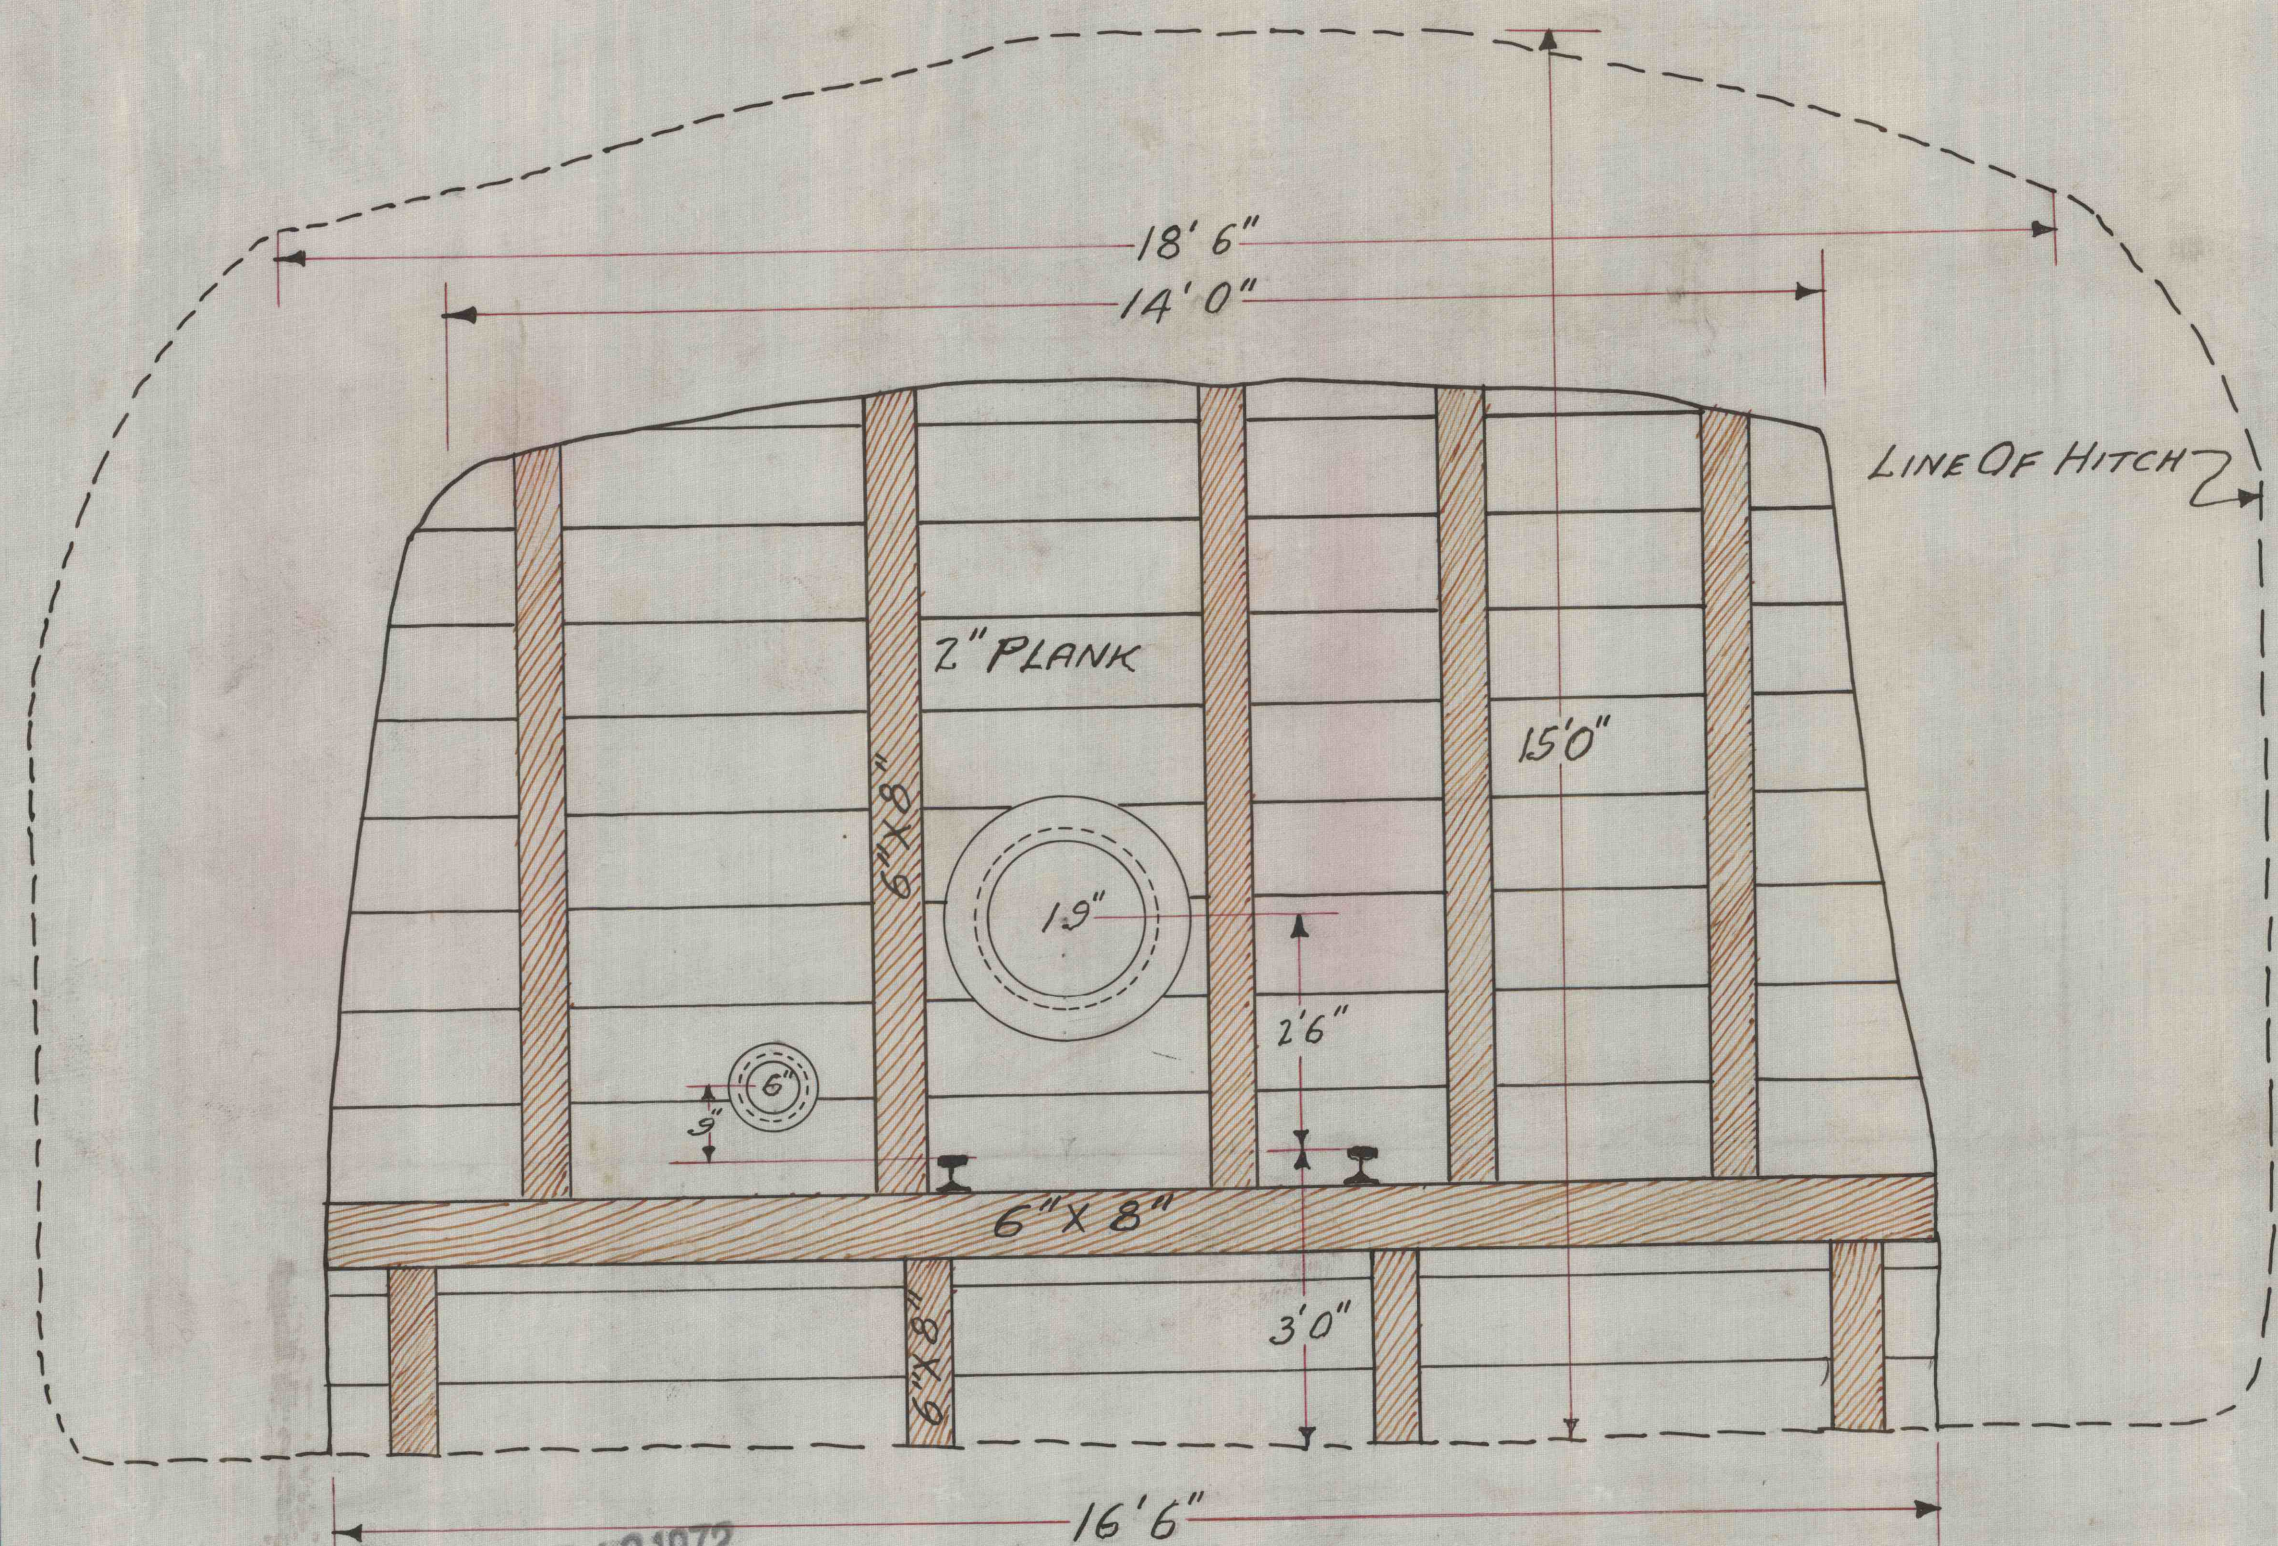

PROFILE LOOKING SOUTH

WILLIAMSTOWN COLLIERY
 PLAN AND PROFILE OF FIRE DAM
 NO 10 SLOPE NO 1 LEVEL SOUTH TUNNEL
 SEPT 19-1935 SCALE 1/2" = 12"

MF MAR 10 1972

Williamstown Colliery: 200 THESS FIELD