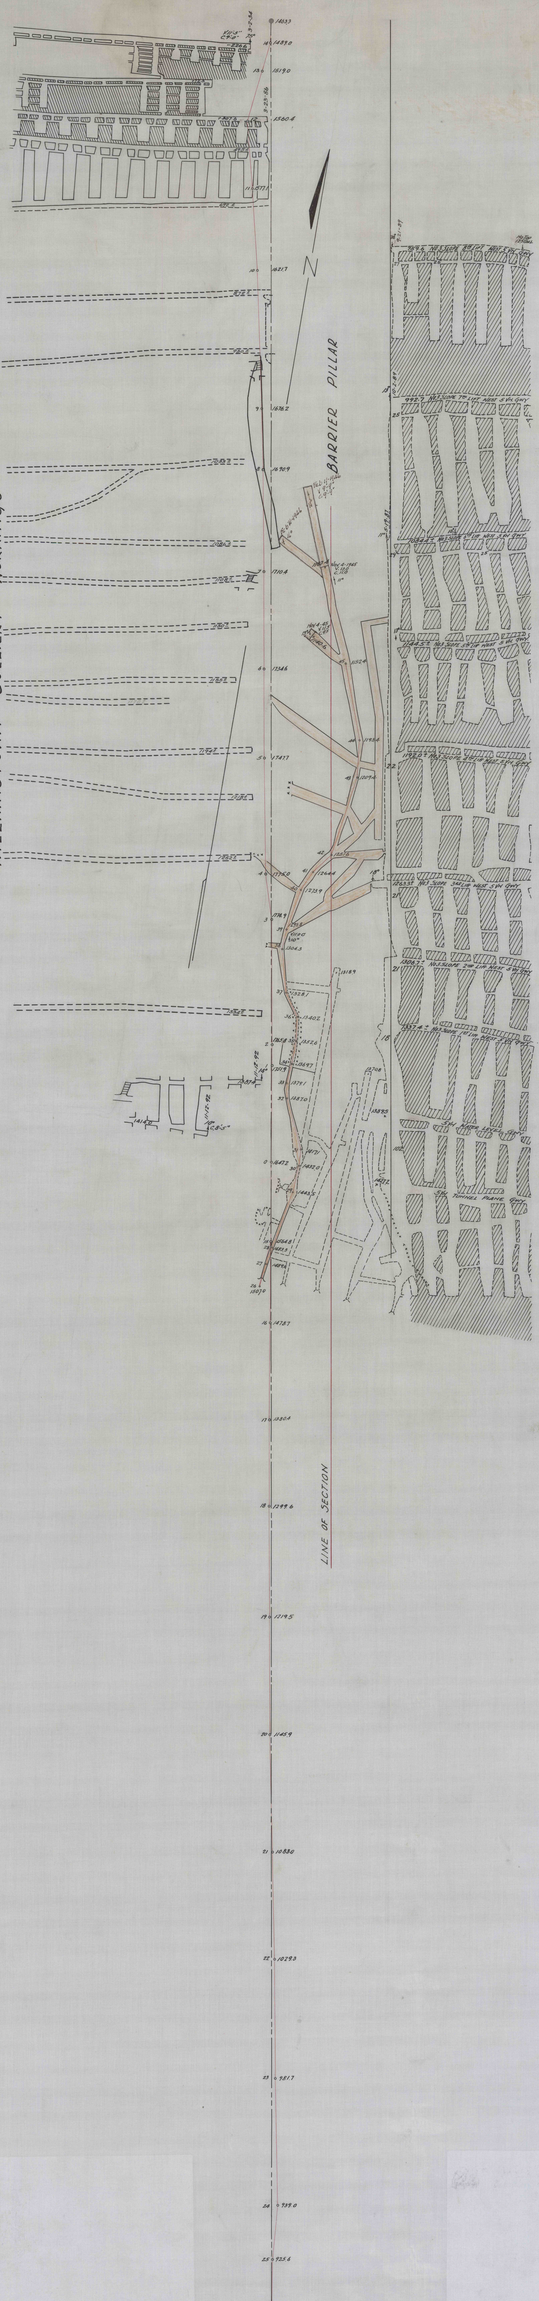

...SOUTHERN COAL FIELD...

WICONISCO TOWNSHIP... MAP SHOWING MINE WORKINGS IN LYKENS VALLEY No 5 VEIN IN BARRIER PILLAR BETWEEN WILLIAMSTOWN AND BROOKSIDE COLLIERIES

DAUPHIN COUNTY PA.,

17. Lykens Valley DIST.,

SUSQUEHANNA Collieries.

SCALE 1" = 100 FT.

THOMAS J. LEWIS, CONSULTING ENGINEER

FRACKVILLE PA

NOVEMBER 4-1945

ISKANDER.

MF 2870 I NYM MB 16077