

CAROUSEY SUPPLY SHAFT
CAROUSEY MAIN SHAFT


PENN ANTH. COAL CO.

BROWN

NASSAU

PENN ANTH. COAL CO.

LATON LEACH

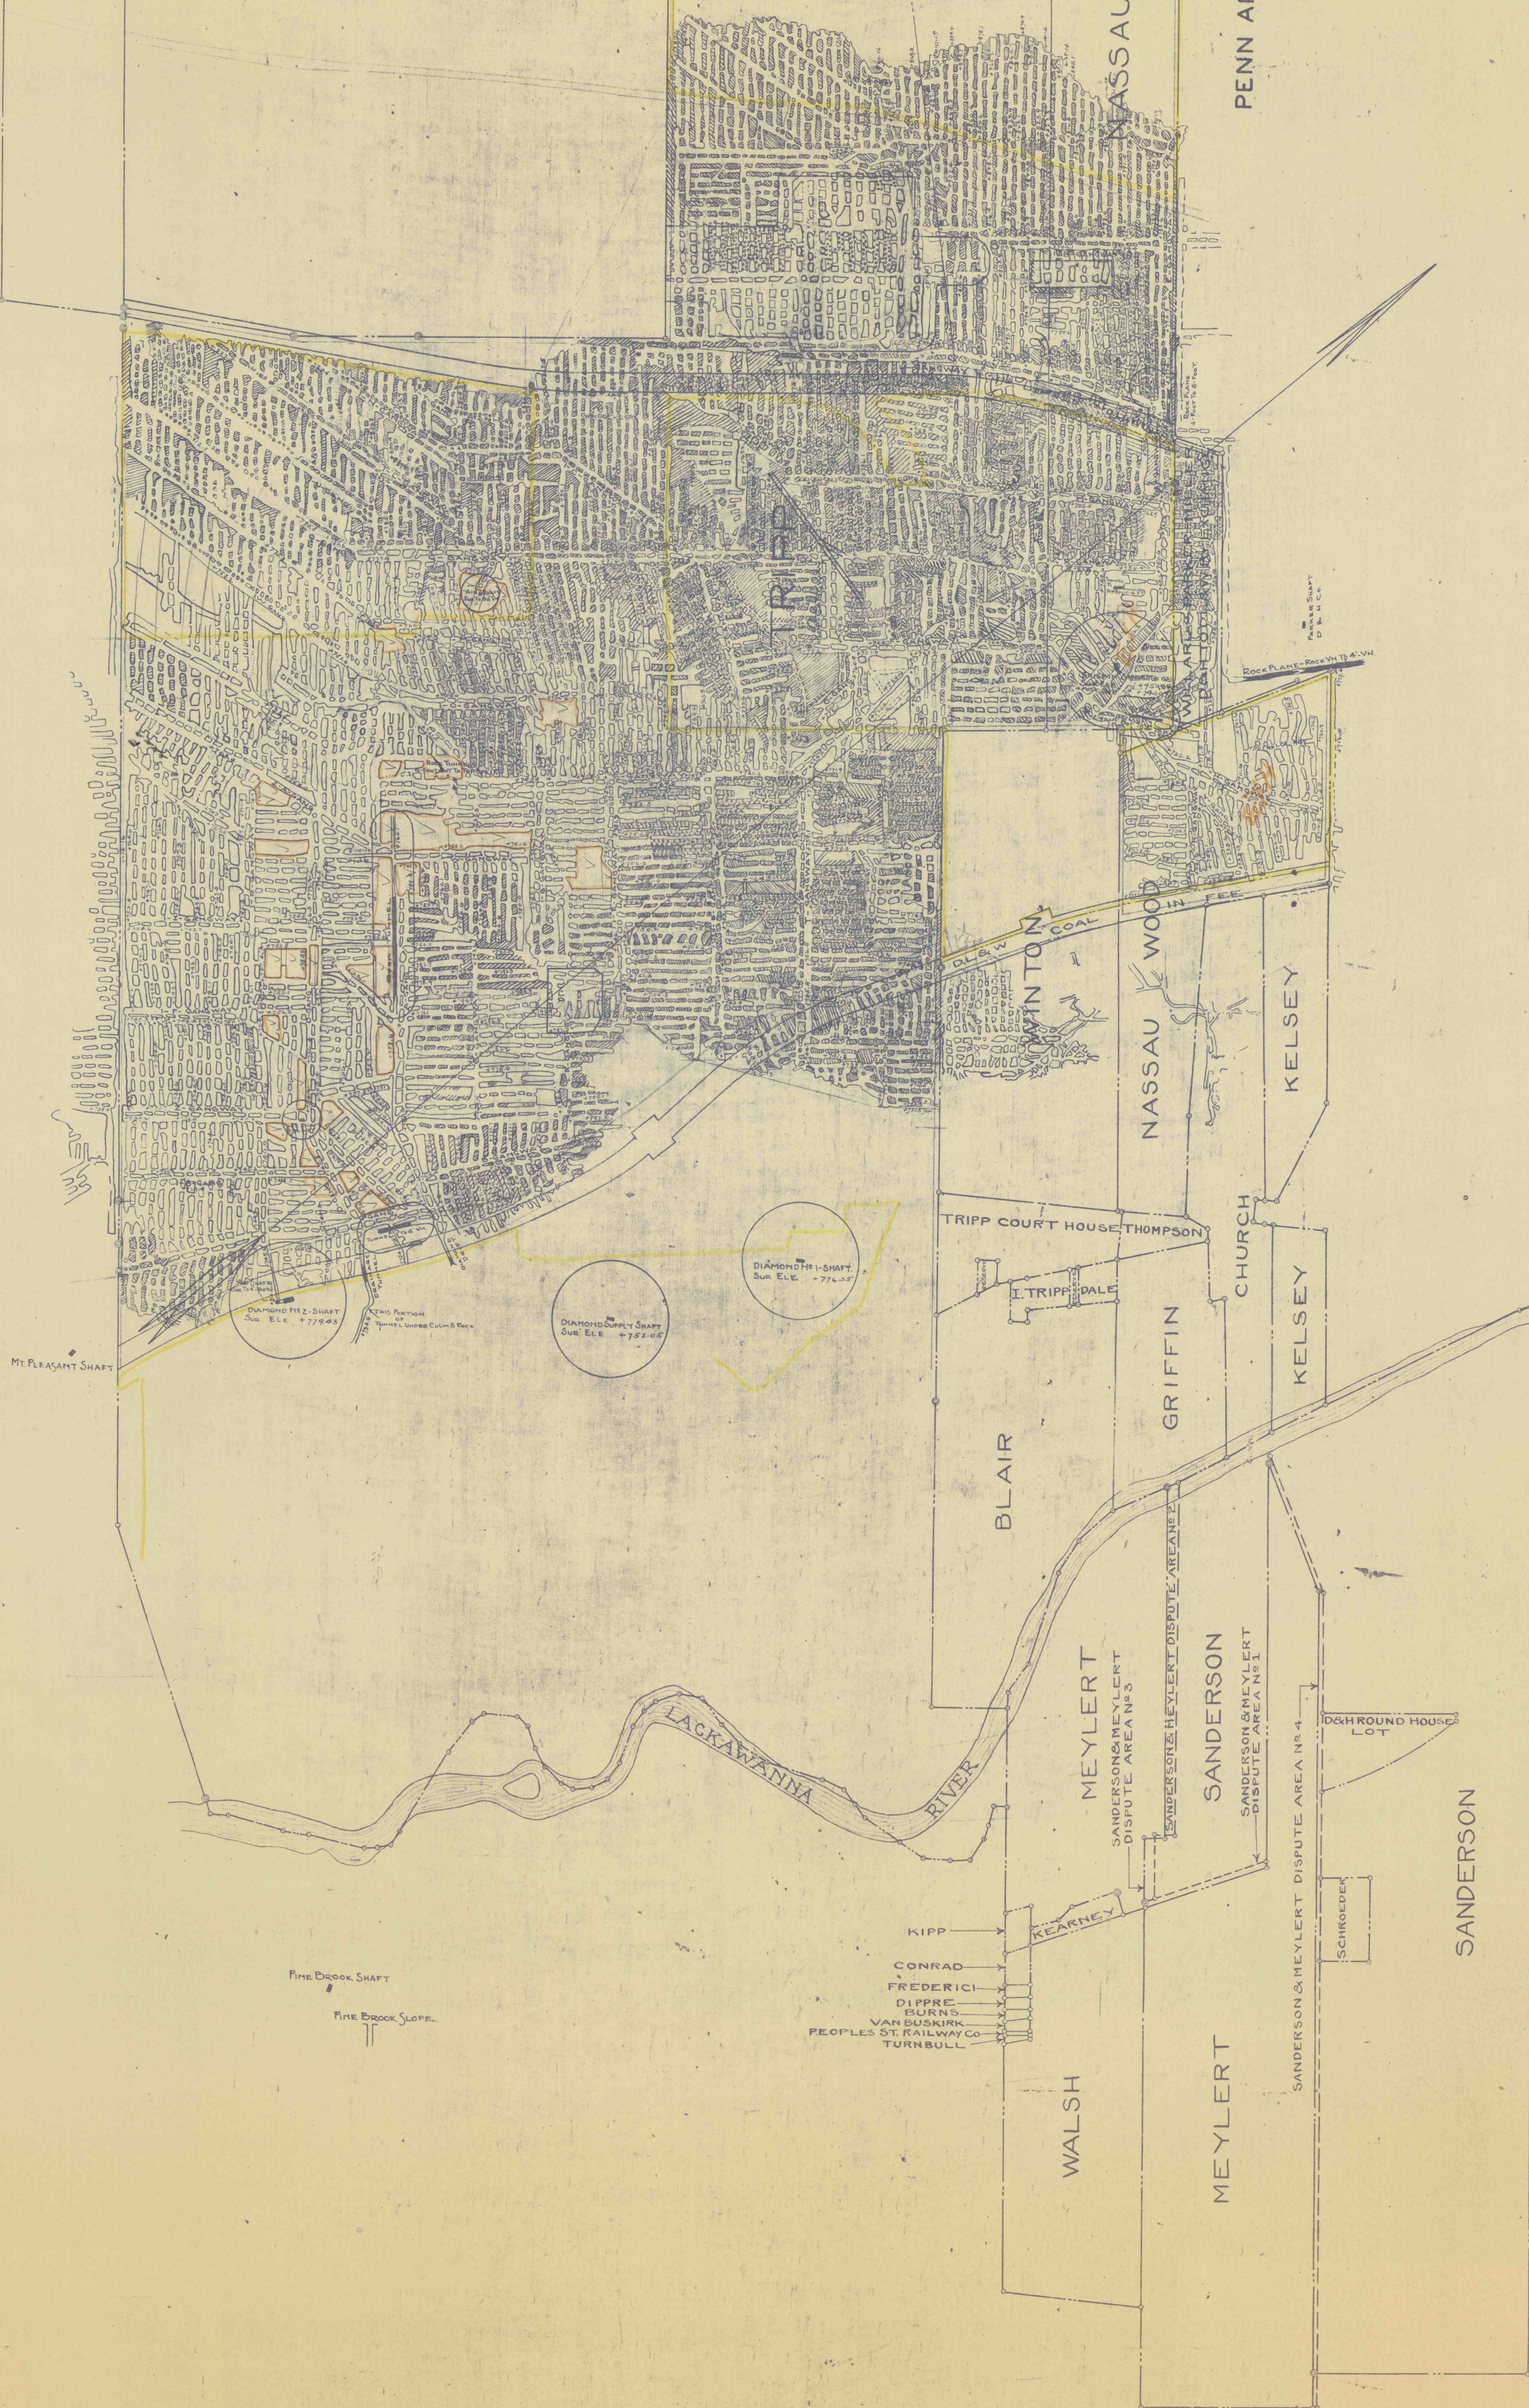

BRISBIN-DIAMOND-MANVILLE
4-FOOT VEIN — BOTTOM SPLIT
SCALE 1" = 400'

BRISBIN-DIAMOND-MANVILLE
4-FOOT VEIN — BOTTOM SPLIT
SCALE 1" = 400'