


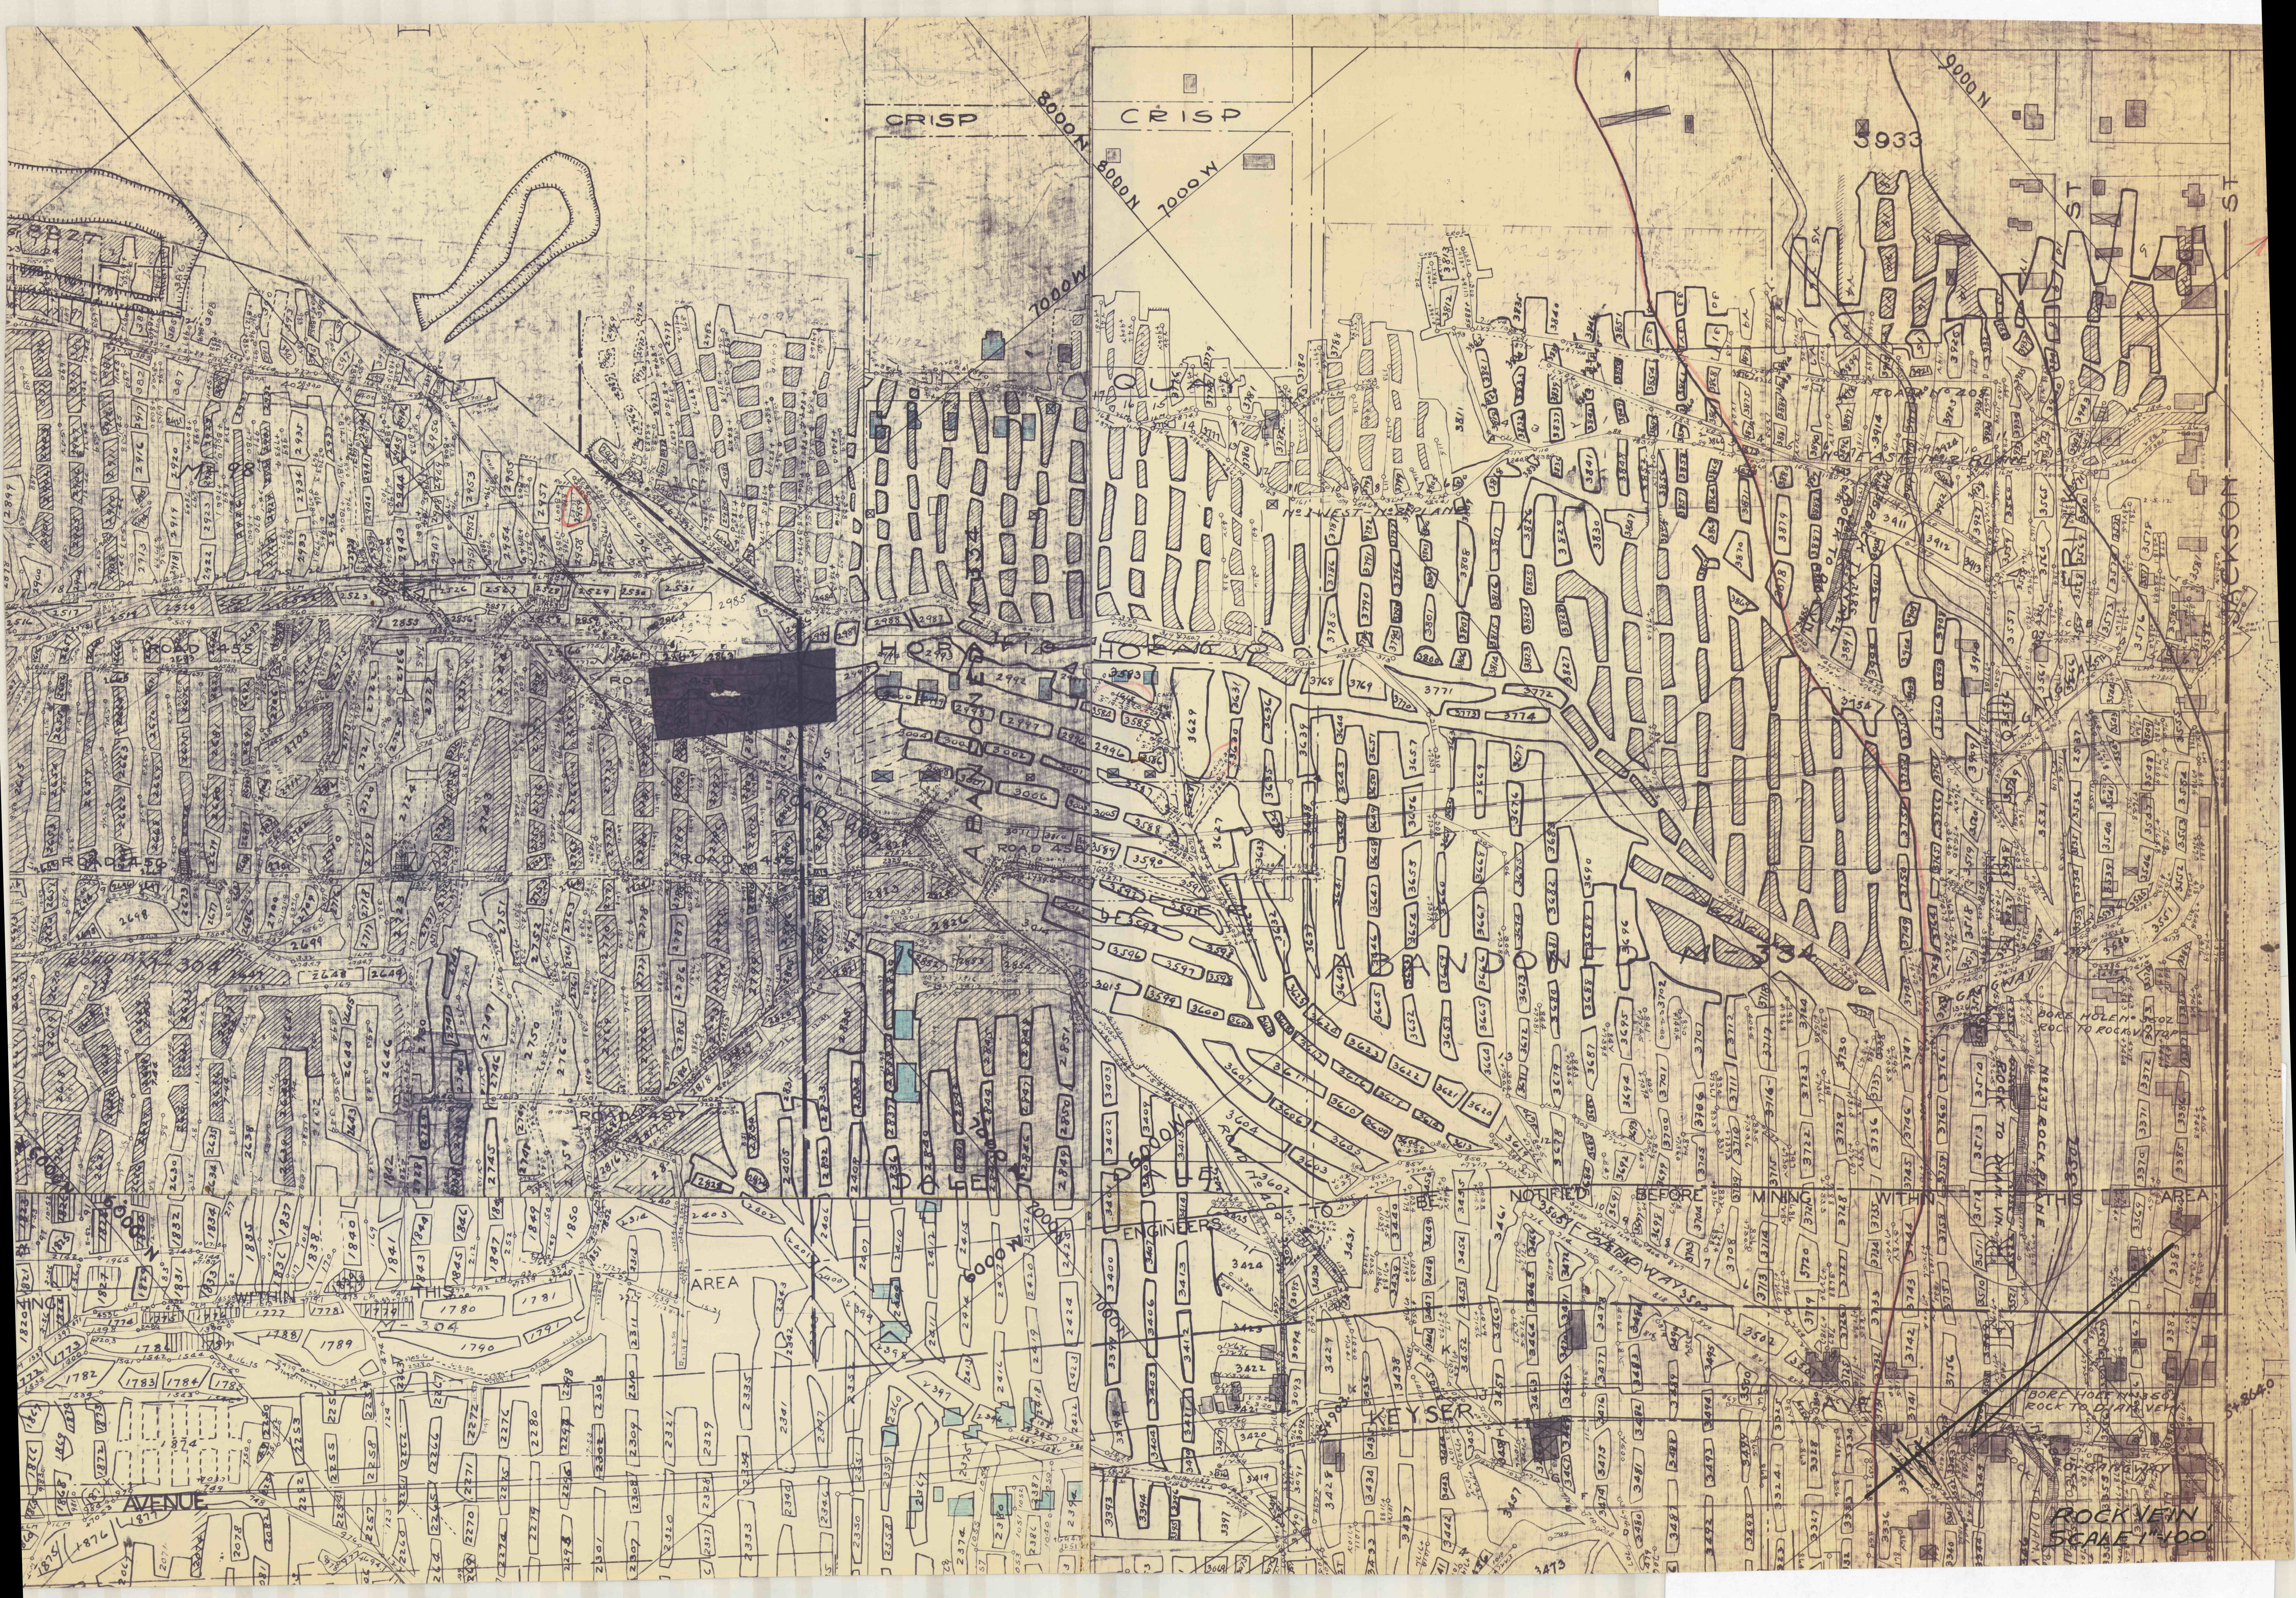

CRISP

CRISP

7000 W

8000 N

7000 W

5933

ST

JACKSON

ST

AREA

AREA

ROCK VEIN  
SCALE 1" = 100'