


W. 315 W
50-50

VEIN

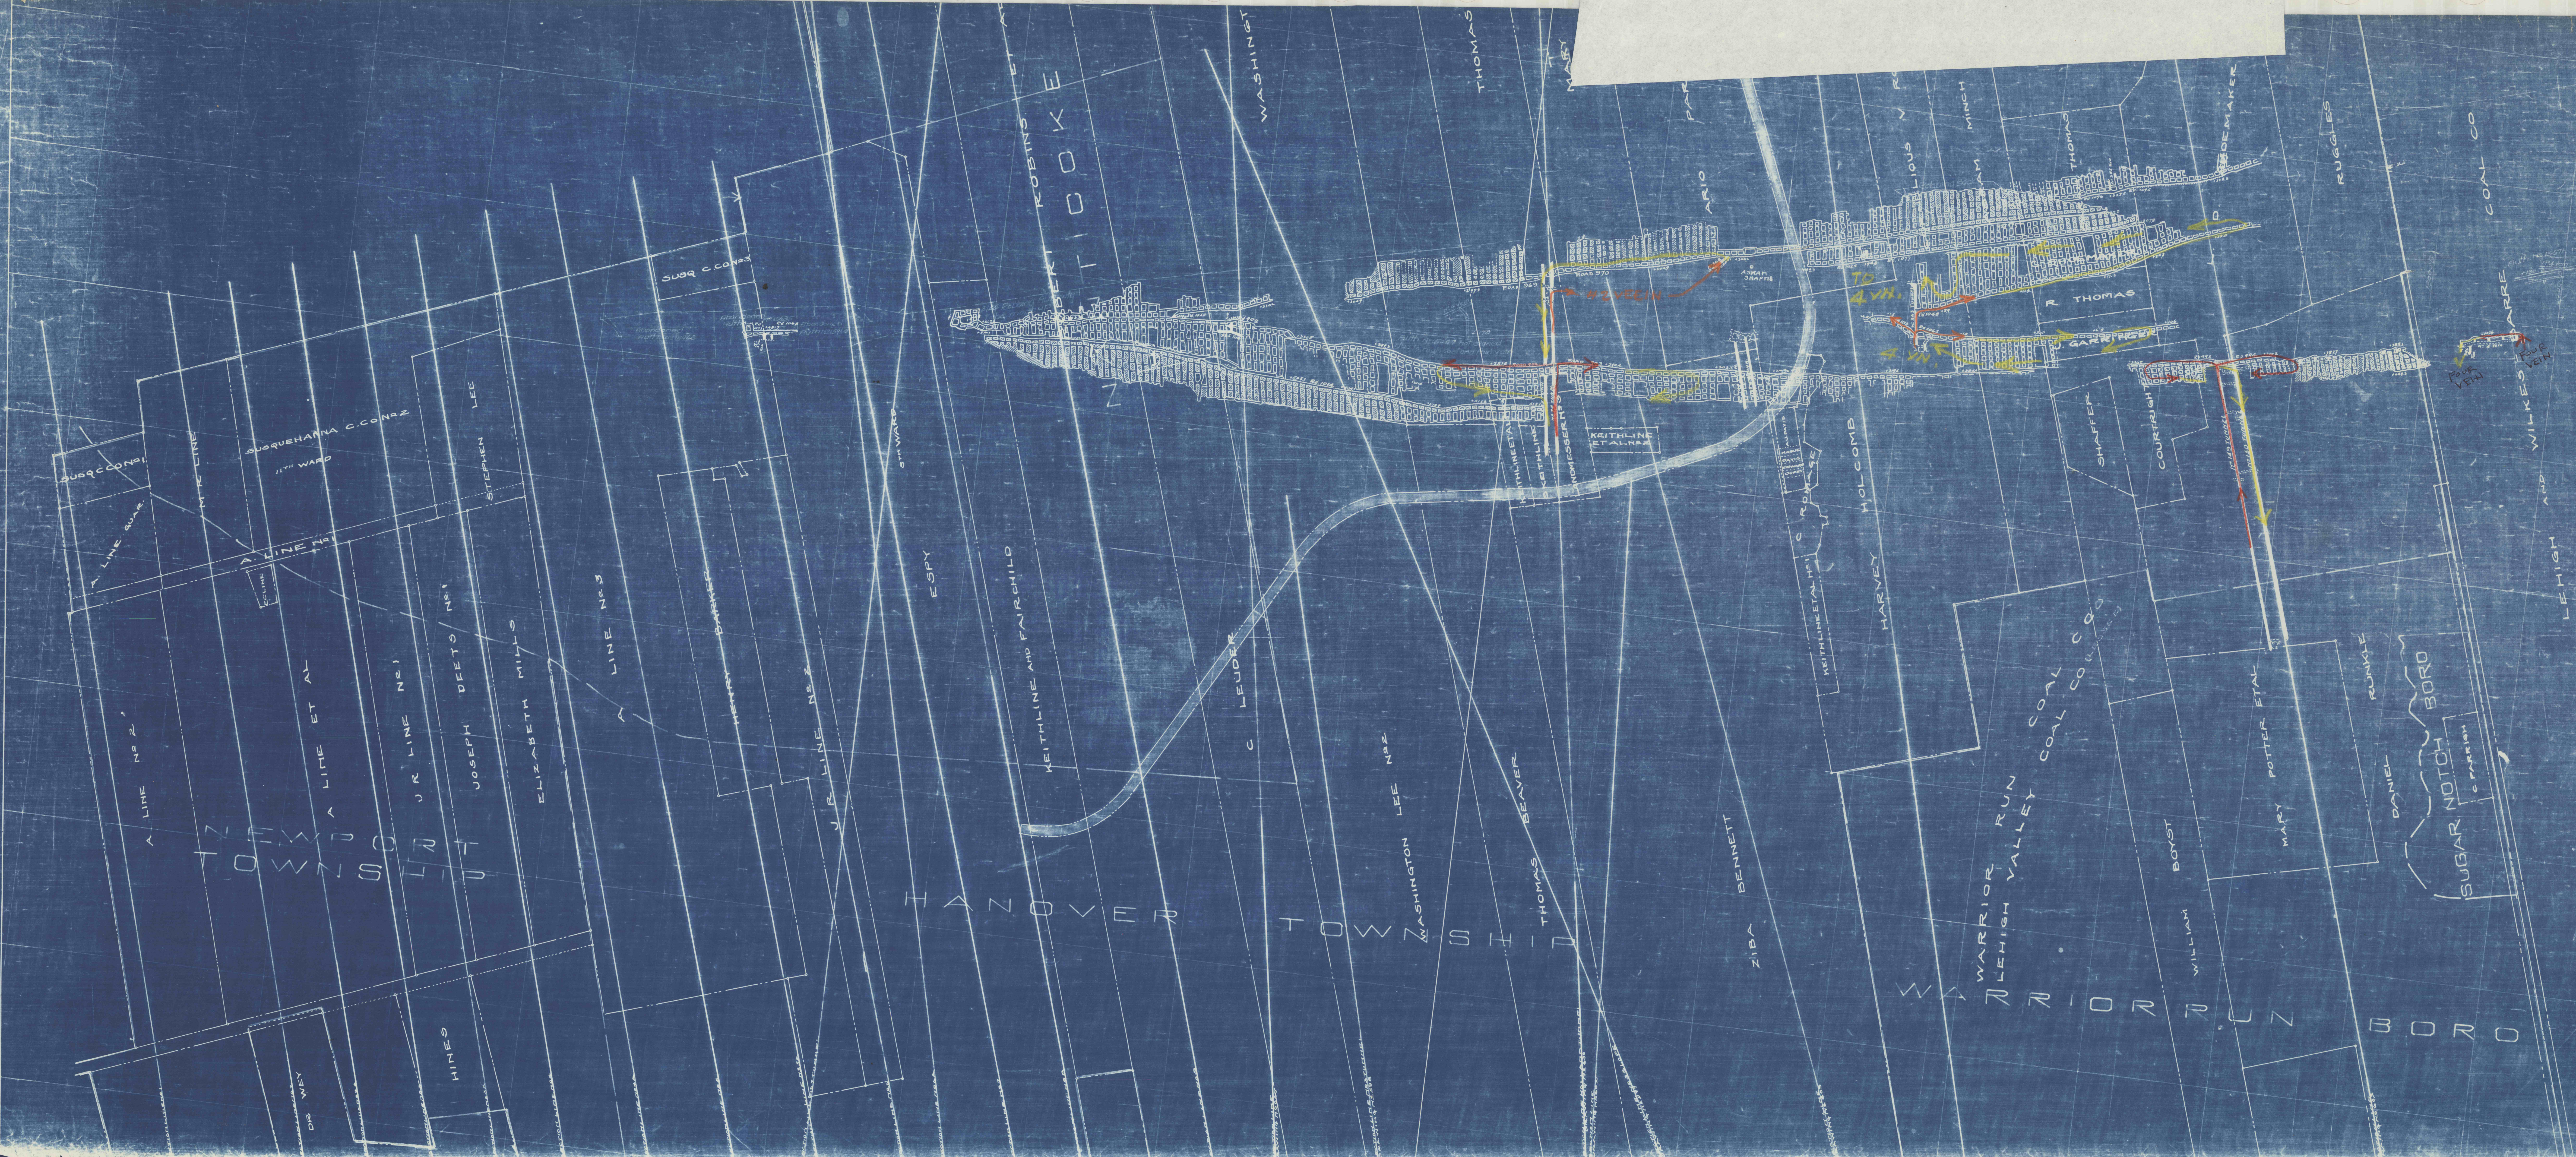

MAP
OF
THREE VEIN
AT
AUCHINOSS BLISS LOOMIS
AND
TRUEDALE MINES
SCALE IN FEET