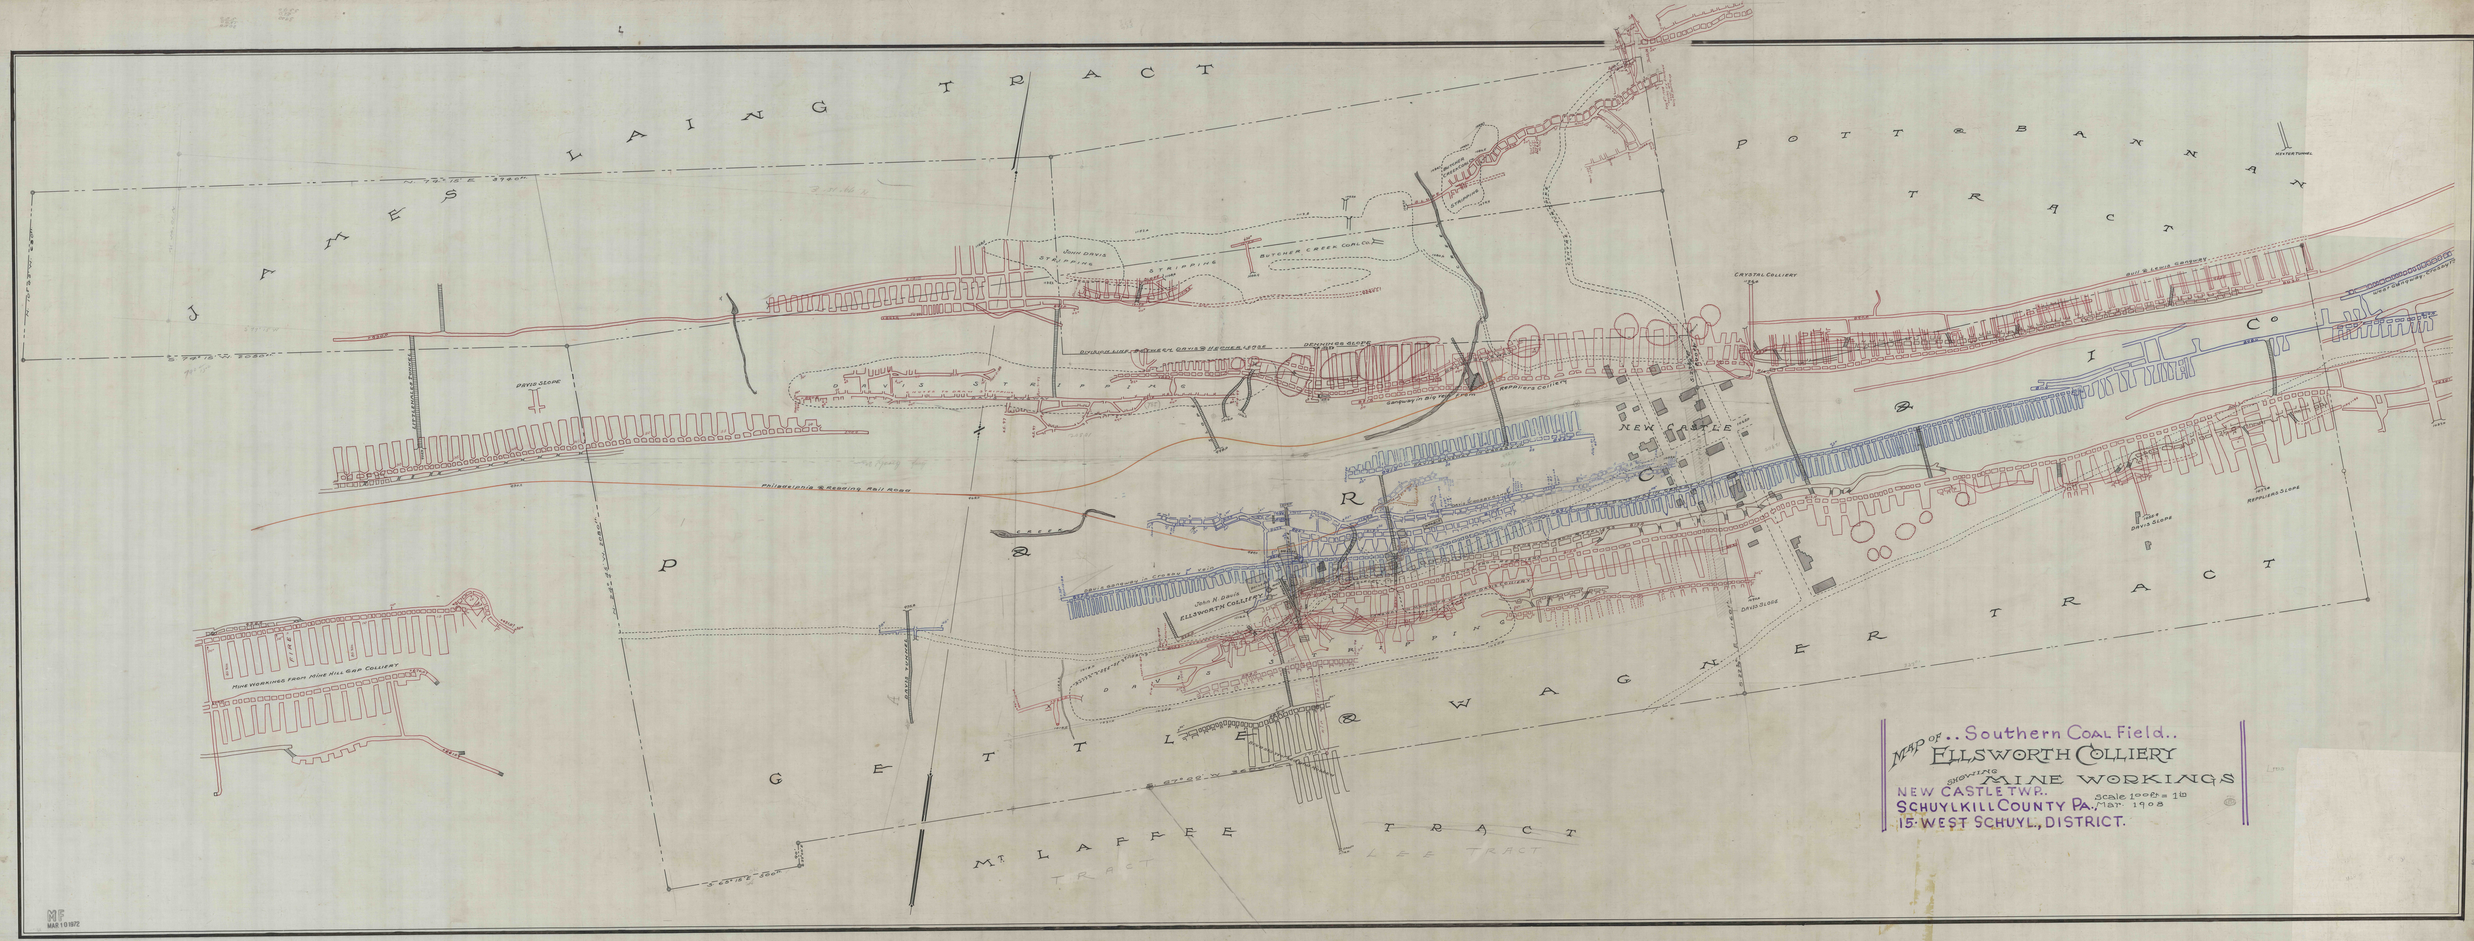

JAMES LAING TRACT
POTT & BANNAN TRACT
GETTLE & WAGNER TRACT
P & R C & I Co
Mt LAFFEE TRACT
LEE TRACT
TRACT
NEW CASTLE
HEXTER TUNNEL
Bull & Lewis Gangway
West Gangway, Crosby Vn
CRYSTAL COLLIERY
CENTRE TURNPIKE
CREEK
BUTCHER CREEK COAL CO.
STRIPPING
SLOPE
JOHN DAVIS STRIPPING
DIVISION LINE BETWEEN DAVIS & HEPNER LEASE
DENNINGS SLOPE
DAVIS STRIPPING
CHUTES TO DRAW STRIPPING
DAVIS GANGWAY
Gangway in Big Vein from Repplier's Colliery
DAVIS GANGWAY
Davis Gangway in Crosby Vn
DAVIS GANGWAY IN CROSBY VN
Davis Gangway in Crosby 30° Vein
DAVIS CROSBY GANGWAY
GANGWAY FROM REPPLIERS
GANGWAY FROM REPPLIERS
GANGWAY IN MAMMOTH VN FROM DAVIS COLLIERY
John H. Davis
ELLSWORTH COLLIERY
BOILERS
BREAKER
STABLE
ROCK SLOPE
North Edge of Stripping
Breasts Worked and Robbed
Air Hole
REPPLIERS SLOPE
DAVIS SLOPE
DAVIS SLOPE
LITTLEHALES TUNNEL
Philadelphia & Reading Rail Road
MINE WORKINGS FROM MINE HILL GAP COLLIERY
FIRE
85 Yds.
DAM
S. 74° 15' W. 2050 ft.
N. 10° 23' W. 630 ft.
S. 67° 00' W. 3600 ft.
890.0
803.0
808.0
811.0
892.5
891.0
998.0
968.0
1016.6
1065.0
1077.4
1055.9

MAP OF .. Southern Coal Field ..
ELLSWORTH COLLIERY
SHOWING MINE WORKINGS
NEW CASTLE TWP. ..
SCHUYLKILL COUNTY PA.,
15 · WEST SCHUYL., DISTRICT.

Scale 100 ft. = 1 in
Mar. 1908

WBW

L705

MF
MAR 10 1972