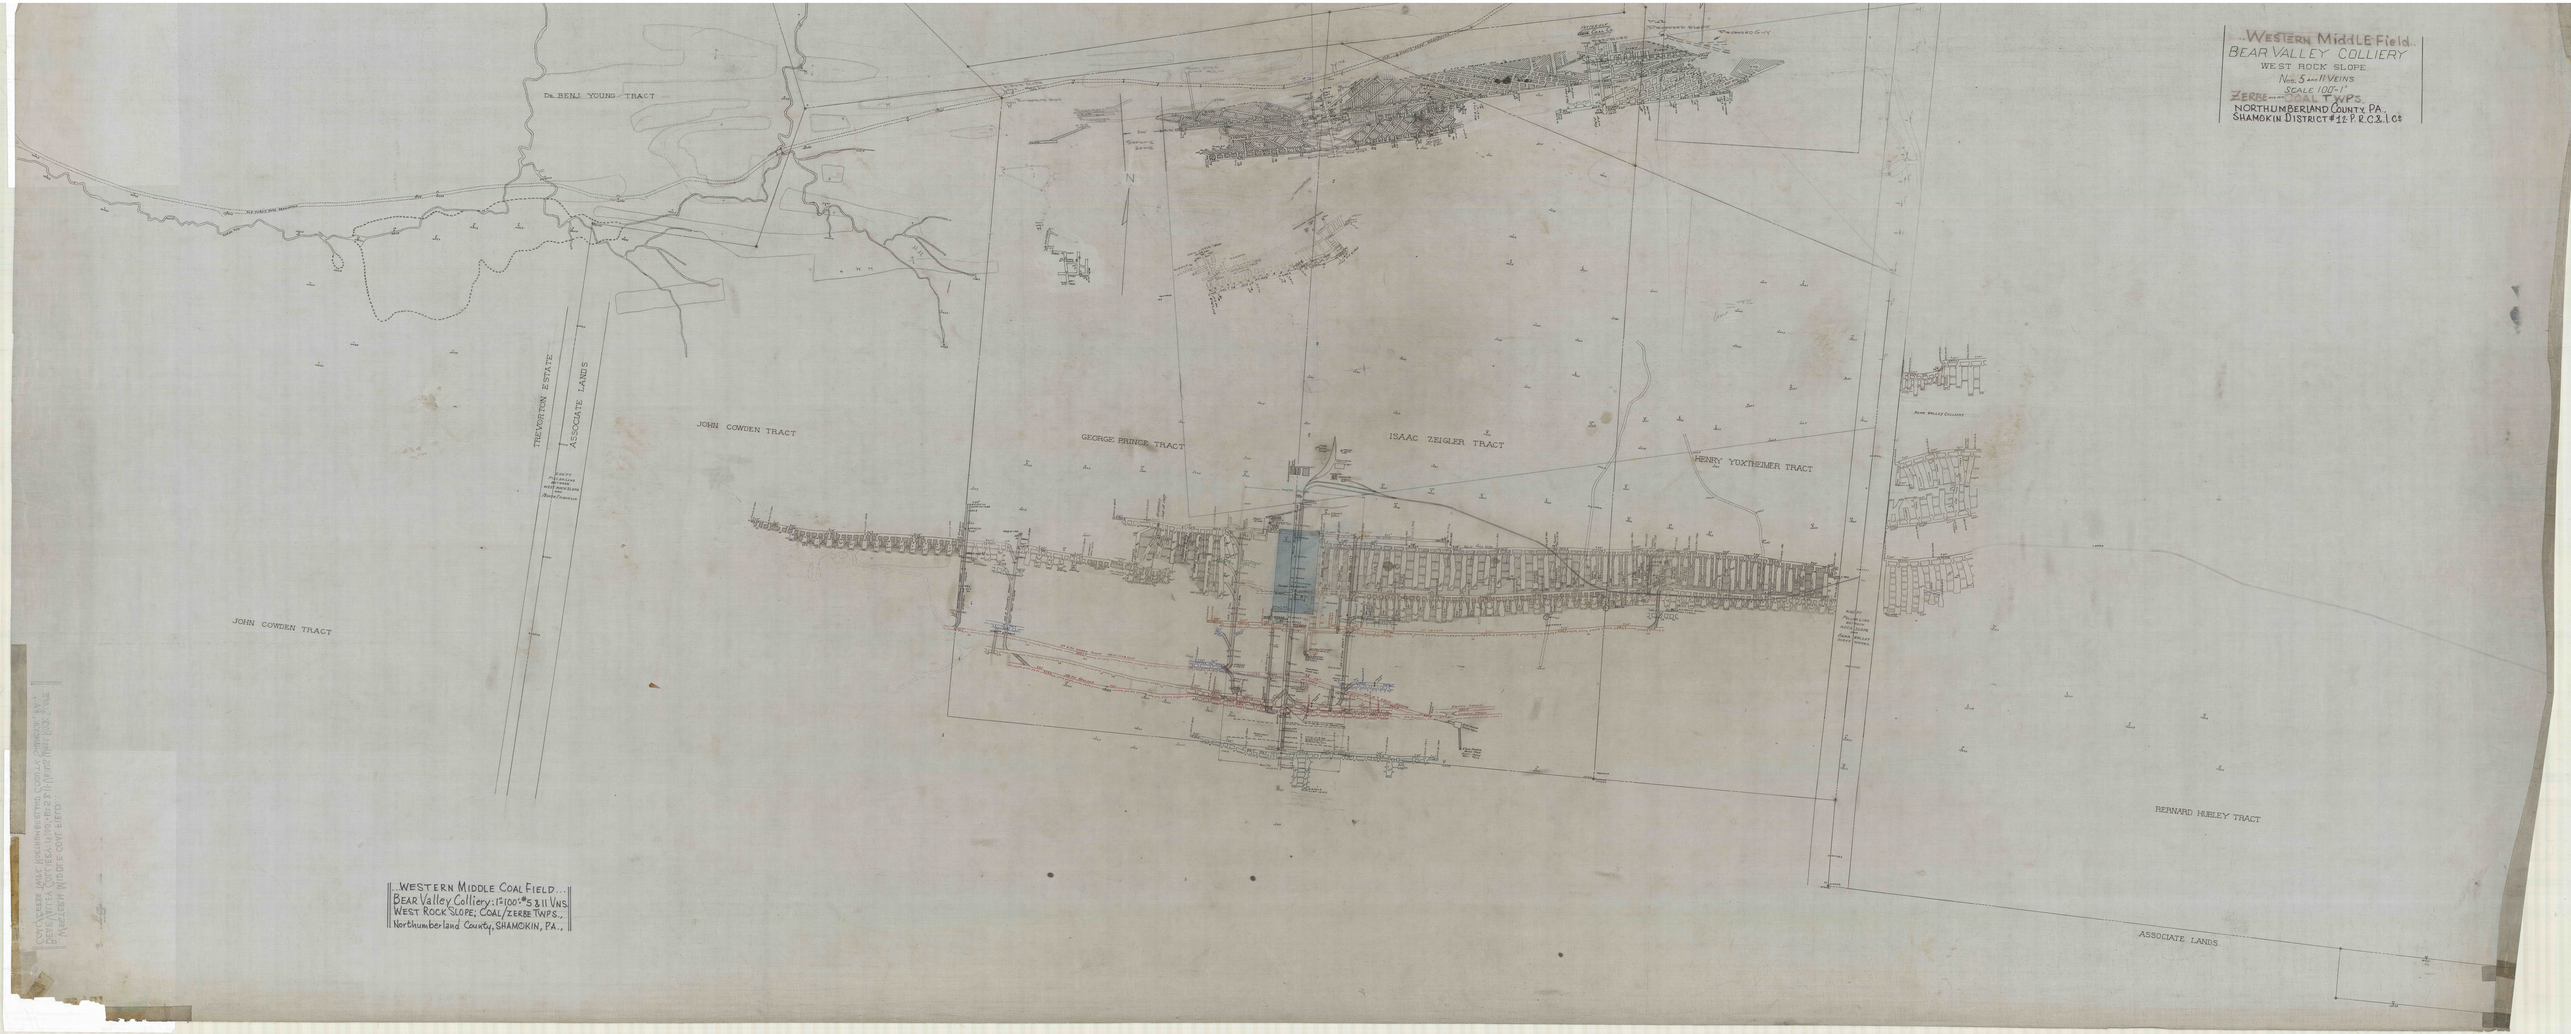

WESTERN Middle Field.
BEAR VALLEY COLLIERY
WEST ROCK SLOPE
Nos. 5 & 11 VEINS
SCALE 100-1"
ZERBE TWPS.
NORTHUMBERLAND COUNTY, PA.
SHAMOKIN DISTRICT 42 P.R.C.S. & C.
Dr. BENJ. YOUNG TRACT
TREVORTON ESTATE
ASSOCIATE LANDS
JOHN COWDEN TRACT
GEORGE BRINGE TRACT
ISAAC ZEIGLER TRACT
HENRY YOXTHEIMER TRACT
JOHN COWDEN TRACT
BERNARD HUBLEY TRACT
ASSOCIATE LANDS
N
WESTERN MIDDLE COAL FIELD
BEAR Valley Colliery: 1"=100'. 5 & 11 VNS.
WEST ROCK SLOPE; COAL/ZERBE TWPS.,
Northumberland County, SHAMOKIN, PA.,