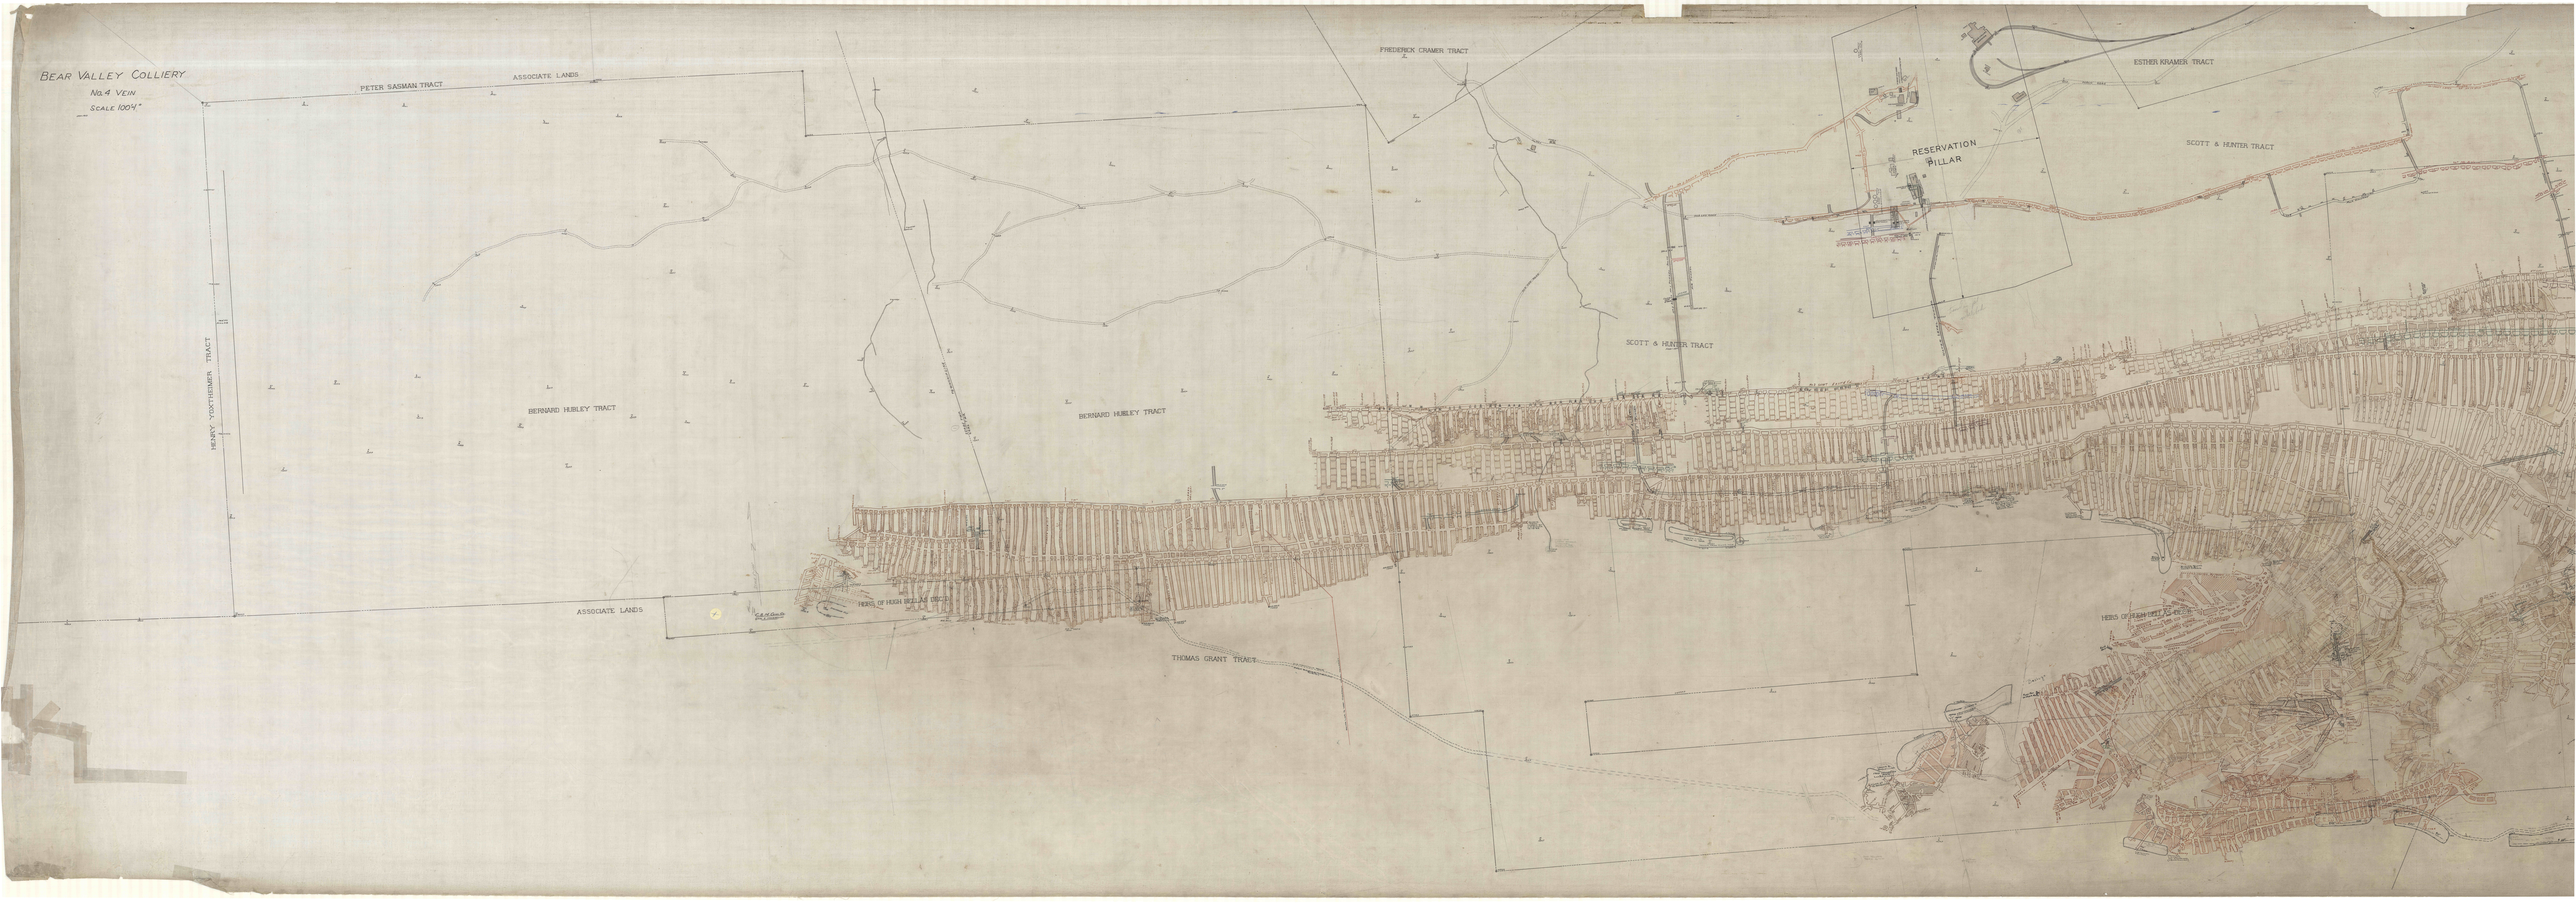
BEAR VALLEY COLLIERY
No. 4 VEIN
SCALE 1004'
PETER SASMAN TRACT
ASSOCIATE LANDS
FREDERICK CRAMER TRACT
ESTHER KRAMER TRACT
RESERVATION PILLAR
SCOTT & HUNTER TRACT
HENRY YOUTHEIMER TRACT
BERNARD HUBLEY TRACT
BERNARD HUBLEY TRACT
SCOTT & HUNTER TRACT
ASSOCIATE LANDS
HEIRS OF HUGH BELLAS DECD.
THOMAS GRANT TRACT
HEIRS OF HERBERT KRAMER