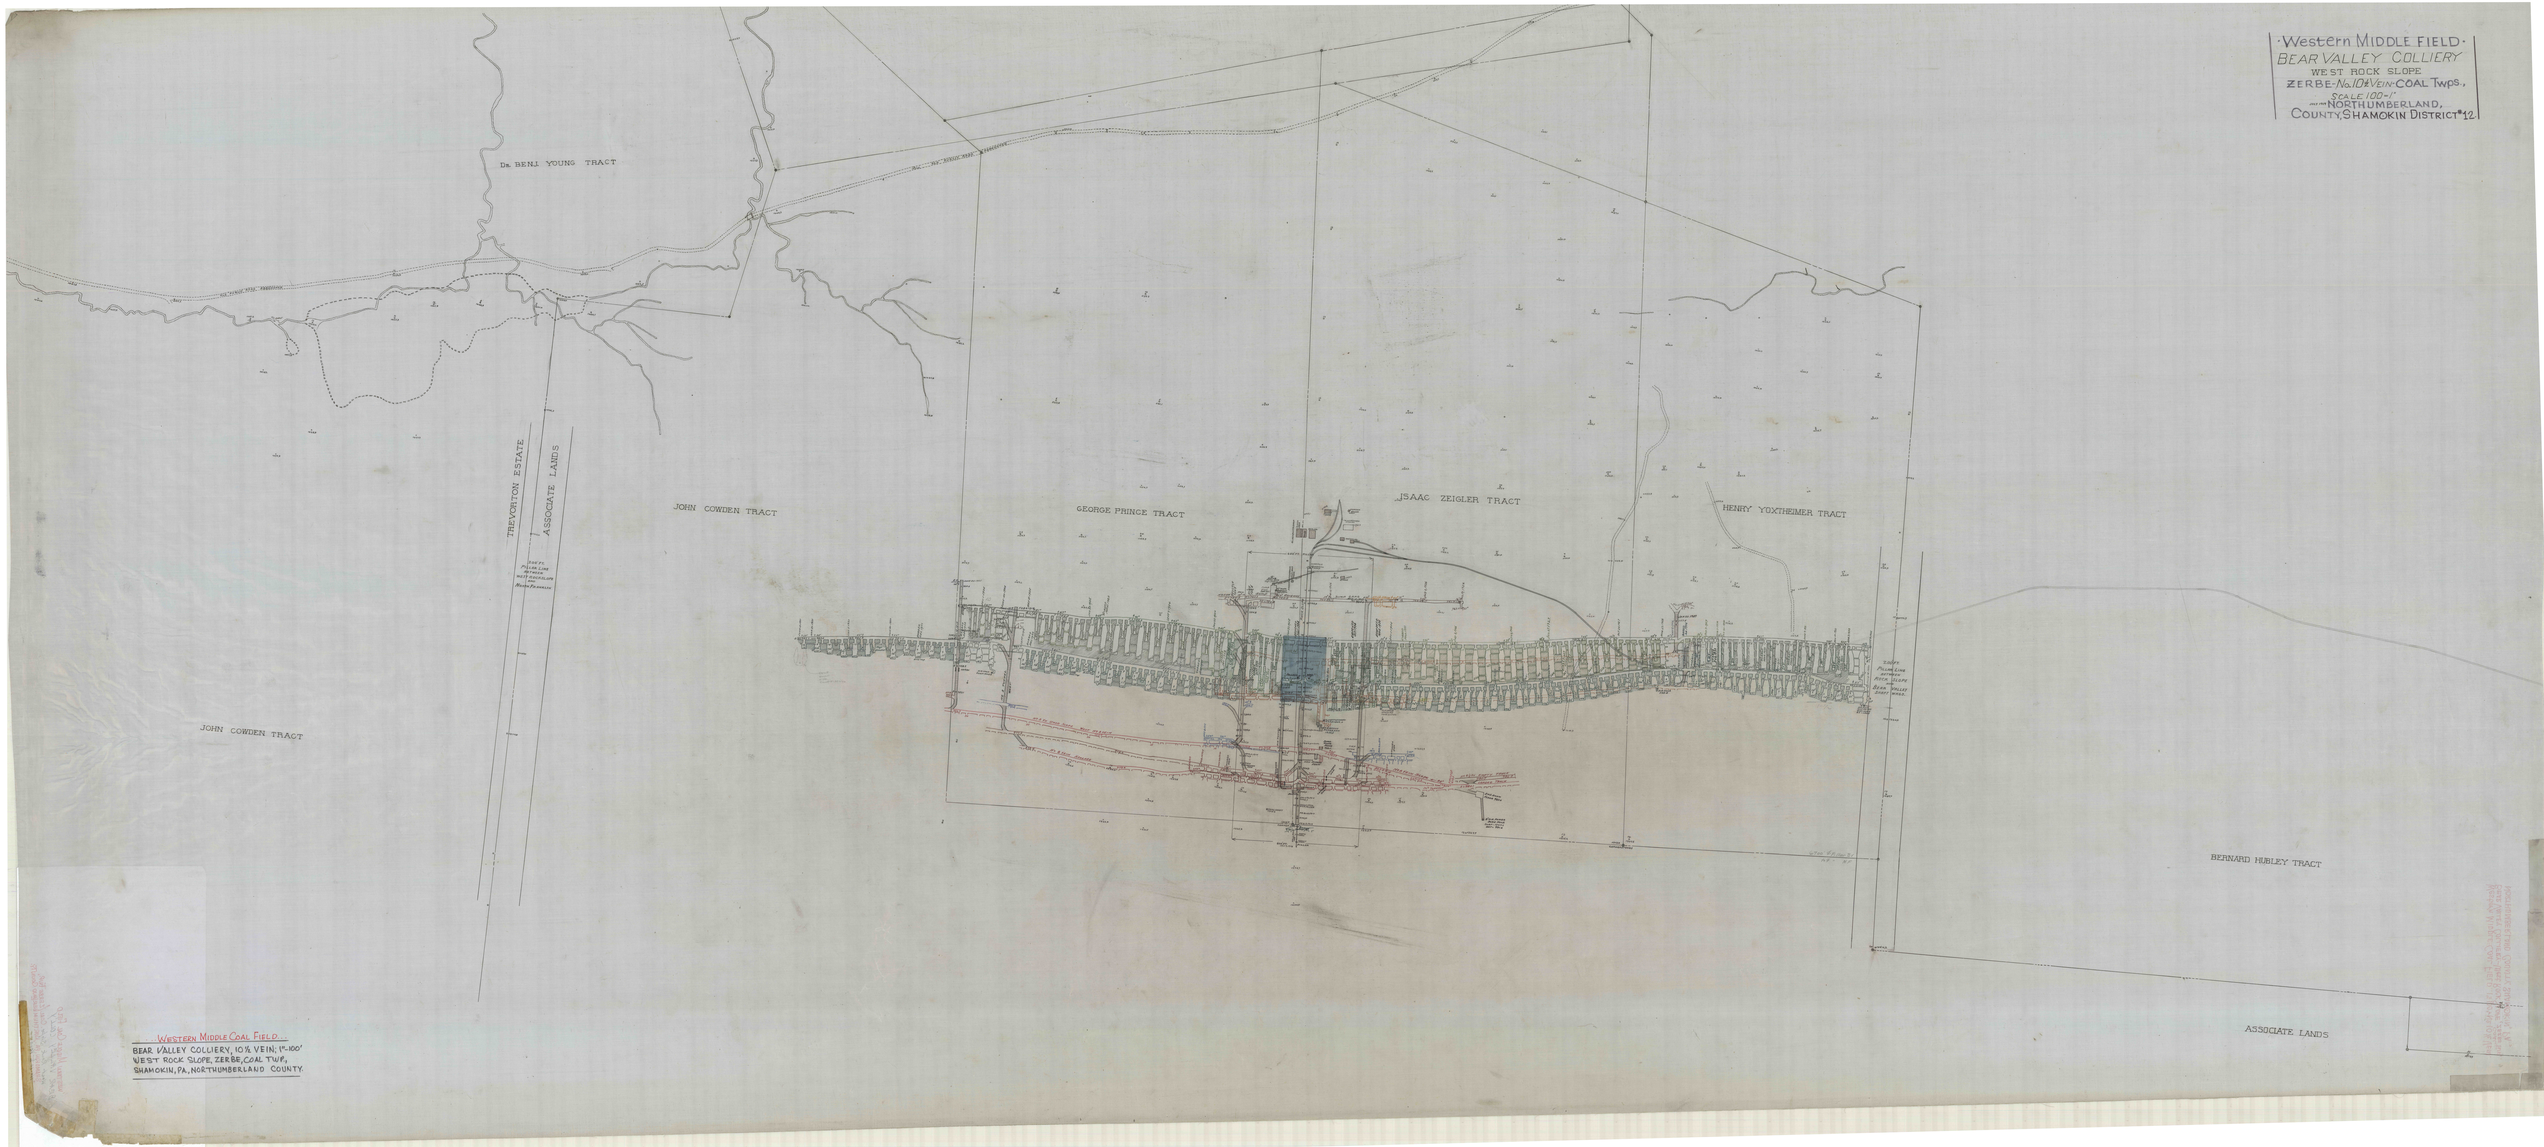
Western MIDDLE FIELD
BEAR VALLEY COLLIERY
WEST ROCK SLOPE
ZERBE-No.10 VEIN-COAL Twps.,
SCALE 100=1'
NORTHUMBERLAND,
COUNTY, SHAMOKIN DISTRICT #12
Dr. BENJ. YOUNG TRACT
TREVORTON ESTATE
ASSOCIATE LANDS
JOHN COWDEN TRACT
GEORGE PRINCE TRACT
ISAAC ZEIGLER TRACT
HENRY YOXTHEIMER TRACT
JOHN COWDEN TRACT
BERNARD HUBLEY TRACT
ASSOCIATE LANDS
Western MIDDLE COAL FIELD
BEAR VALLEY COLLIERY, 10 ft. VEIN, 1"=100'
WEST ROCK SLOPE, ZERBE COAL TWP.,
SHAMOKIN, PA., NORTHUMBERLAND COUNTY.