


SHEET.  
5 of 22.

CROSS SECTION  
2800' EAST

CROSS SECTION  
4800' EAST

CROSS SECTION  
519

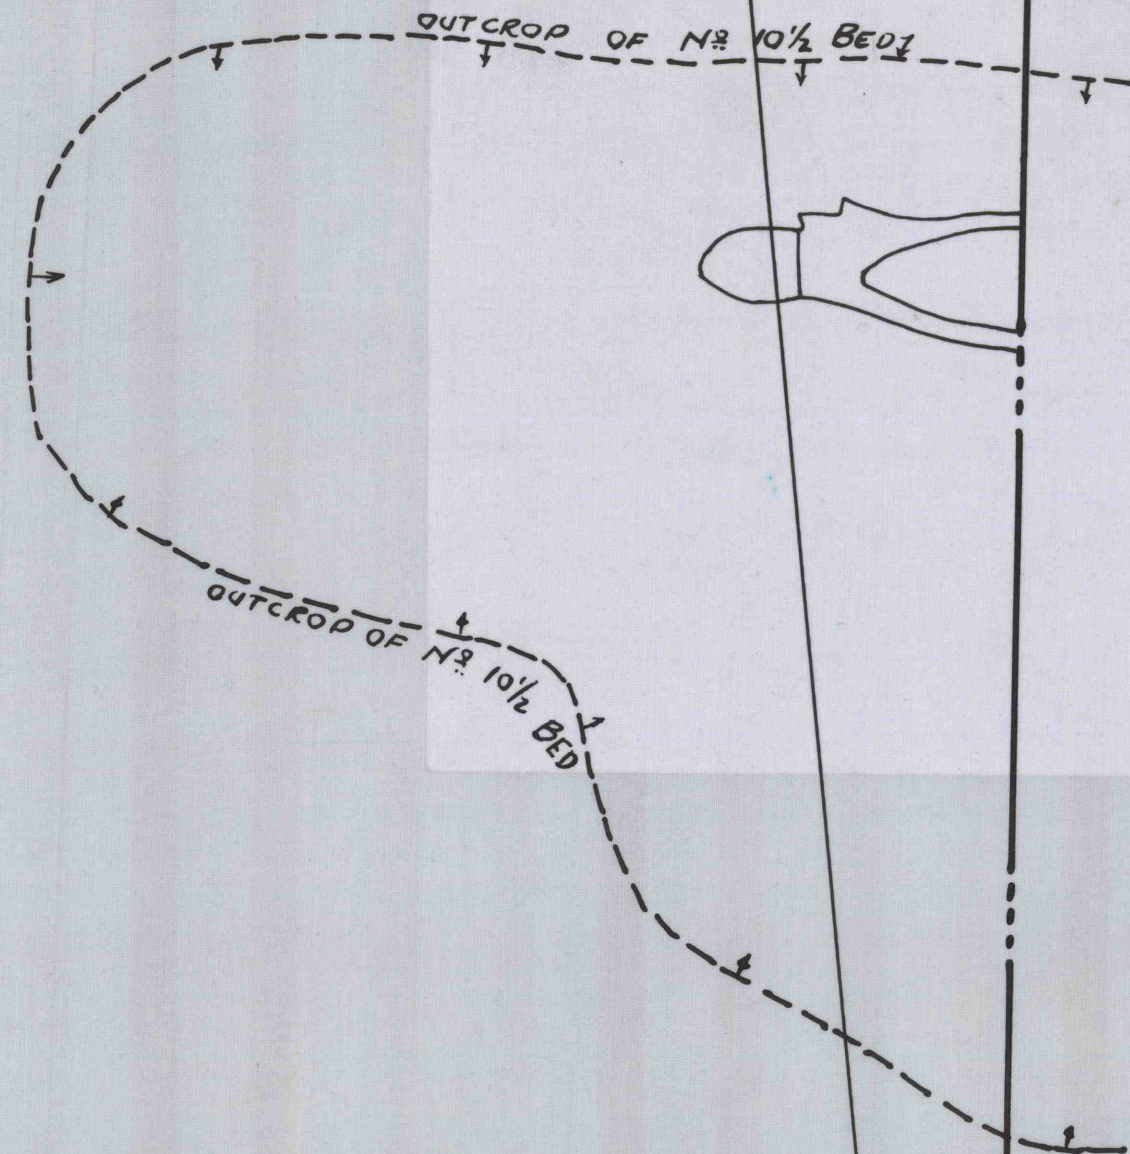

—LEGEND—

- EXHAUSTED
- FIRST MINED
- SOLID
- FAULT
- DOUBTFUL
- BARRIER PILLAR

N. 10 1/2 BED  
JAMES HEPBURN TRACT  
BEAR VALLEY AND BURNSIDE COLLIERIES.  
NORTHUMBERLAND COUNTY  
PENNSYLVANIA.  
SCALE 1" = 300 FT. JAN-30-1939.