

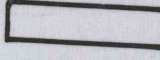
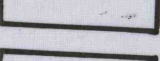


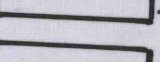

-LEGEND-

-  EXHAUSTED
-  FIRST MINED
-  SOLID
-  FAULT
-  DOUBTFUL
-  BARRIER PILLAR
- 

N^o 5 BED
JAMES HEPBURN TRACT
BEAR VALLEY AND BURNSIDE COLLIERIES
NORTHUMBERLAND COUNTY
PENNSYLVANIA.
SCALE 1" = 300 FT. JAN. 30-1939.

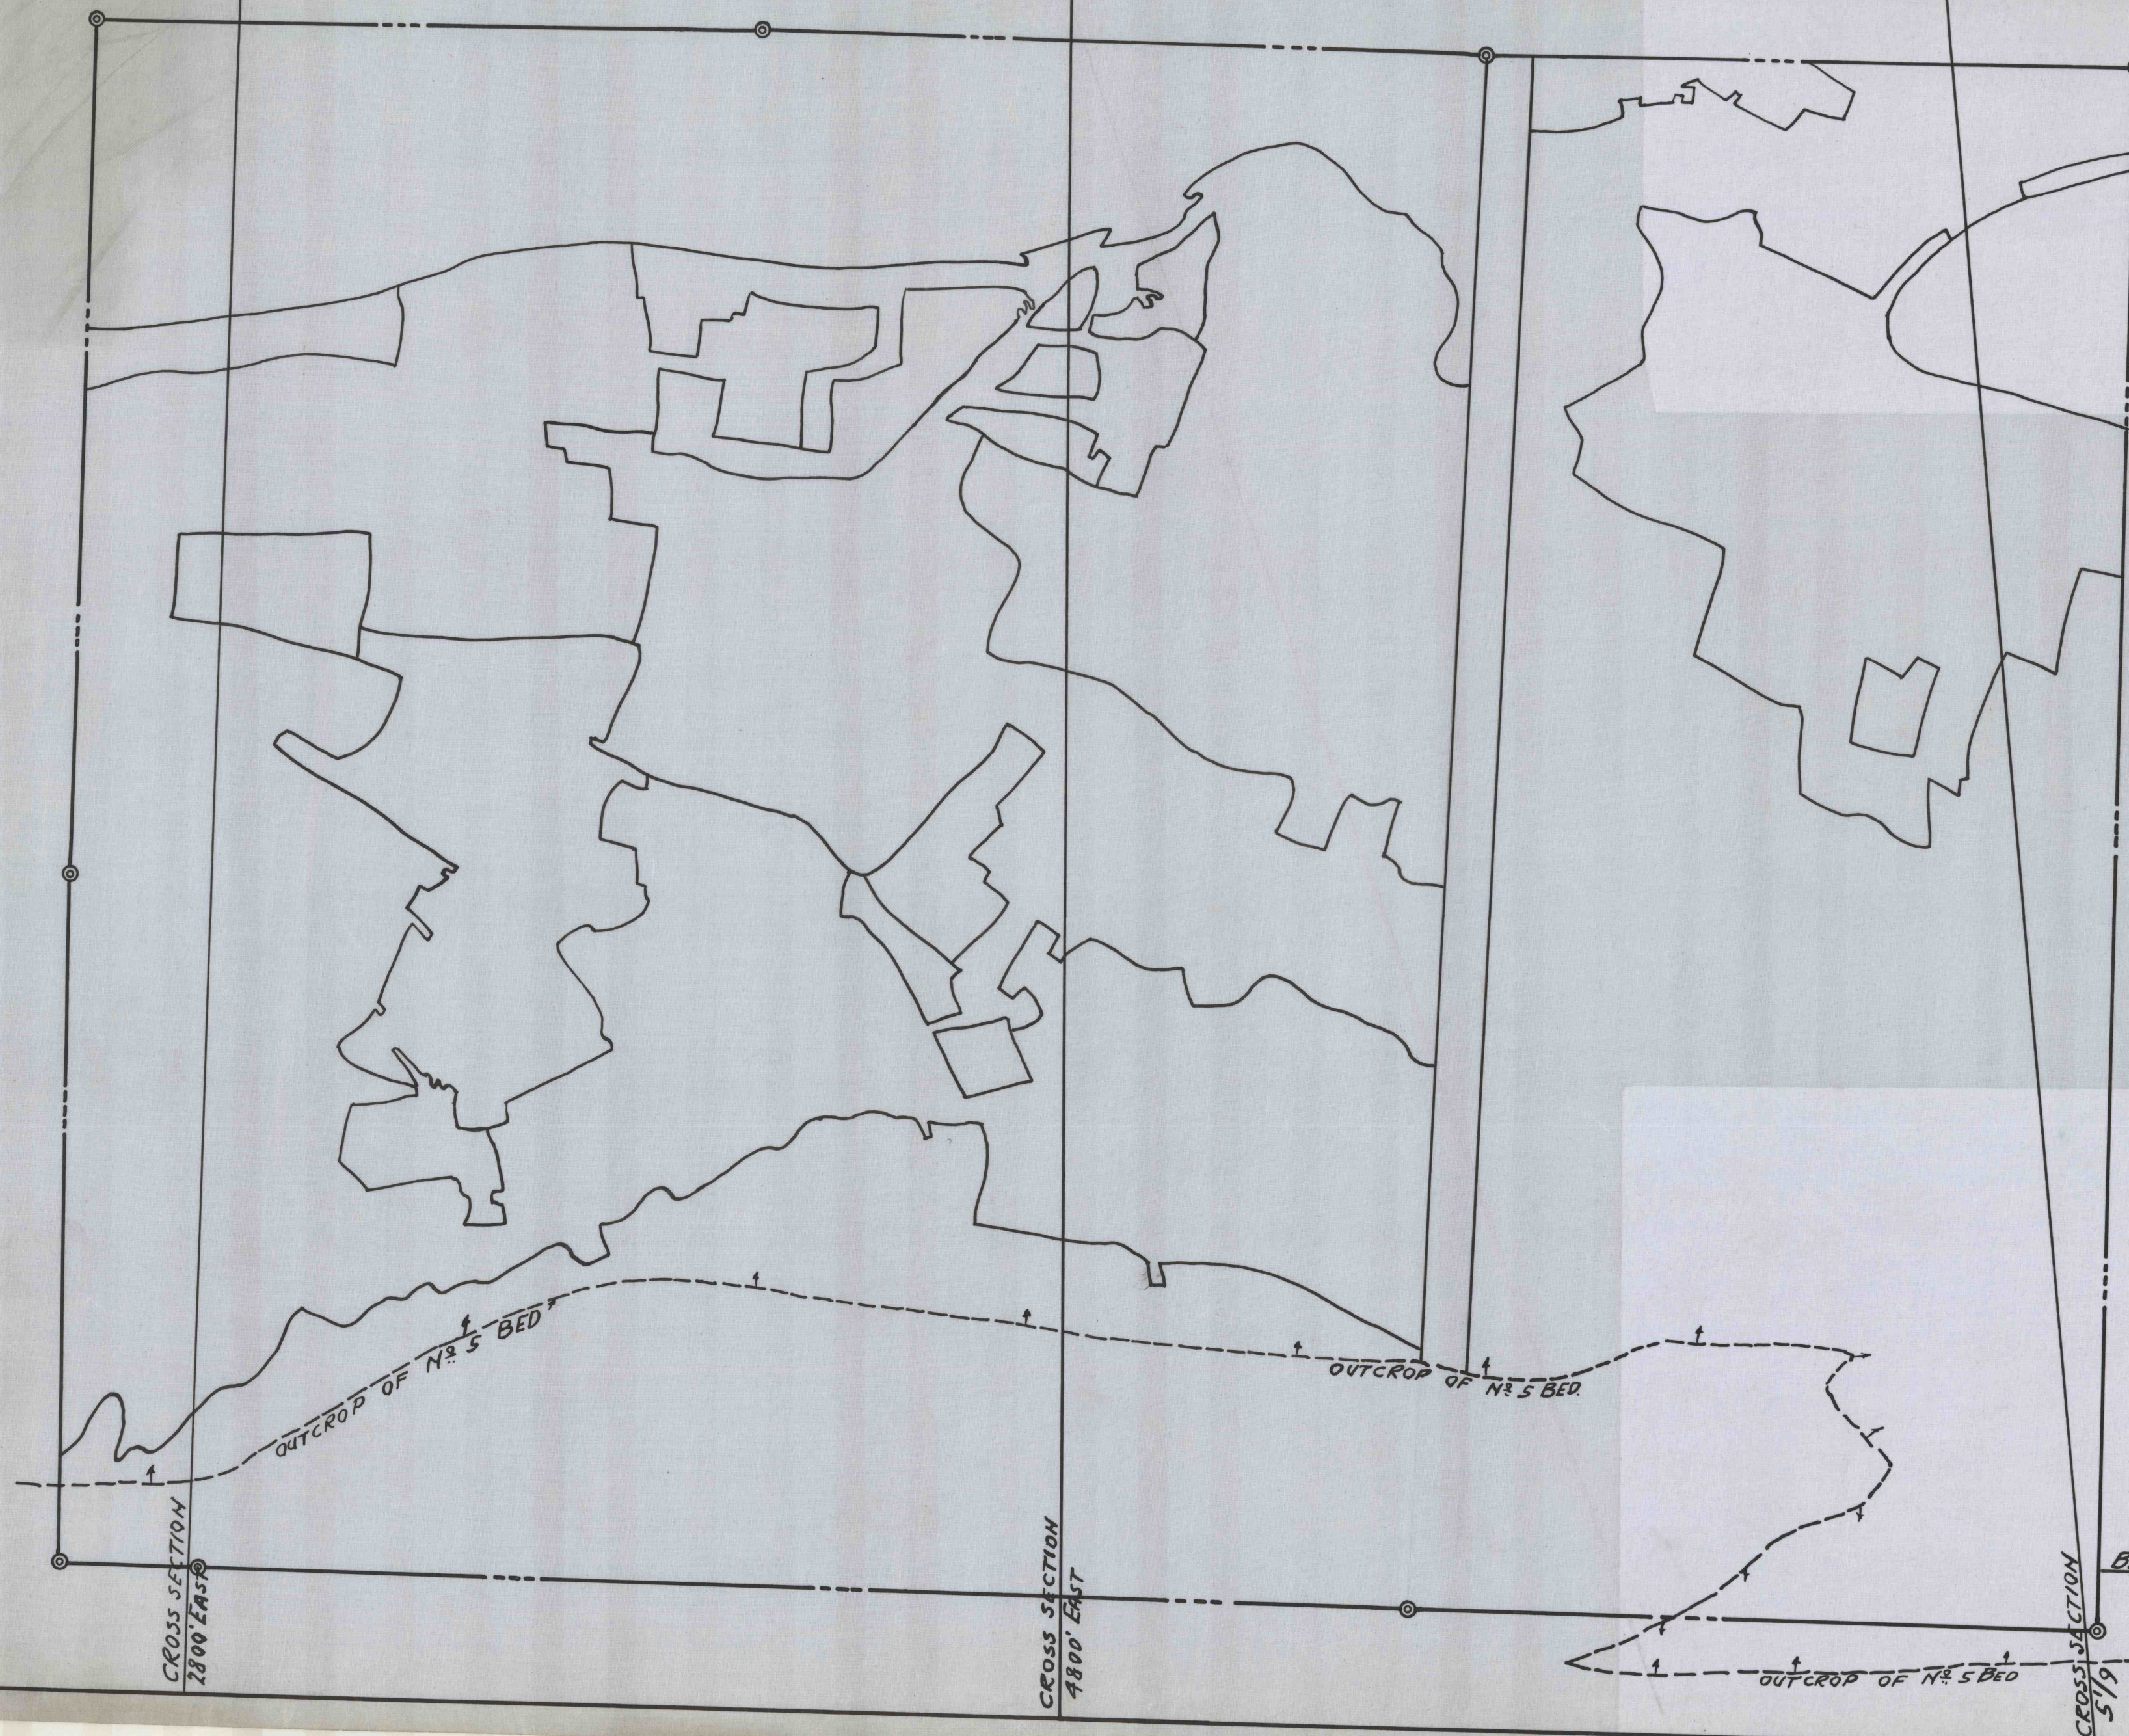

SHEET.
16 OF 22