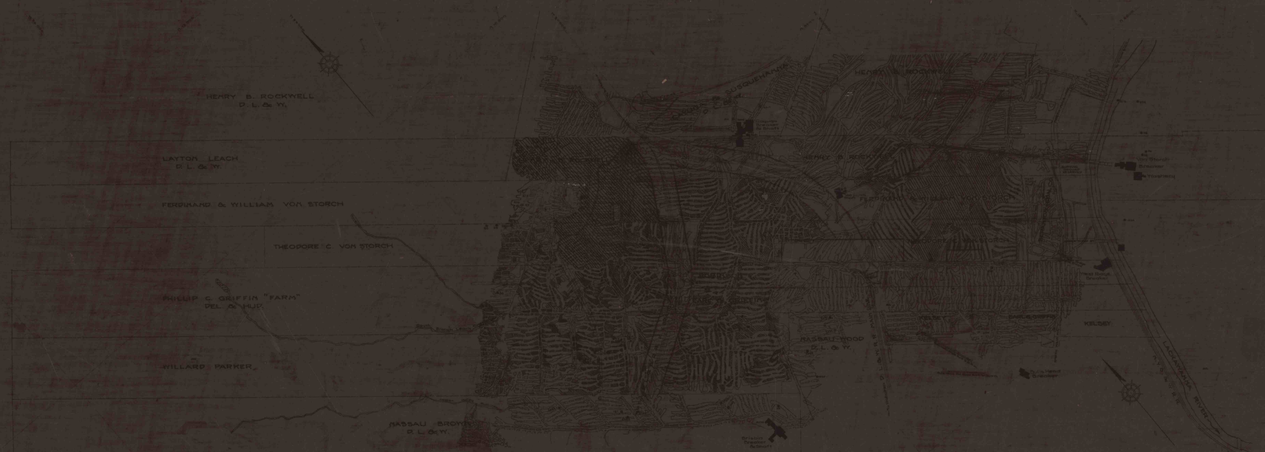
HENRY B. ROCKWELL
O.L.&W.
LAYTON LEACH
O.L.&W.
FERDINAND & WILLIAM VON STORCH
THEODORE C. VON STORCH
PHILLIP C. GRIFFIN "FARM"
DEL. & HUD.
WILLARD PARKER
NASSAU BROWN
O.L.&W.
RUSSELL WOOD
O.L.&W.
VOLKMAN
VON STORCH COLLIERIES CO.
VON STORCH
DIAMOND
Office Of Mining Engr. Scranton, Pa.
Scale 1" = 400'
June 6, 1951.
Index 98

Diamond