


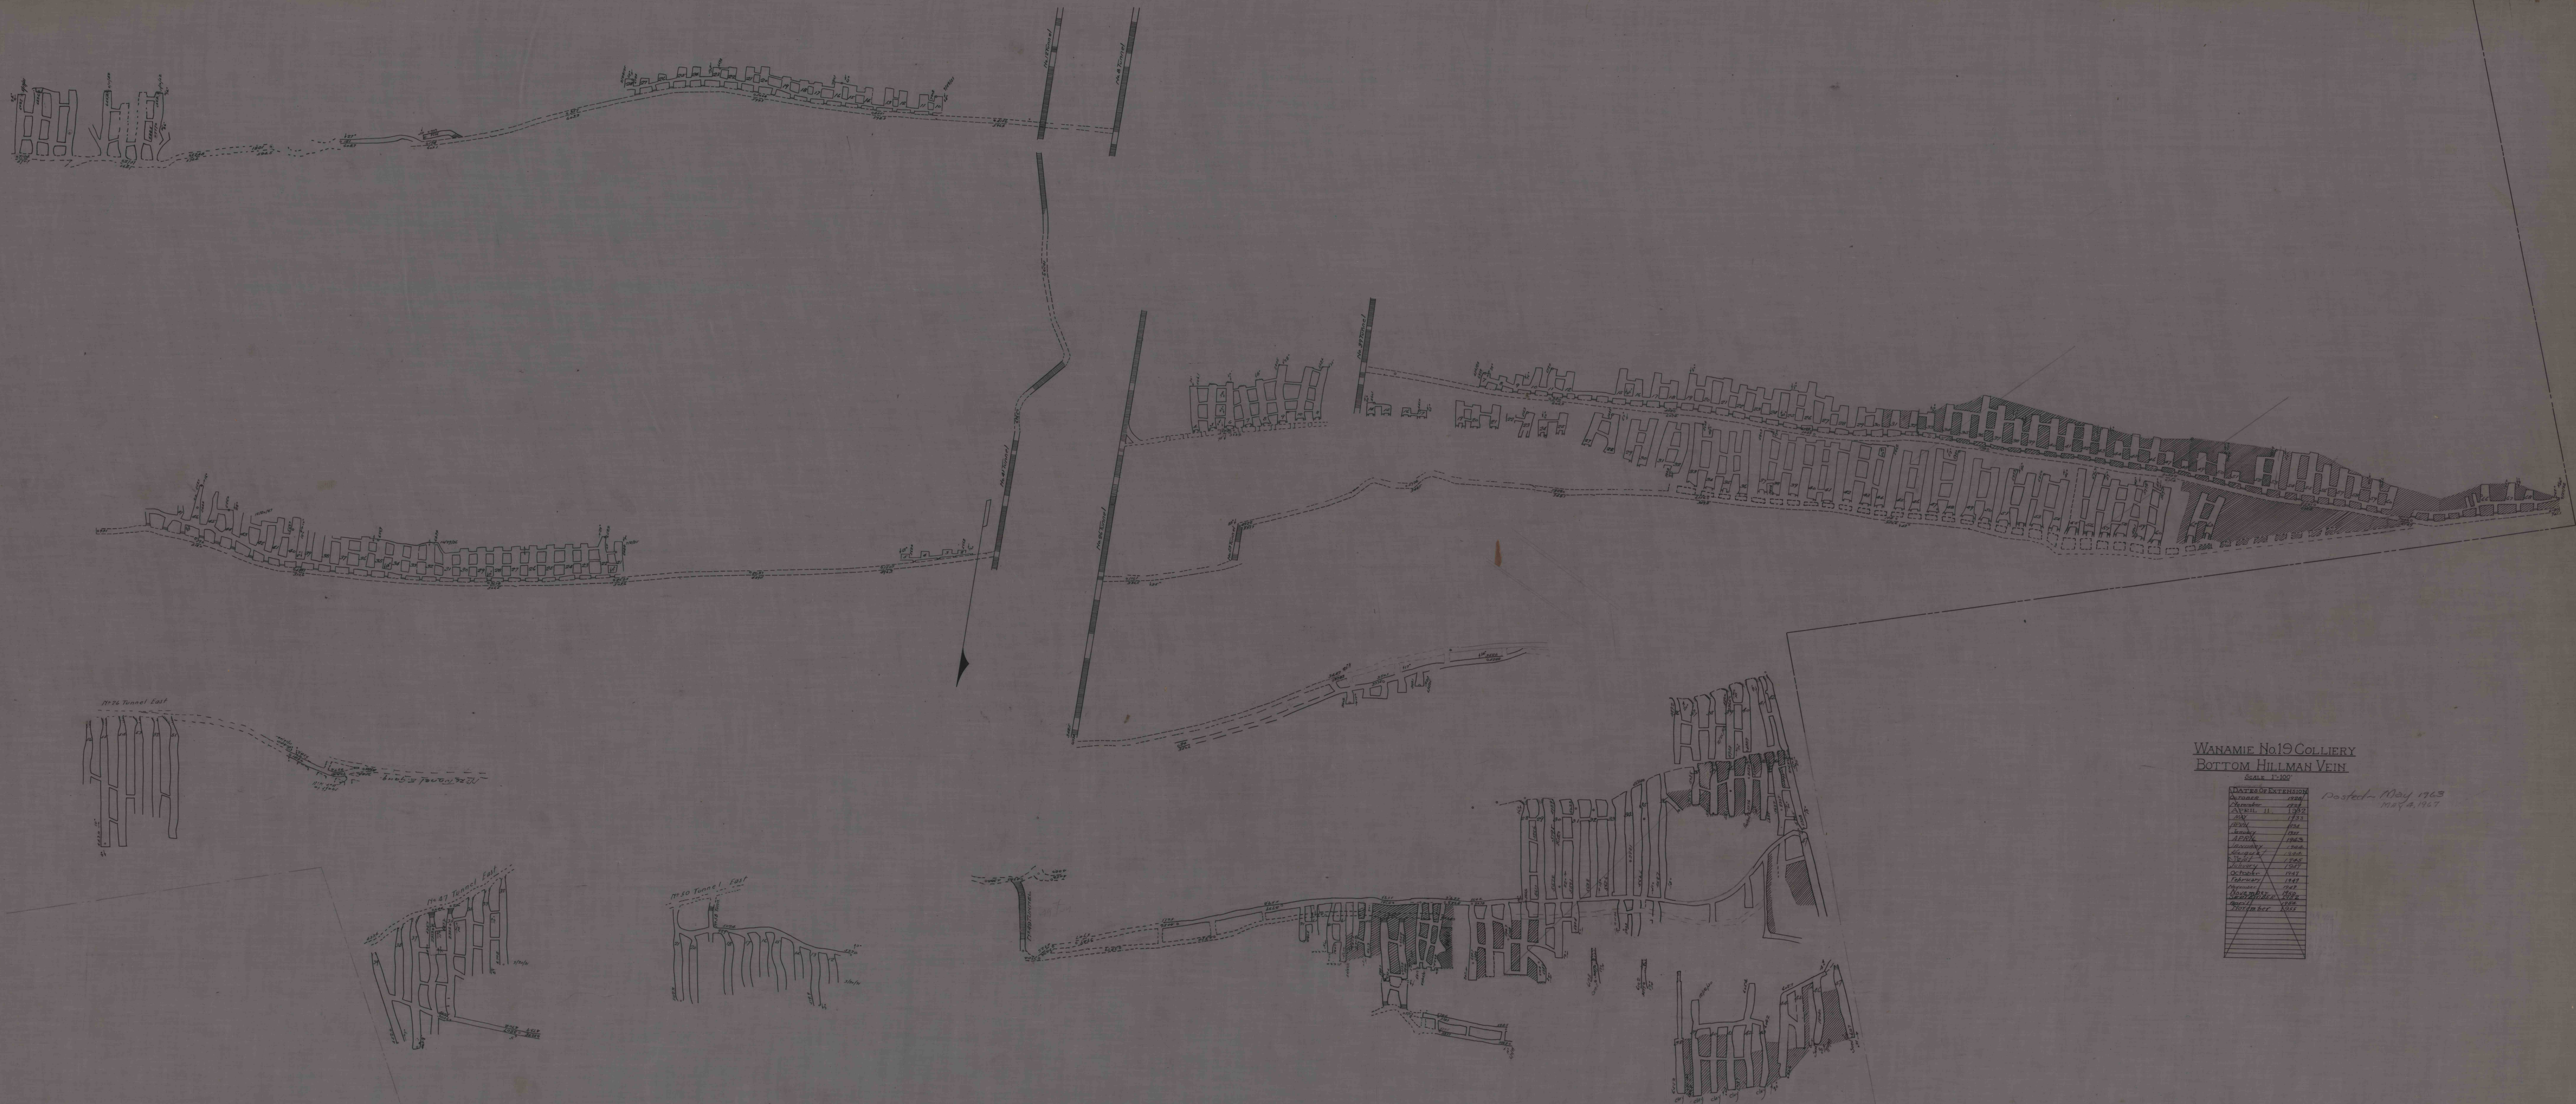

WANAMIE No. 19 COLLIERY
BOTTOM HILLMAN VEIN

Scale 1"=100'

DATE OF EXTENSION	

Posted May 1963
1888, 1963