


RECORDED
INDEXED
WILKES-BARRIE
JAN 27 1967

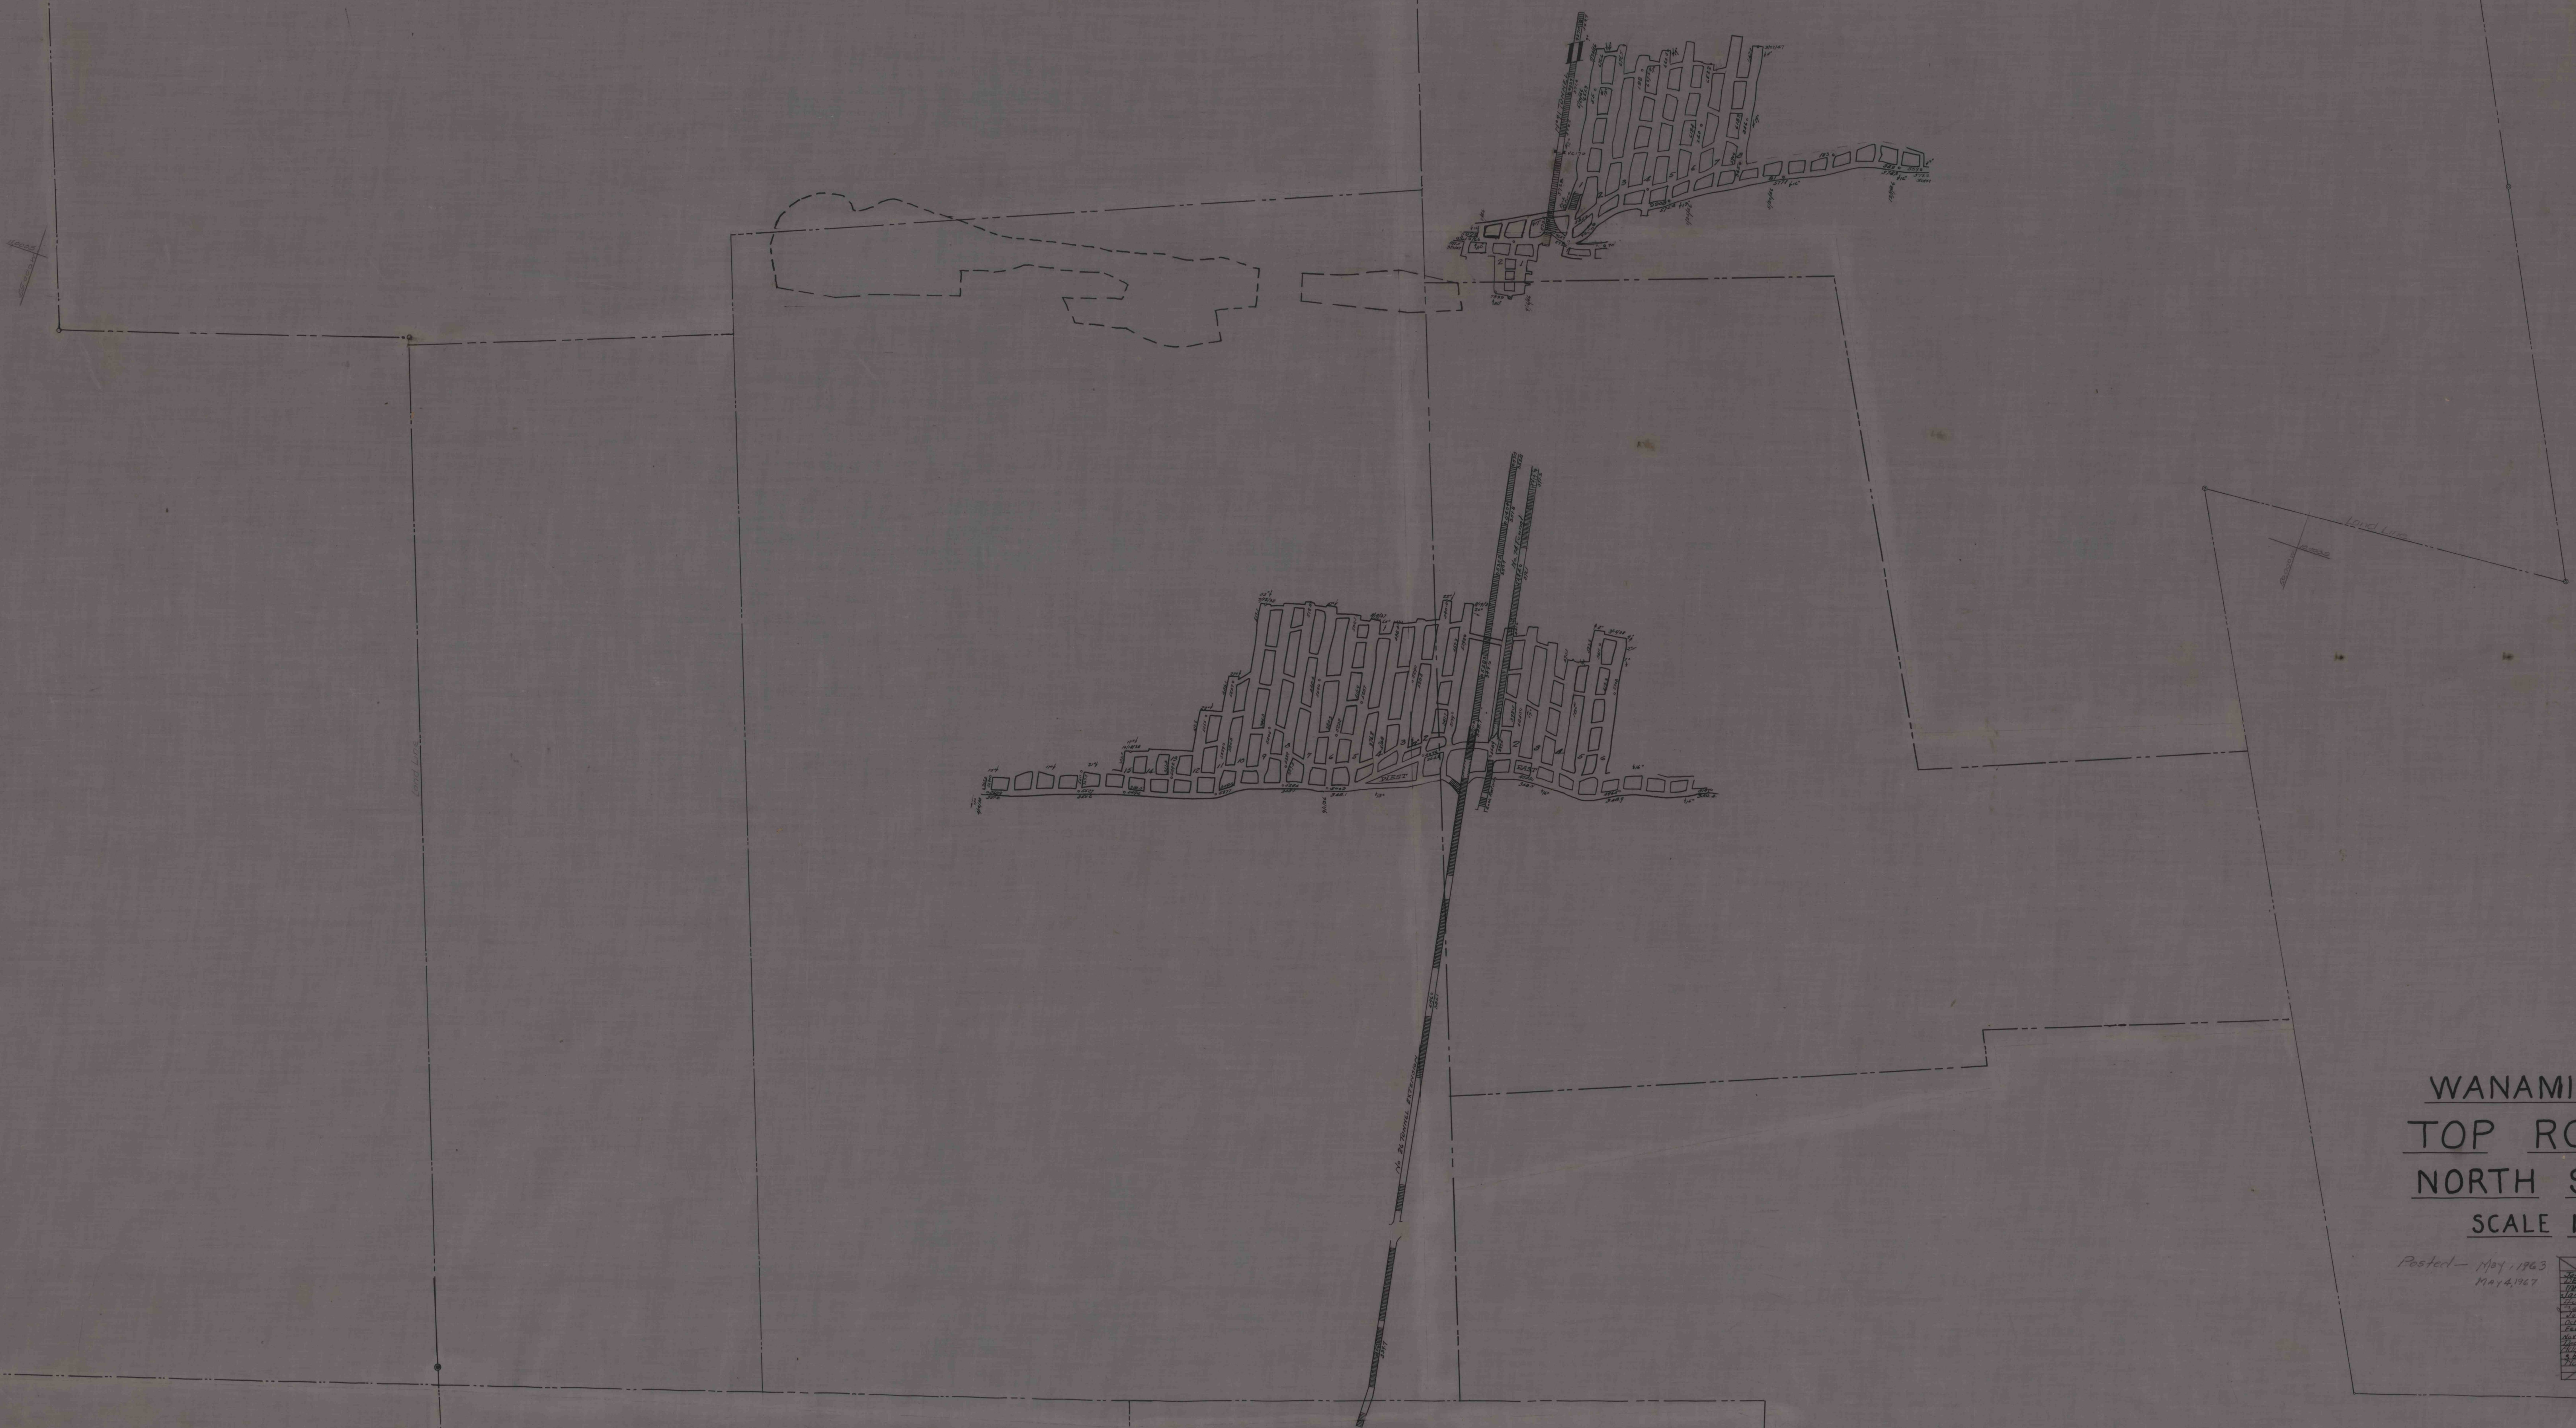

WANAMIE NO 19
TOP ROSS VEIN
NORTH SECTION
SCALE 1" = 100'

Posted - May 1, 1963
May 4, 1967

DATE OF EXTENSION	
January 1963	
February 1963	
March 1963	
April 1963	
May 1963	
June 1963	
July 1963	
August 1963	
September 1963	
October 1963	
November 1963	
December 1963	

RECORDED
INDEXED
WILKES-BARRIE
JAN 27 1967