


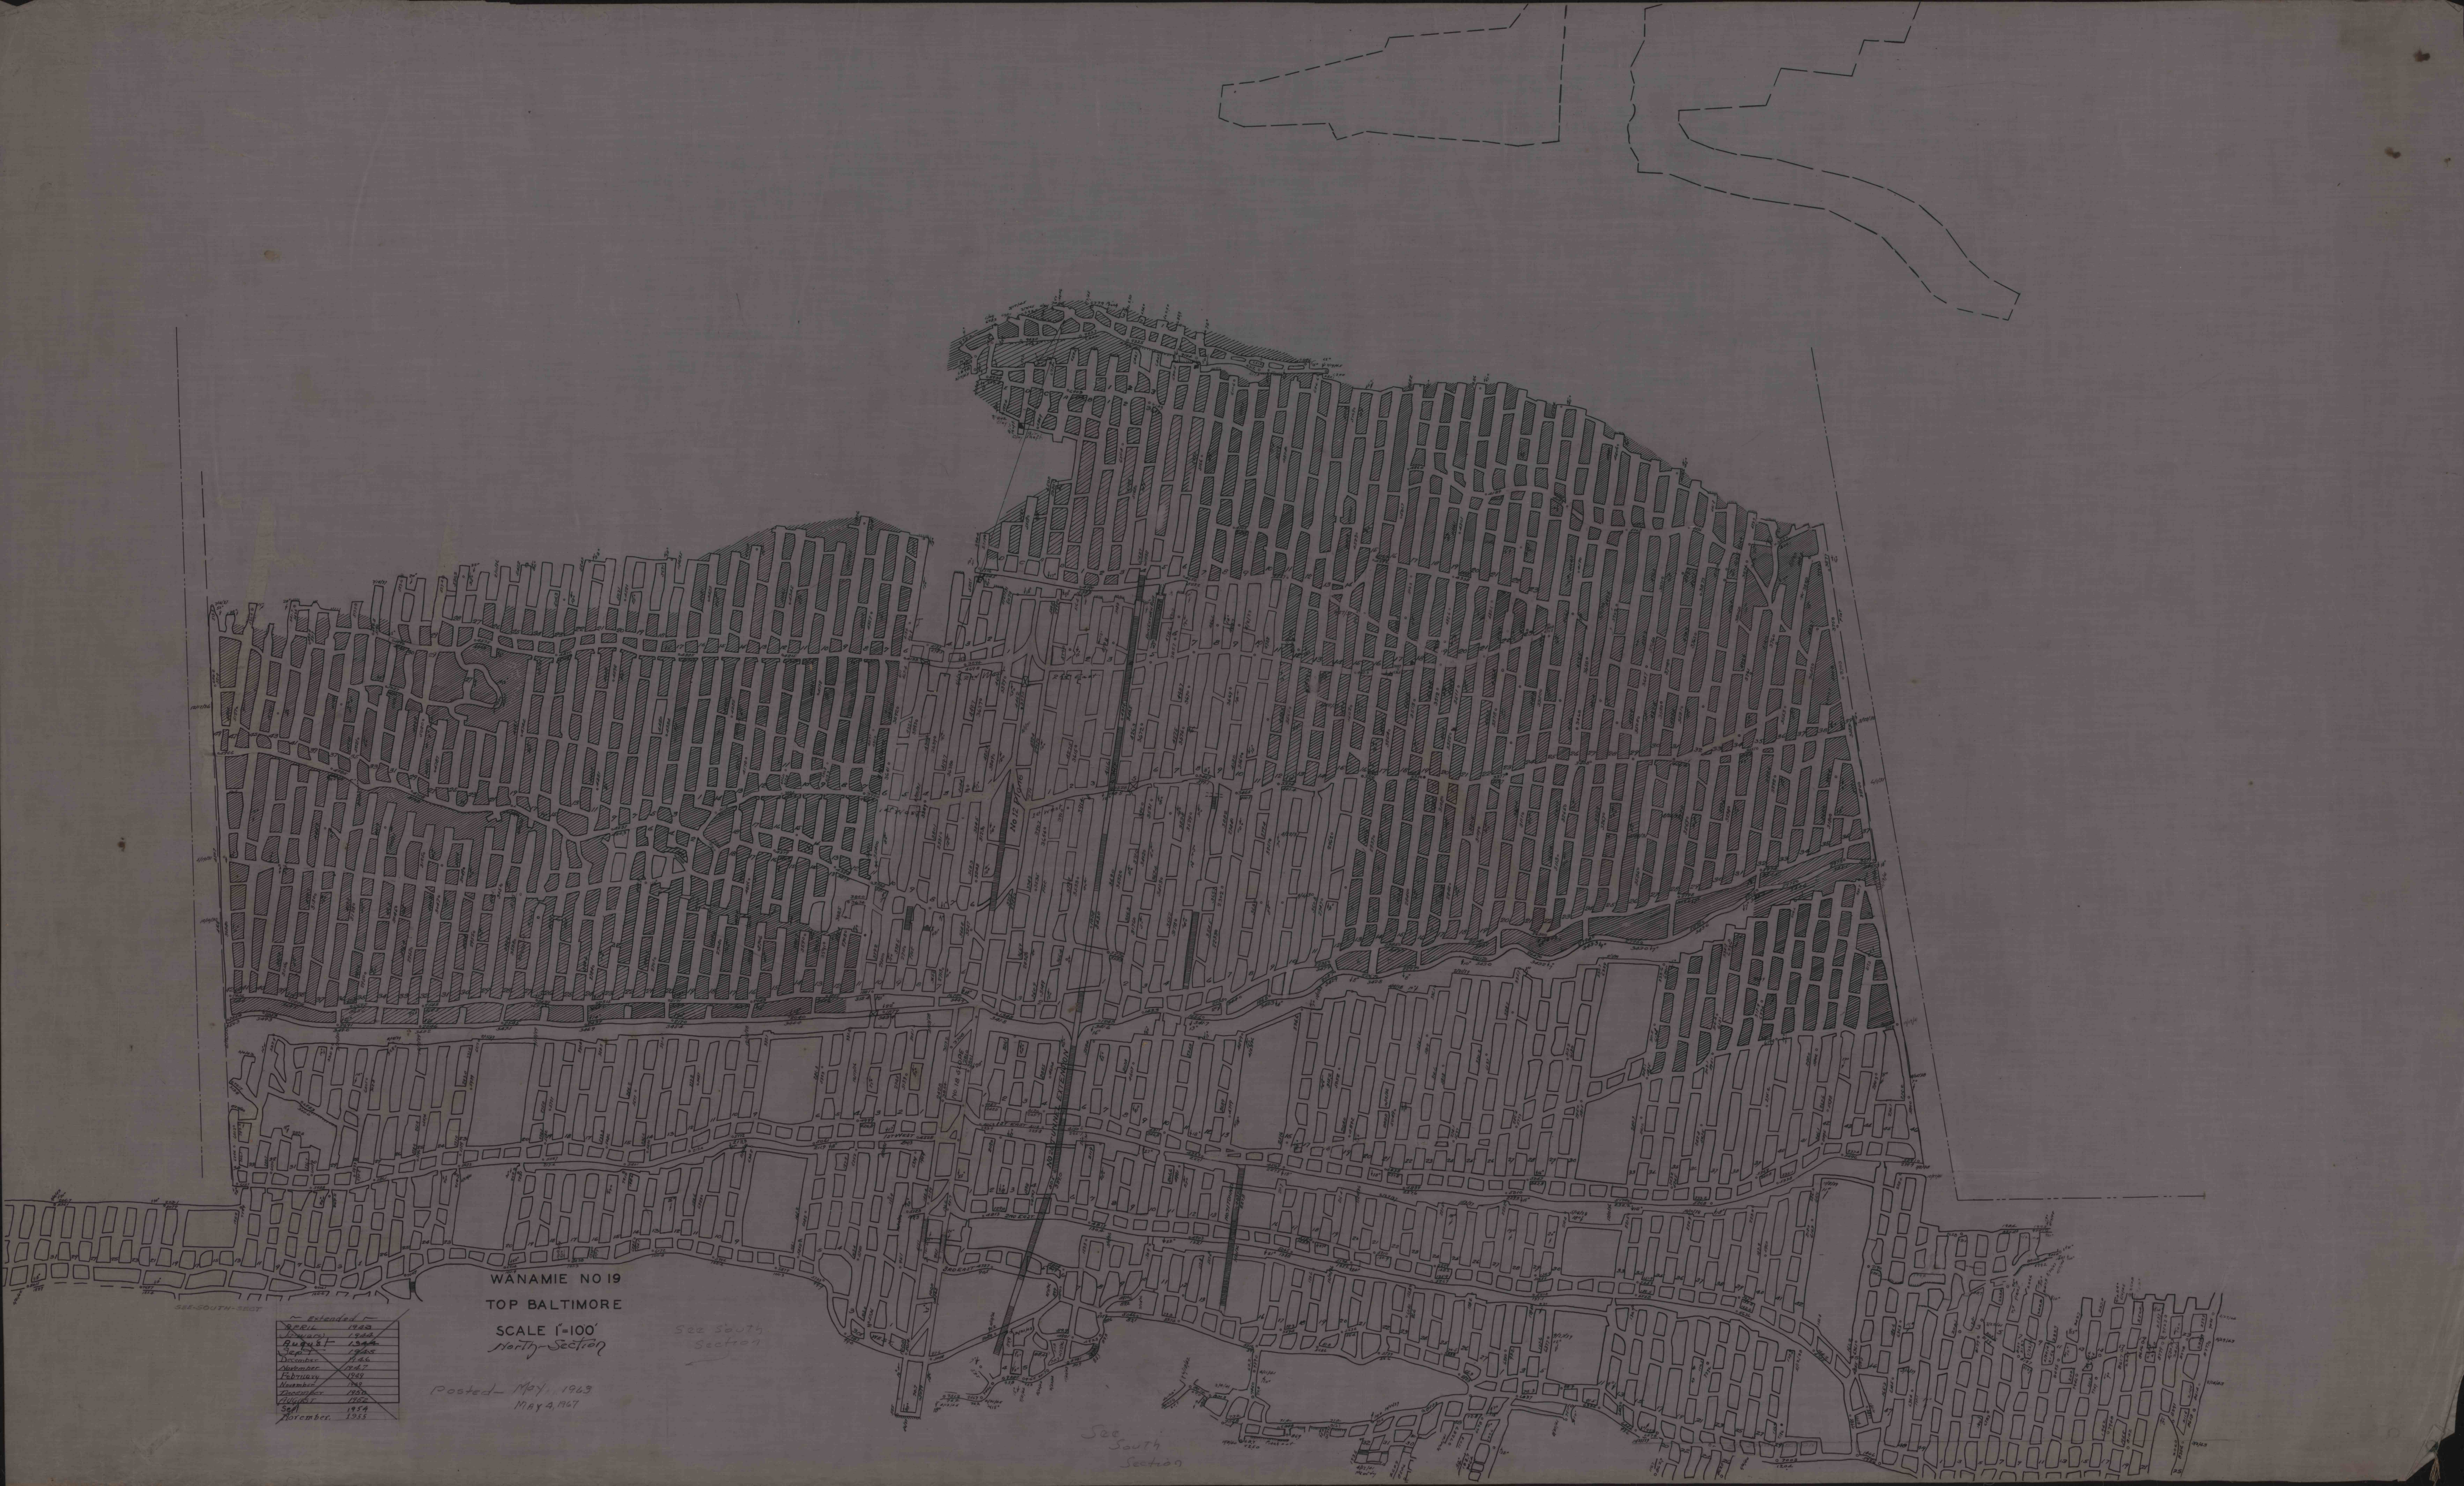

WANAMIE NO 19
TOP BALTIMORE

SCALE 1"=100'
North Section

Posted May 1, 1903
MAY 2, 1907

Extended	
April	1903
May	1903
June	1903
July	1903
August	1903
September	1903
October	1903
November	1903
December	1903
January	1904
February	1904
March	1904
April	1904
May	1904
June	1904
July	1904
August	1904
September	1904
October	1904
November	1904
December	1904