



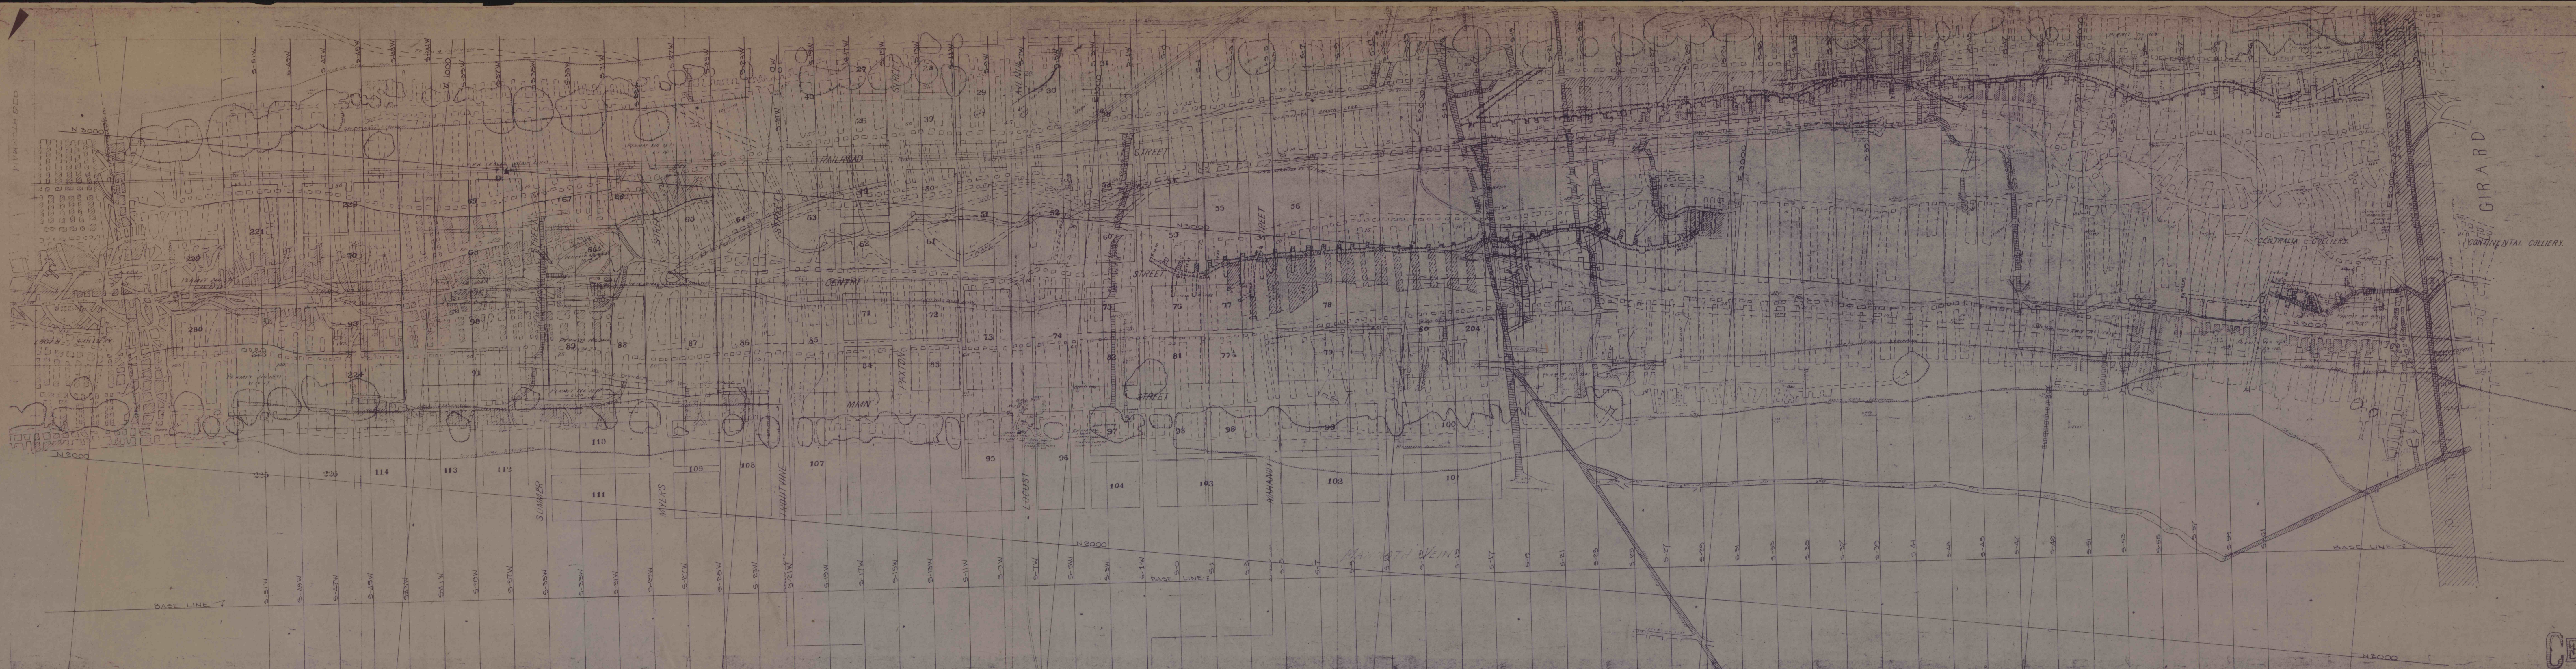

MAMMOTH
— of —
CENTRALIA

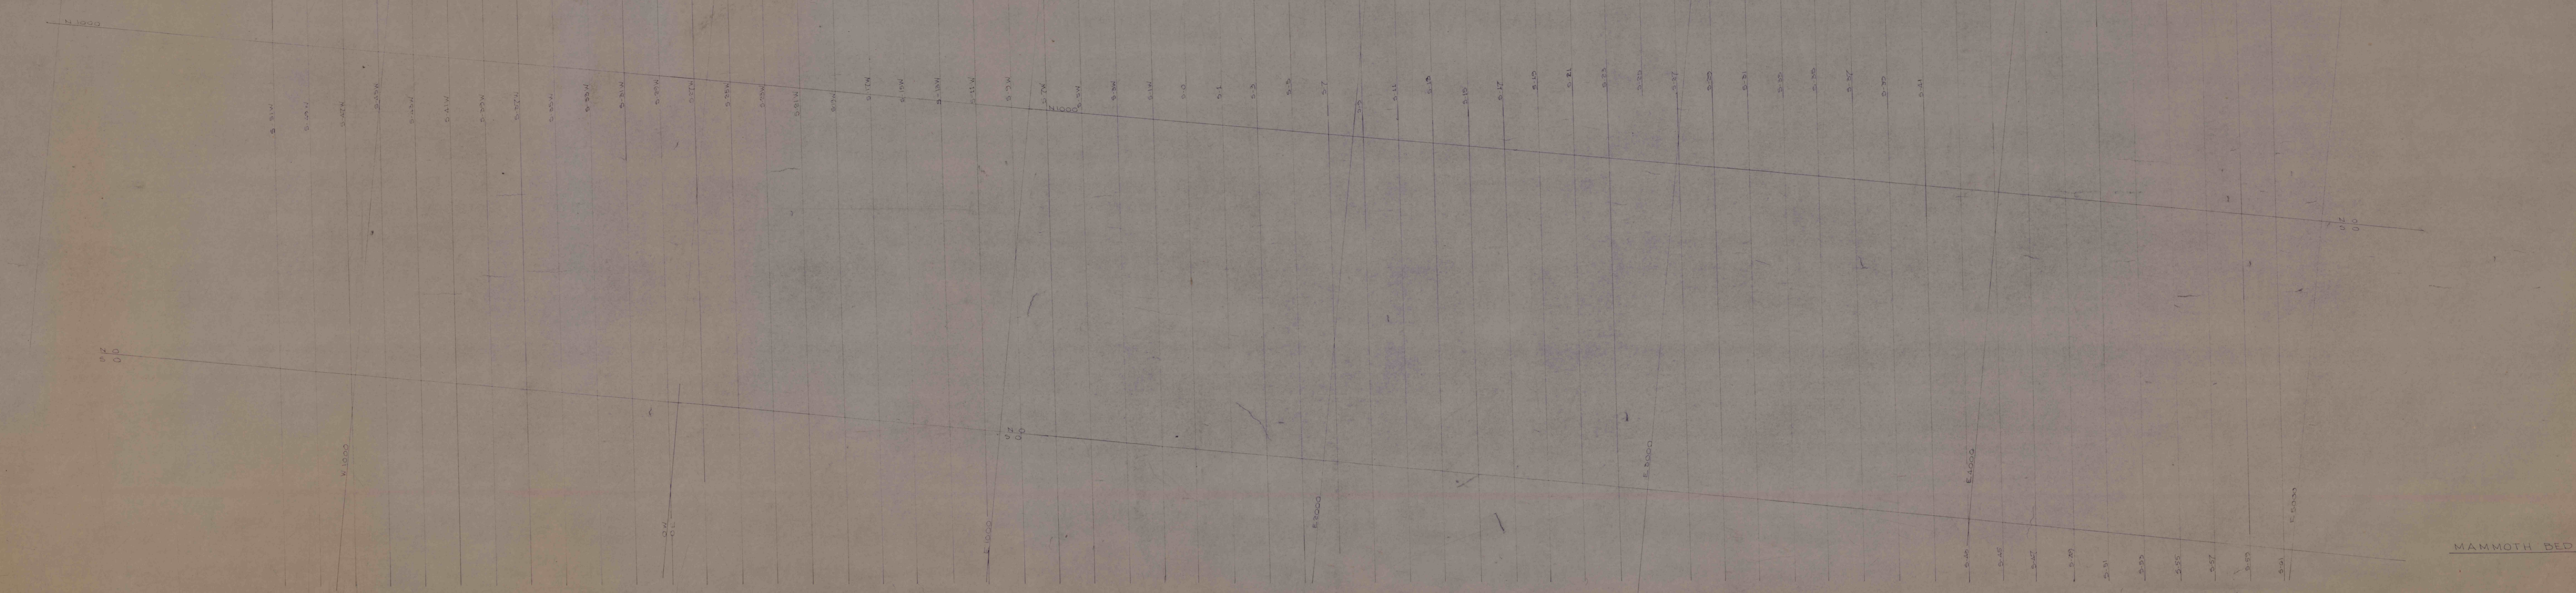

MAMMOTH BED