


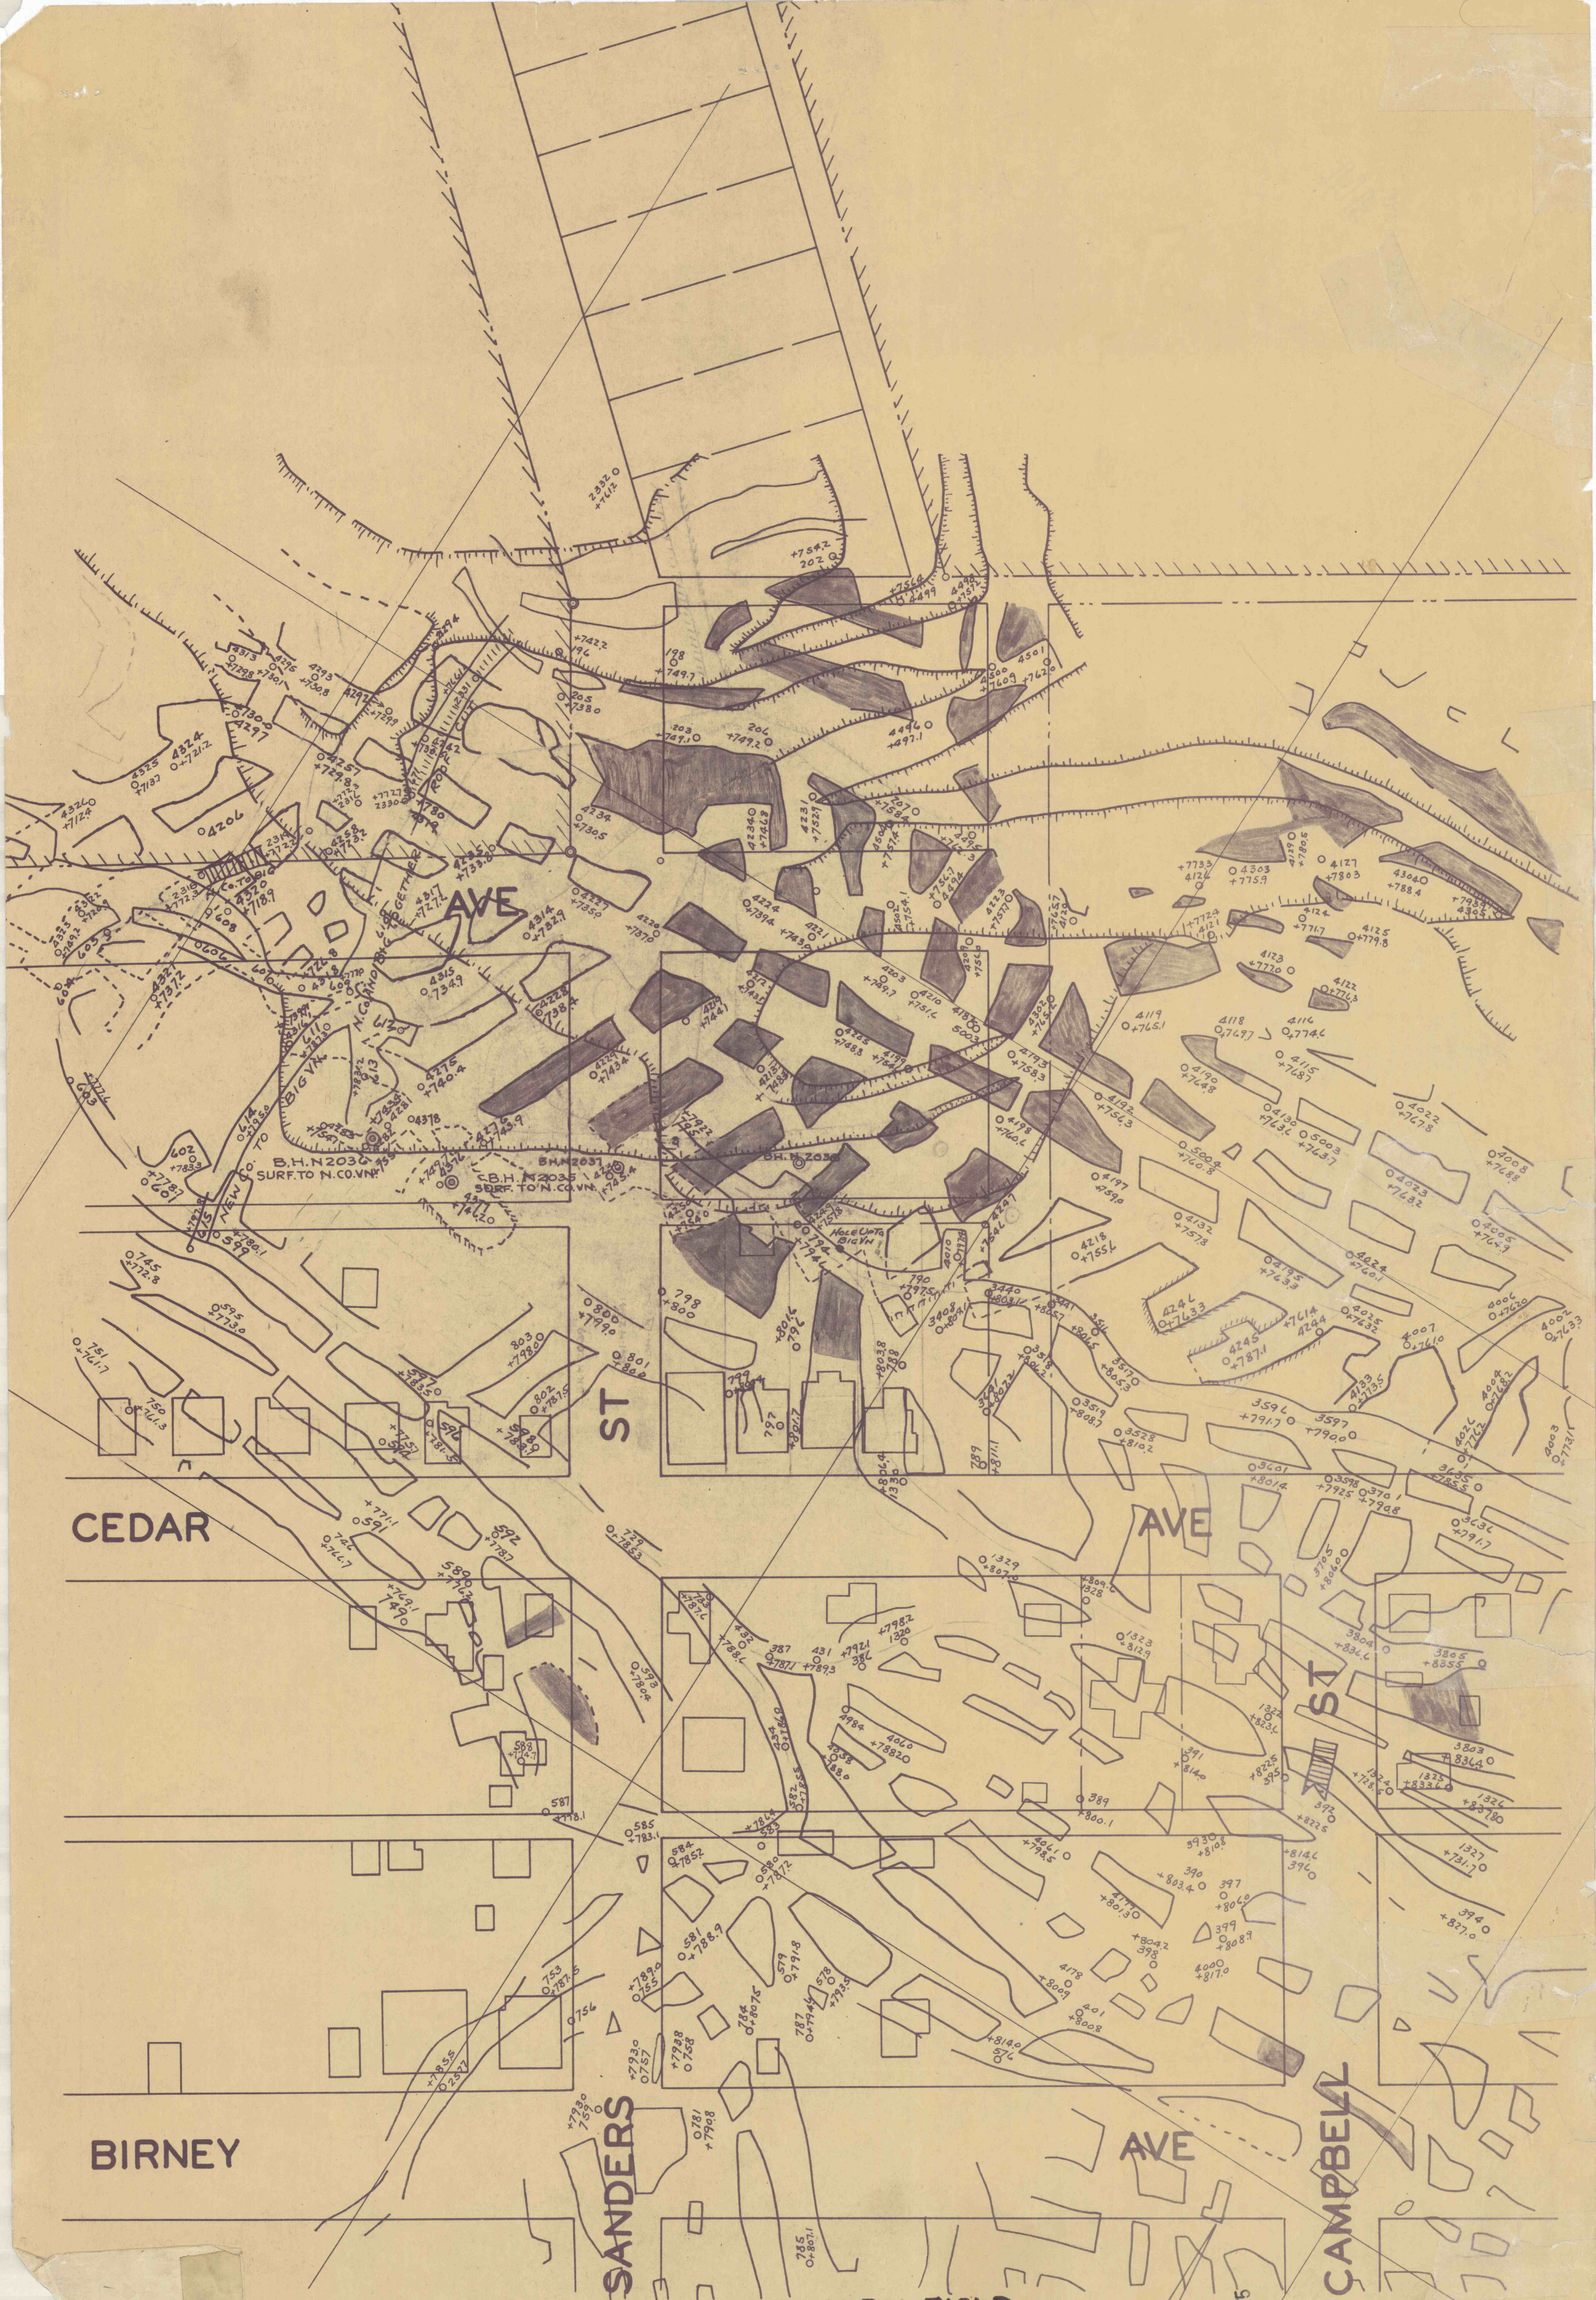

NORTHERN FIELD...
NATIONAL COLLY...
NEW CO. VEIN...
CEDAR AVE. FIRE

SCALE 1" = 50'

MF

MAY 9 1975

3063

CARBONDALE TWP.
LACKAWANNA
COUNTY, PA..