


LANCE COLLY
RED ASH SHAFT

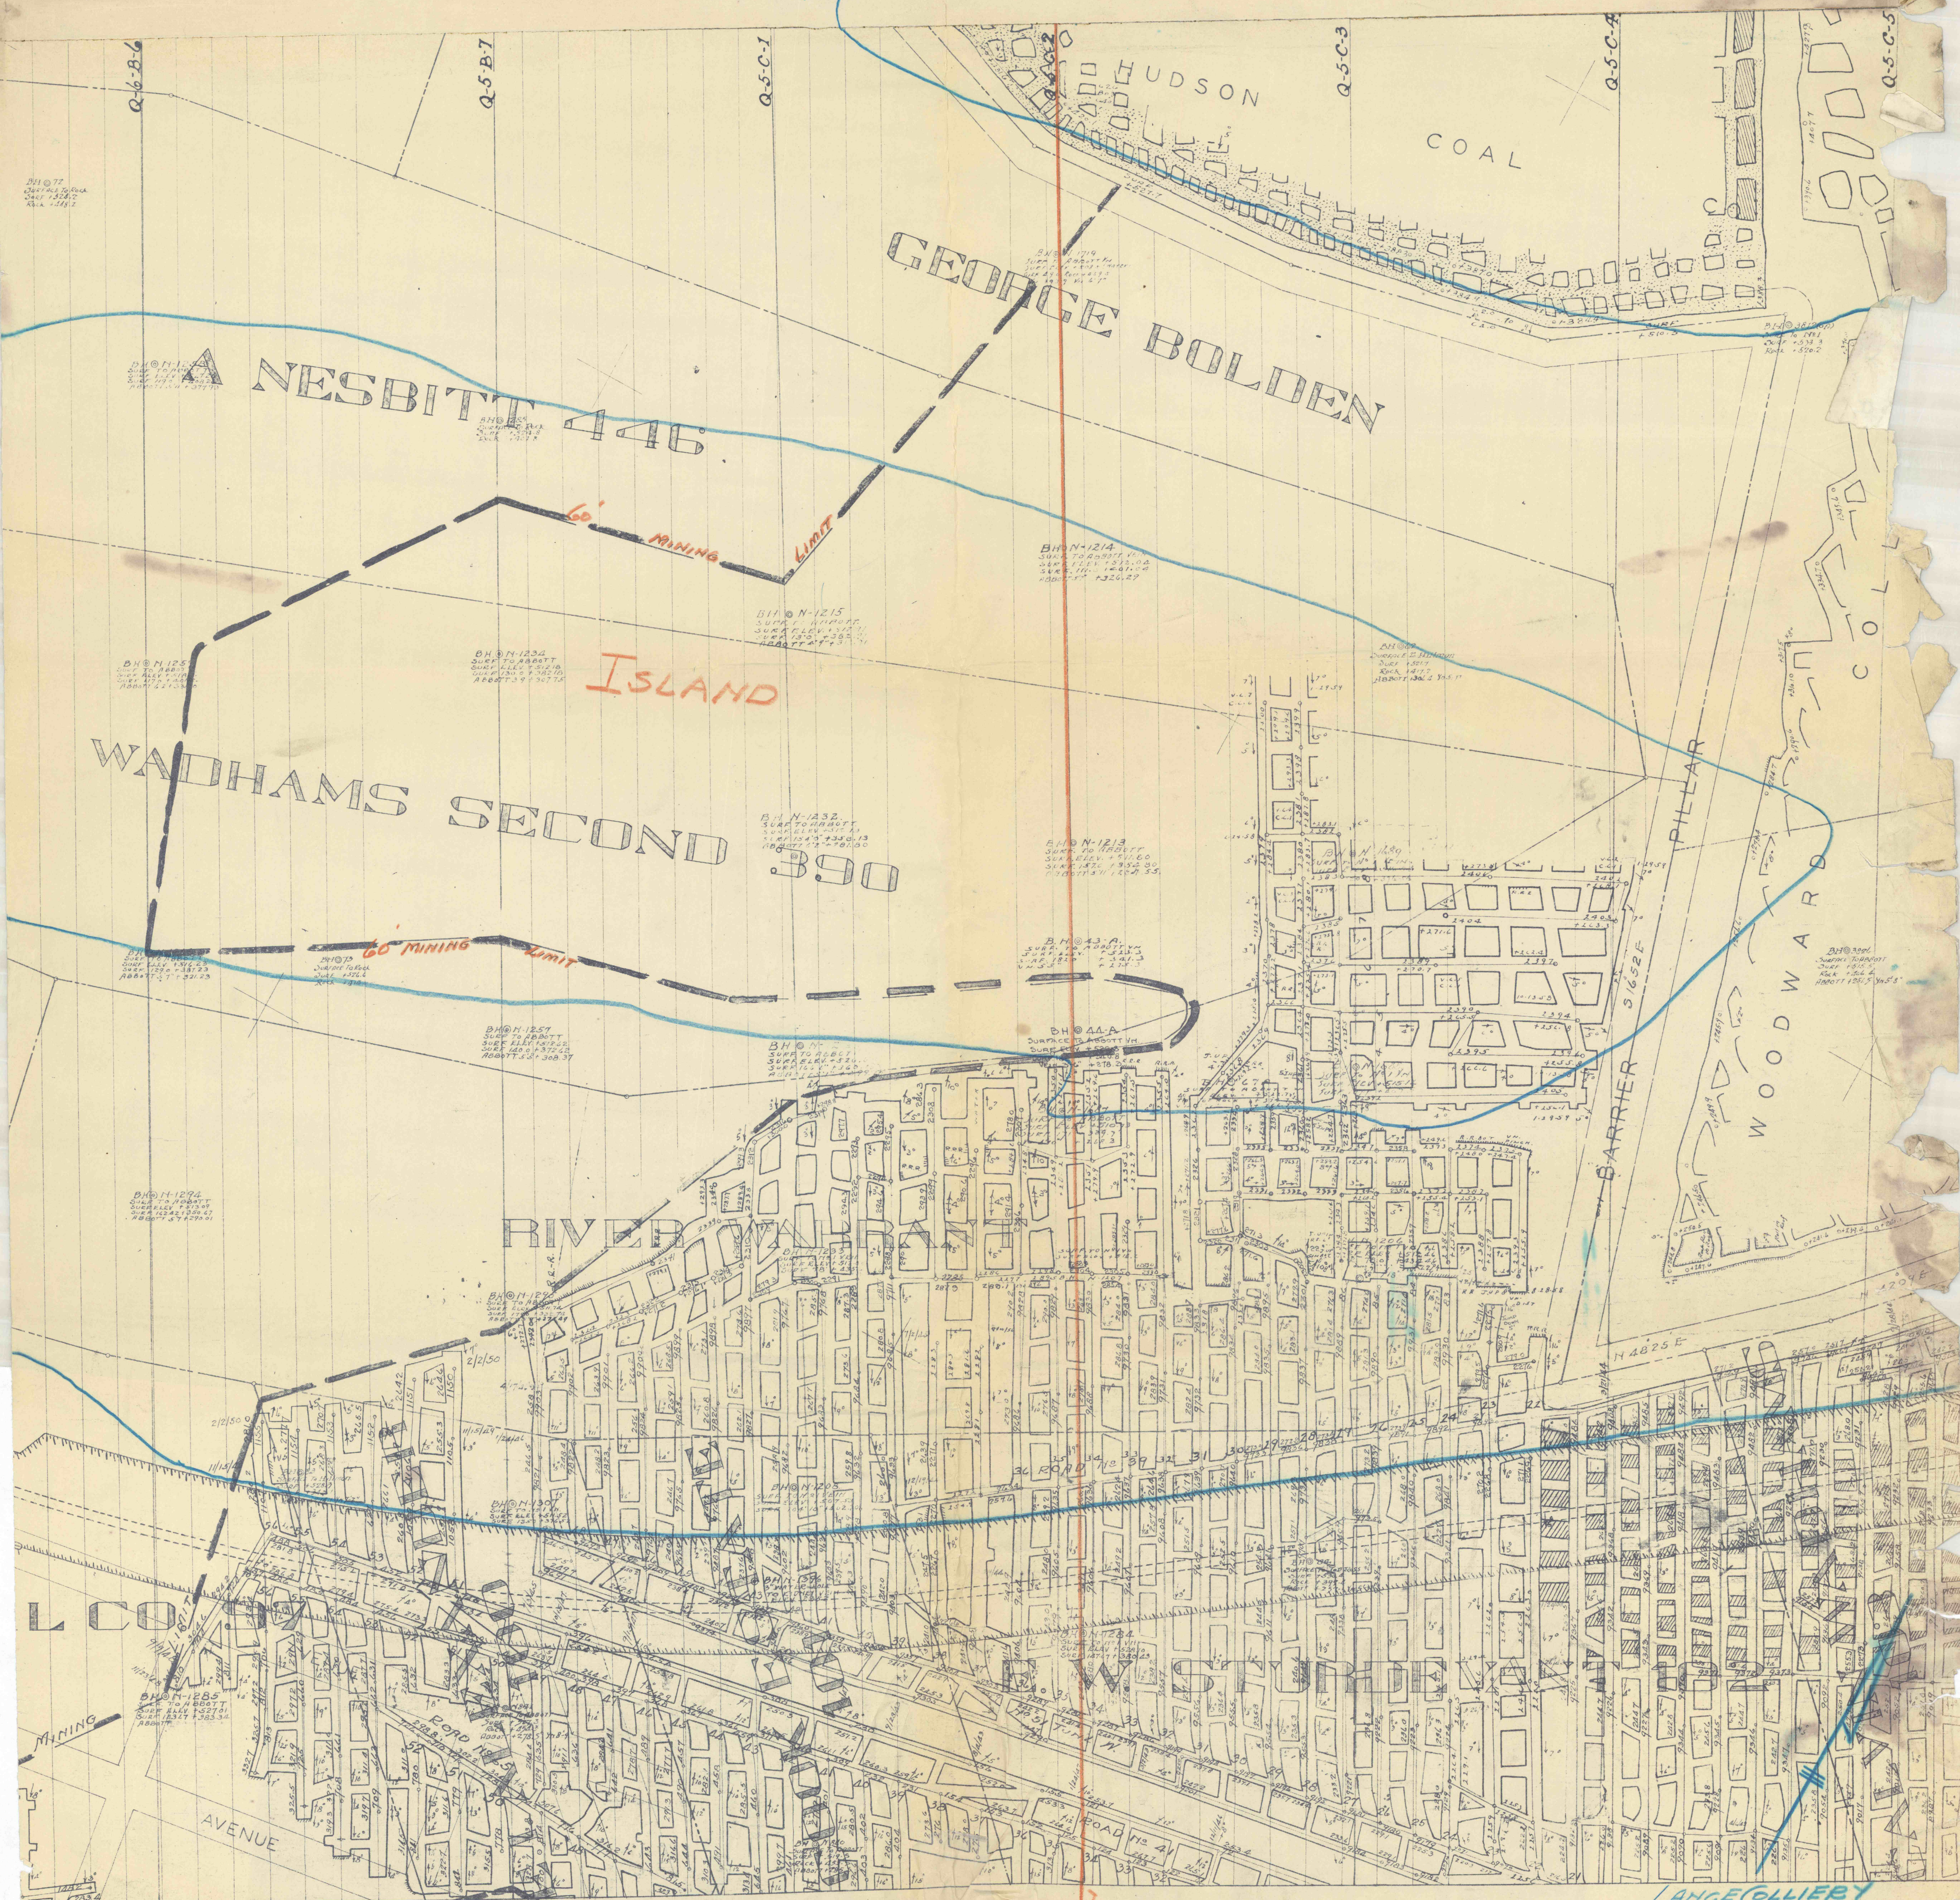

LANCE COLLIER
ABBOTT VEIN
SCALE 1"=100' FEB. 16, 1959