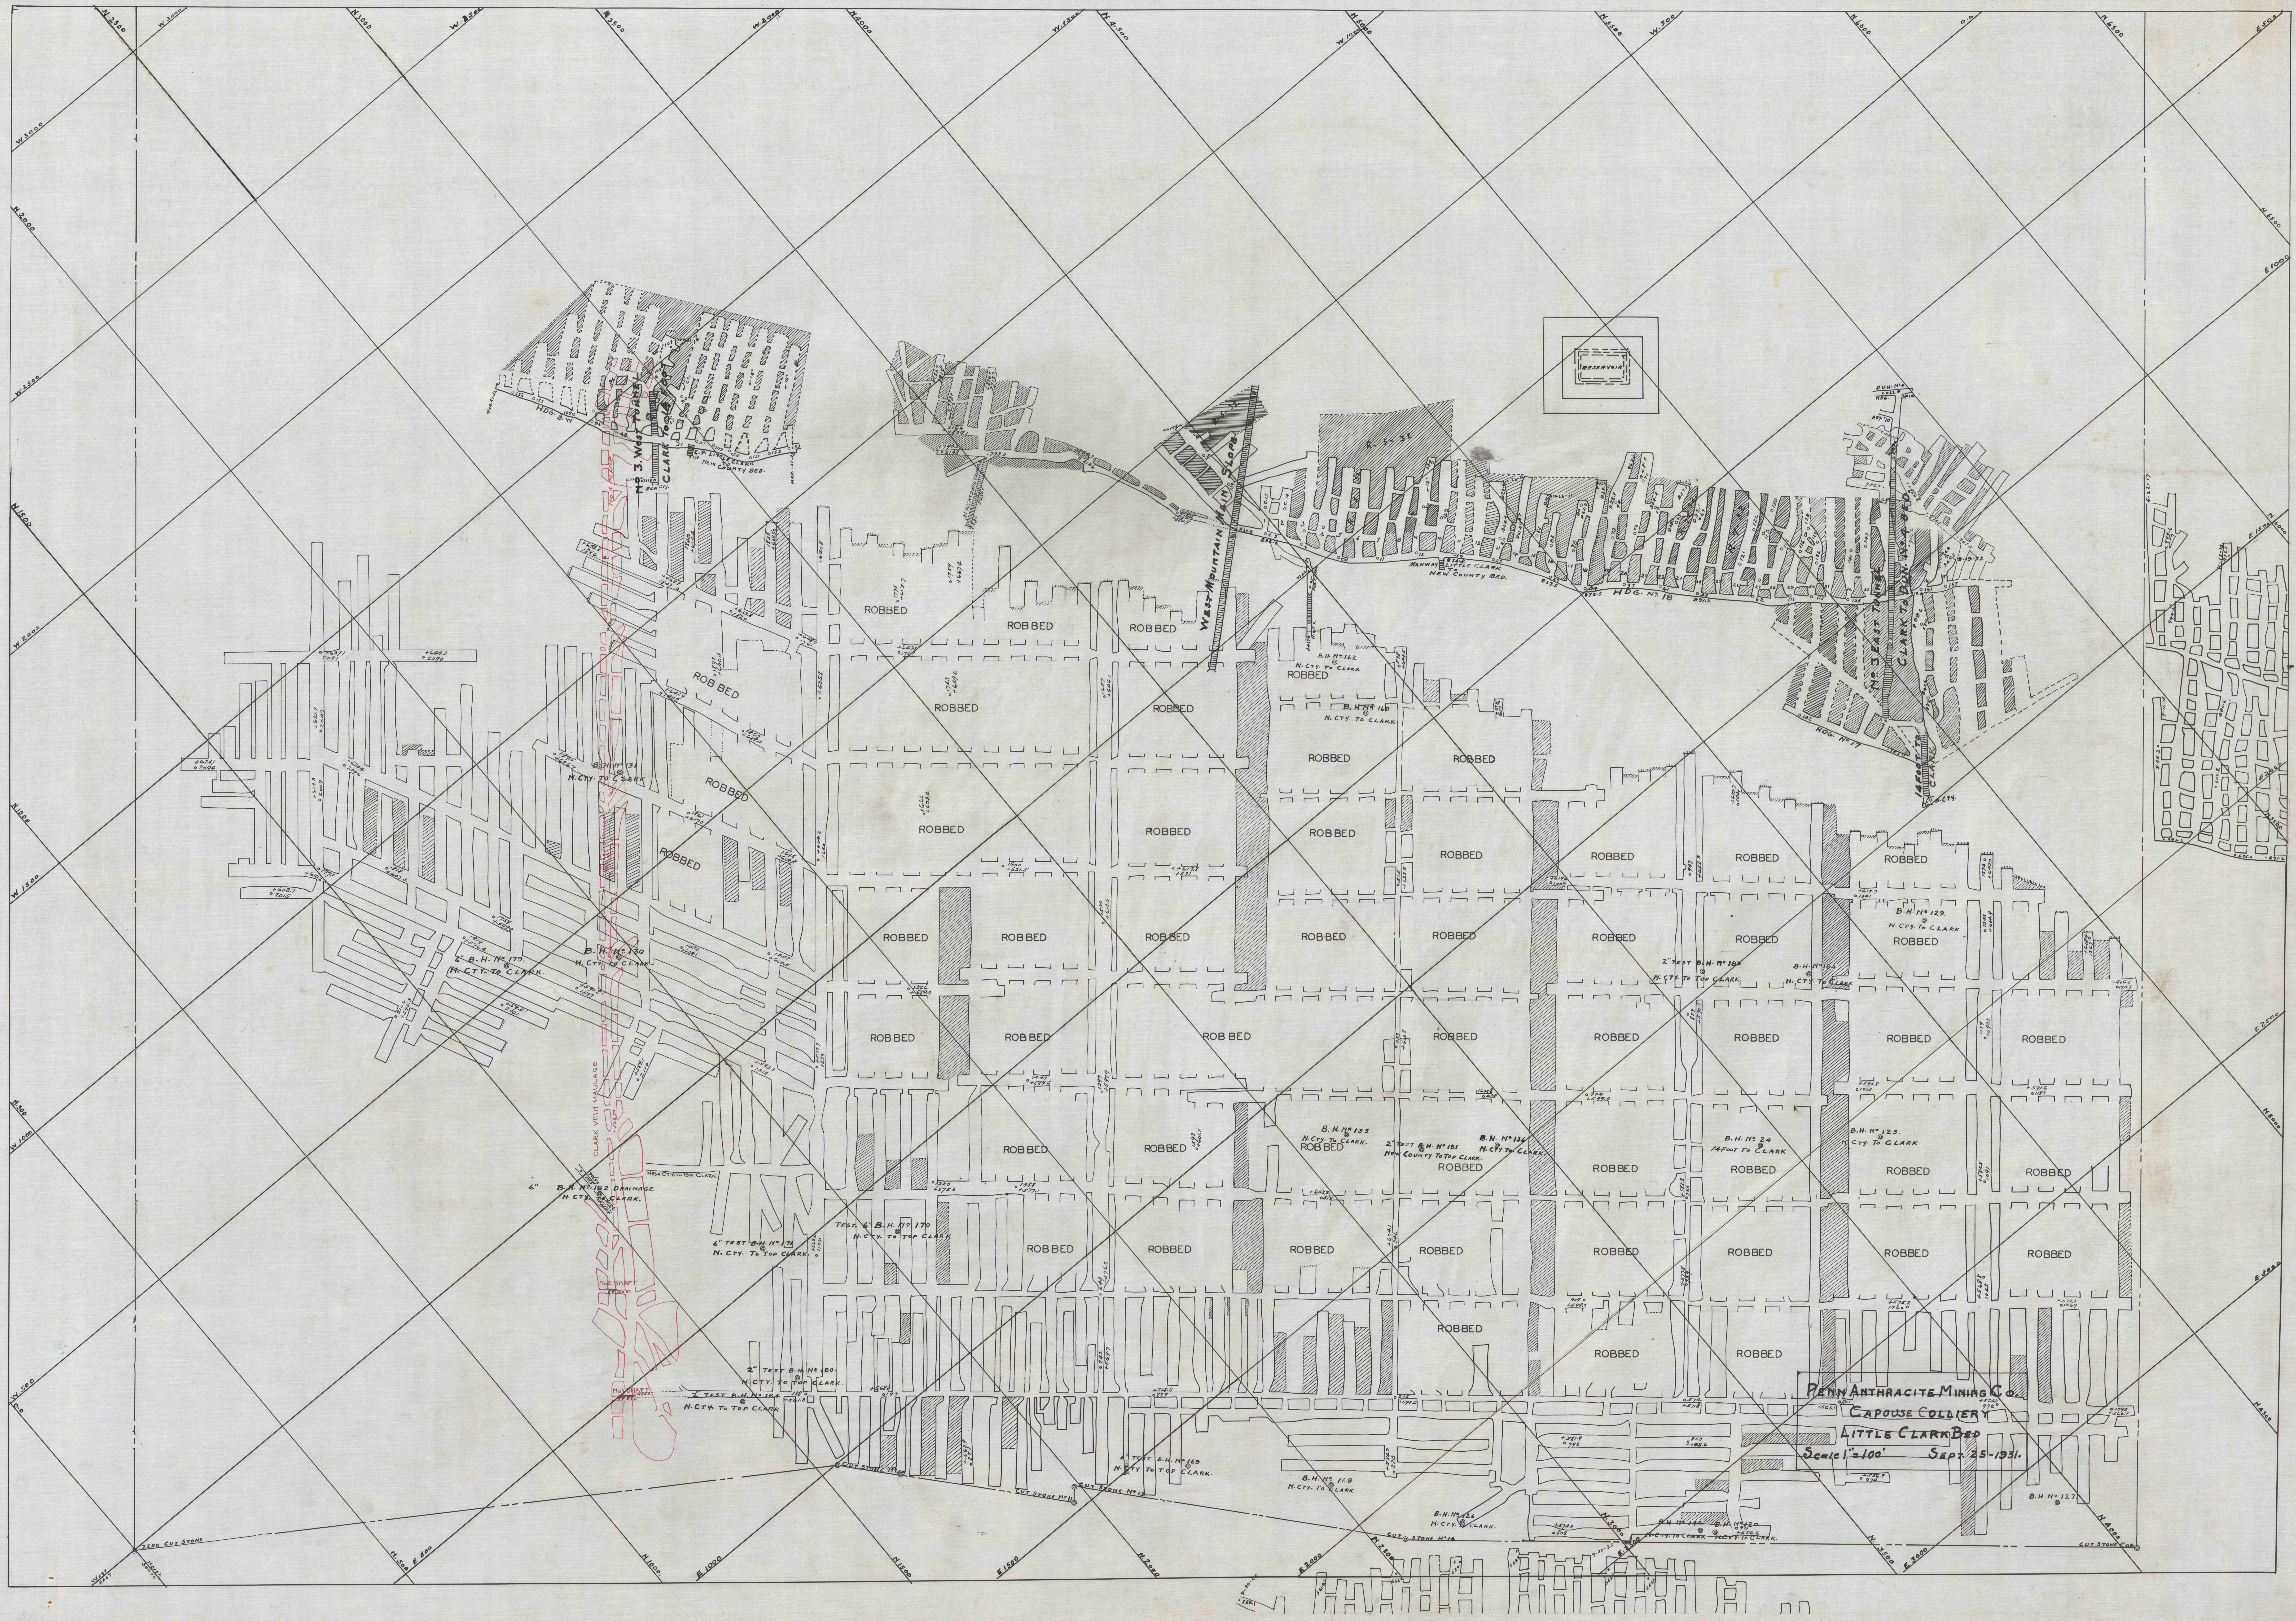
ROBBED
WEST MOUNTAIN MAIN SLOPE
No. 3 West Tunnel
Clark to 14 Foot
HDG. 8 W.
C.P. Little Clark to New County Bed.
No. 4 Plane
New Cty.
No. 3 East Tunnel
Clark to Dun. No. 4 Bed
14 Foot to Clark.
HDG. No 16
HDG. No 17
Manway Little Clark to New County Bed.
DUN. No 4 HDG.
Reservoir
Clark Vein Manway
B.H. No 131 N. Cty. to Clark
B.H. No 130 N. Cty. to Clark
B.H. No 179 N. Cty. to Clark
B.H. No 162 N. Cty. to Clark
B.H. No 160 N. Cty. to Clark
B.H. No 129 N. Cty. to Clark
2" Test B.H. No 103 N. Cty. to Top Clark
B.H. No 164 N. Cty. to Clark
B.H. No 133 N. Cty. to Clark
2" Test B.H. No 181 New County to Clark
B.H. No 134 N. Cty. to Clark
B.H. No 24 14 Foot to Clark
B.H. No 125 N. Cty. to Clark
6" B.H. No 182 Drainage N. Cty. to Clark
Test 4" B.H. No 170 N. Cty. to Top Clark
6" Test B.H. No 176 N. Cty. to Top Clark
2" Test B.H. No 180 N. Cty. to Top Clark
2" Test B.H. No 184 N. Cty. to Top Clark
2" Test B.H. No 169 N. Cty. to Top Clark
B.H. No 168 N. Cty. to Clark
B.H. No 126 N. Cty. to Clark
B.H. No 120 N. Cty. to Clark
B.H. No 127.
Cut Stone
Cut Stone No 12
Cut Stone No 14
Mar. 21-32
Nov. 21-31
9-19-32
N 500
N 1000
N 1500
N 2000
N 2500
N 3000
N 3500
N 4000
N 4500
N 5000
N 5500
N 6000
N 6500
E 500
E 1000
E 1500
E 2000
E 2500
E 3000
W 500
W 1000
W 1500
W 2000
W 2500
W 3000

Penn Anthracite Mining Co.

Capouse Colliery

Little Clark Bed

Scale 1" = 100'   Sept. 25-1931.

Little Clark 40
Capouse