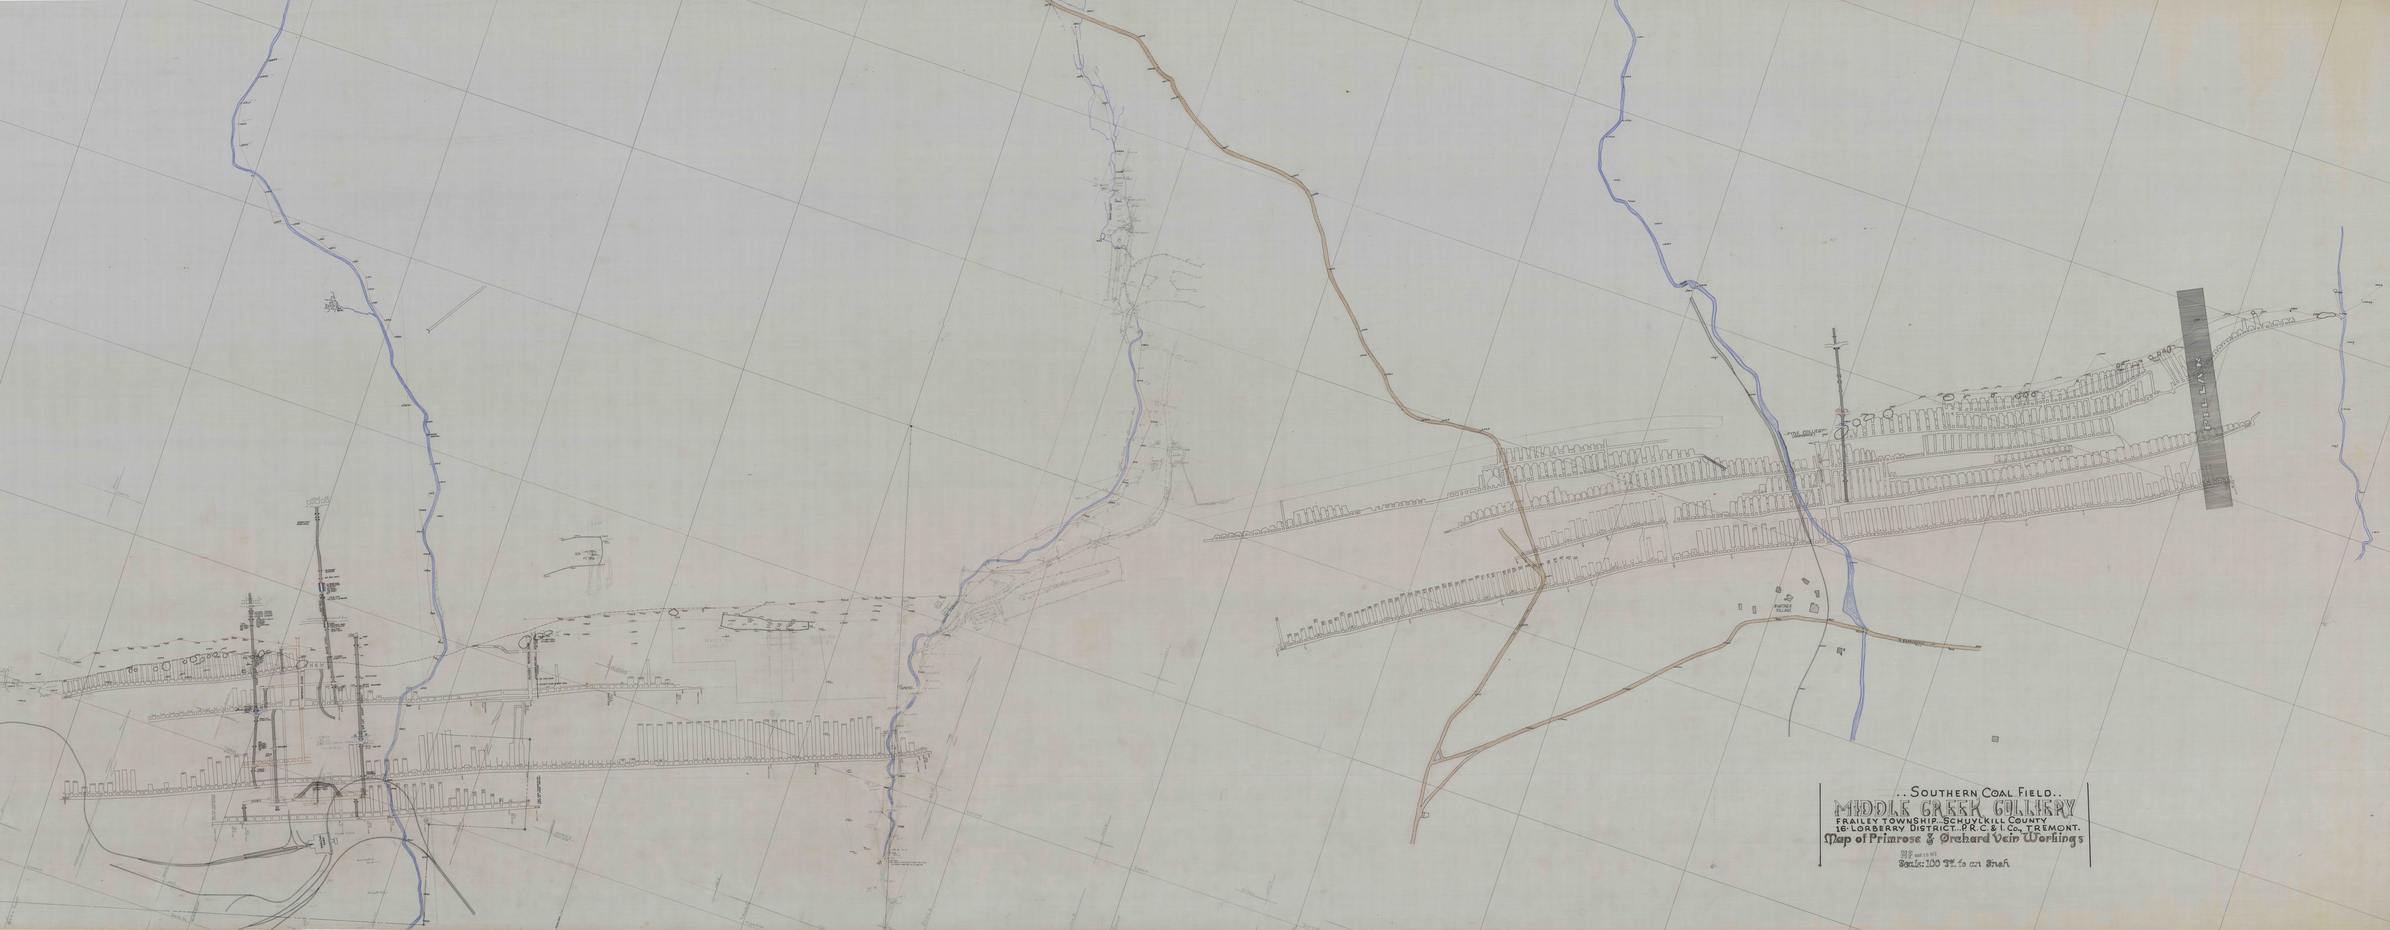


..Southern Coal Field..

MIDDLE CREEK COLLIERY

FRAILEY TOWNSHIP, SCHUYLKILL COUNTY

16 LORBERRY DISTRICT, P.R.C. & I. Co., TREMONT.

Map of Primrose & Orchard Vein Workings

Scale: 100 Ft. to an Inch.