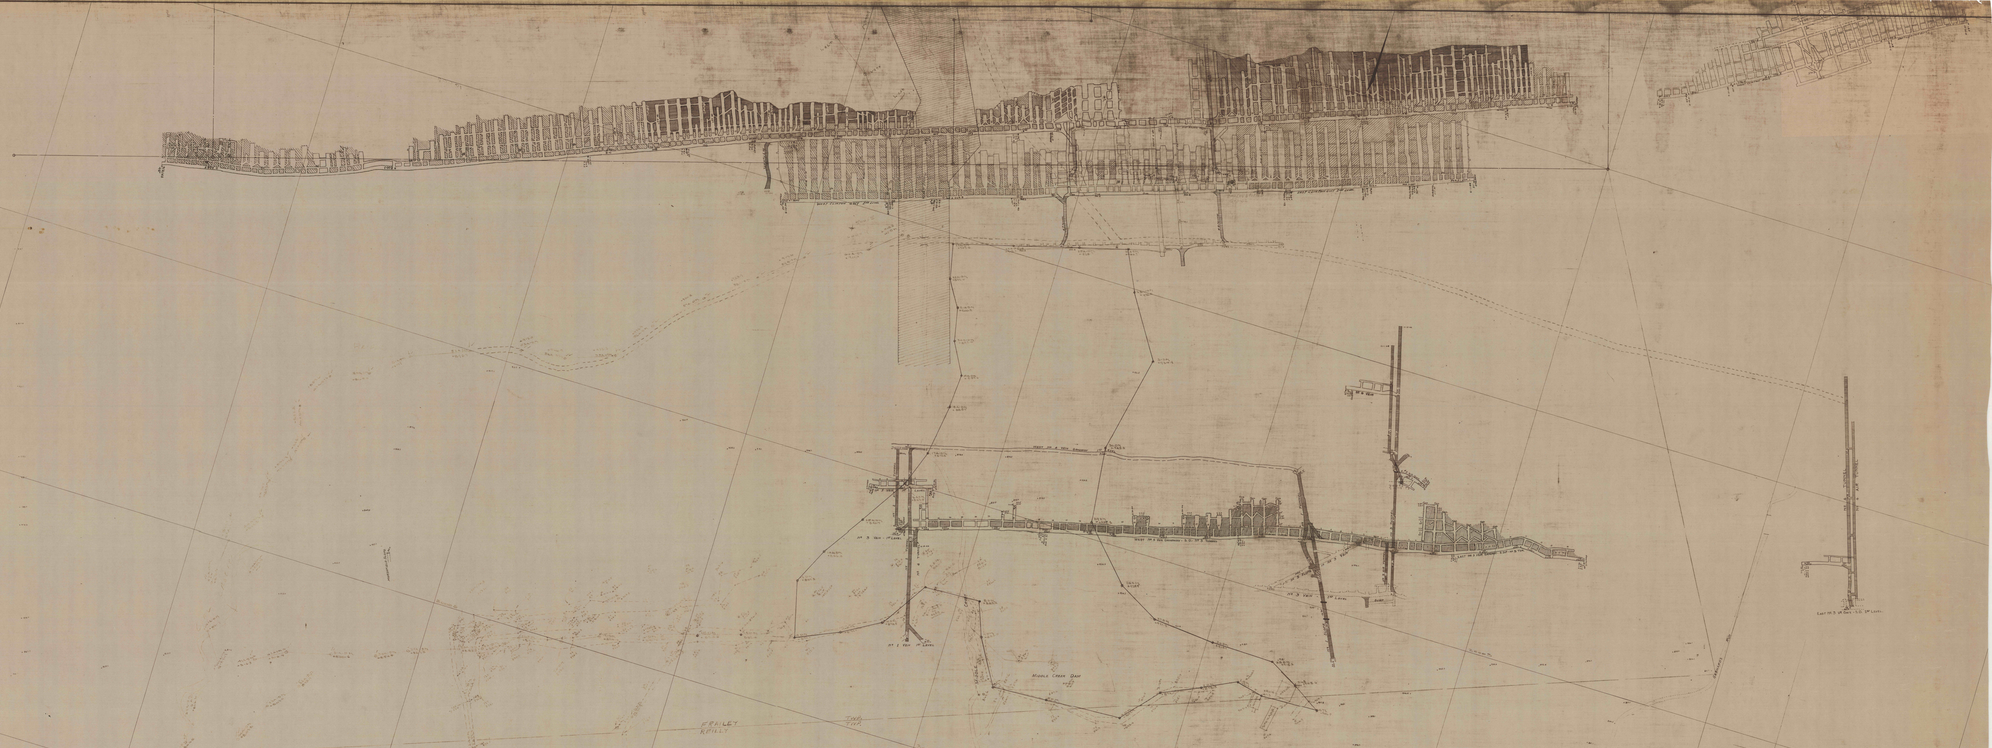


..Southern Field..

INDIAN HEAD COAL CO. Colliery..

TREMONT, PA.

No: 5 VEIN WORKINGS..FRAILEY TWP, SCHUYLKILL

... MINE INSPECTOR'S TRACING ...

... SCALE: 1"= 100 ...

DATUM - MEAN TIDE

COUNTY." Mine Drainage Pollution Control Project 1 Gebharts Creek."

REVISED TO
MAR. 28, 1945
FEB. 15, 1945
JAN. 31, 1945
MAR. 31, 1944
JAN. 31, 1944
JAN. 31, 1943
JAN. 30, 1942
JAN. 4, 1941
ANNUAL 1940