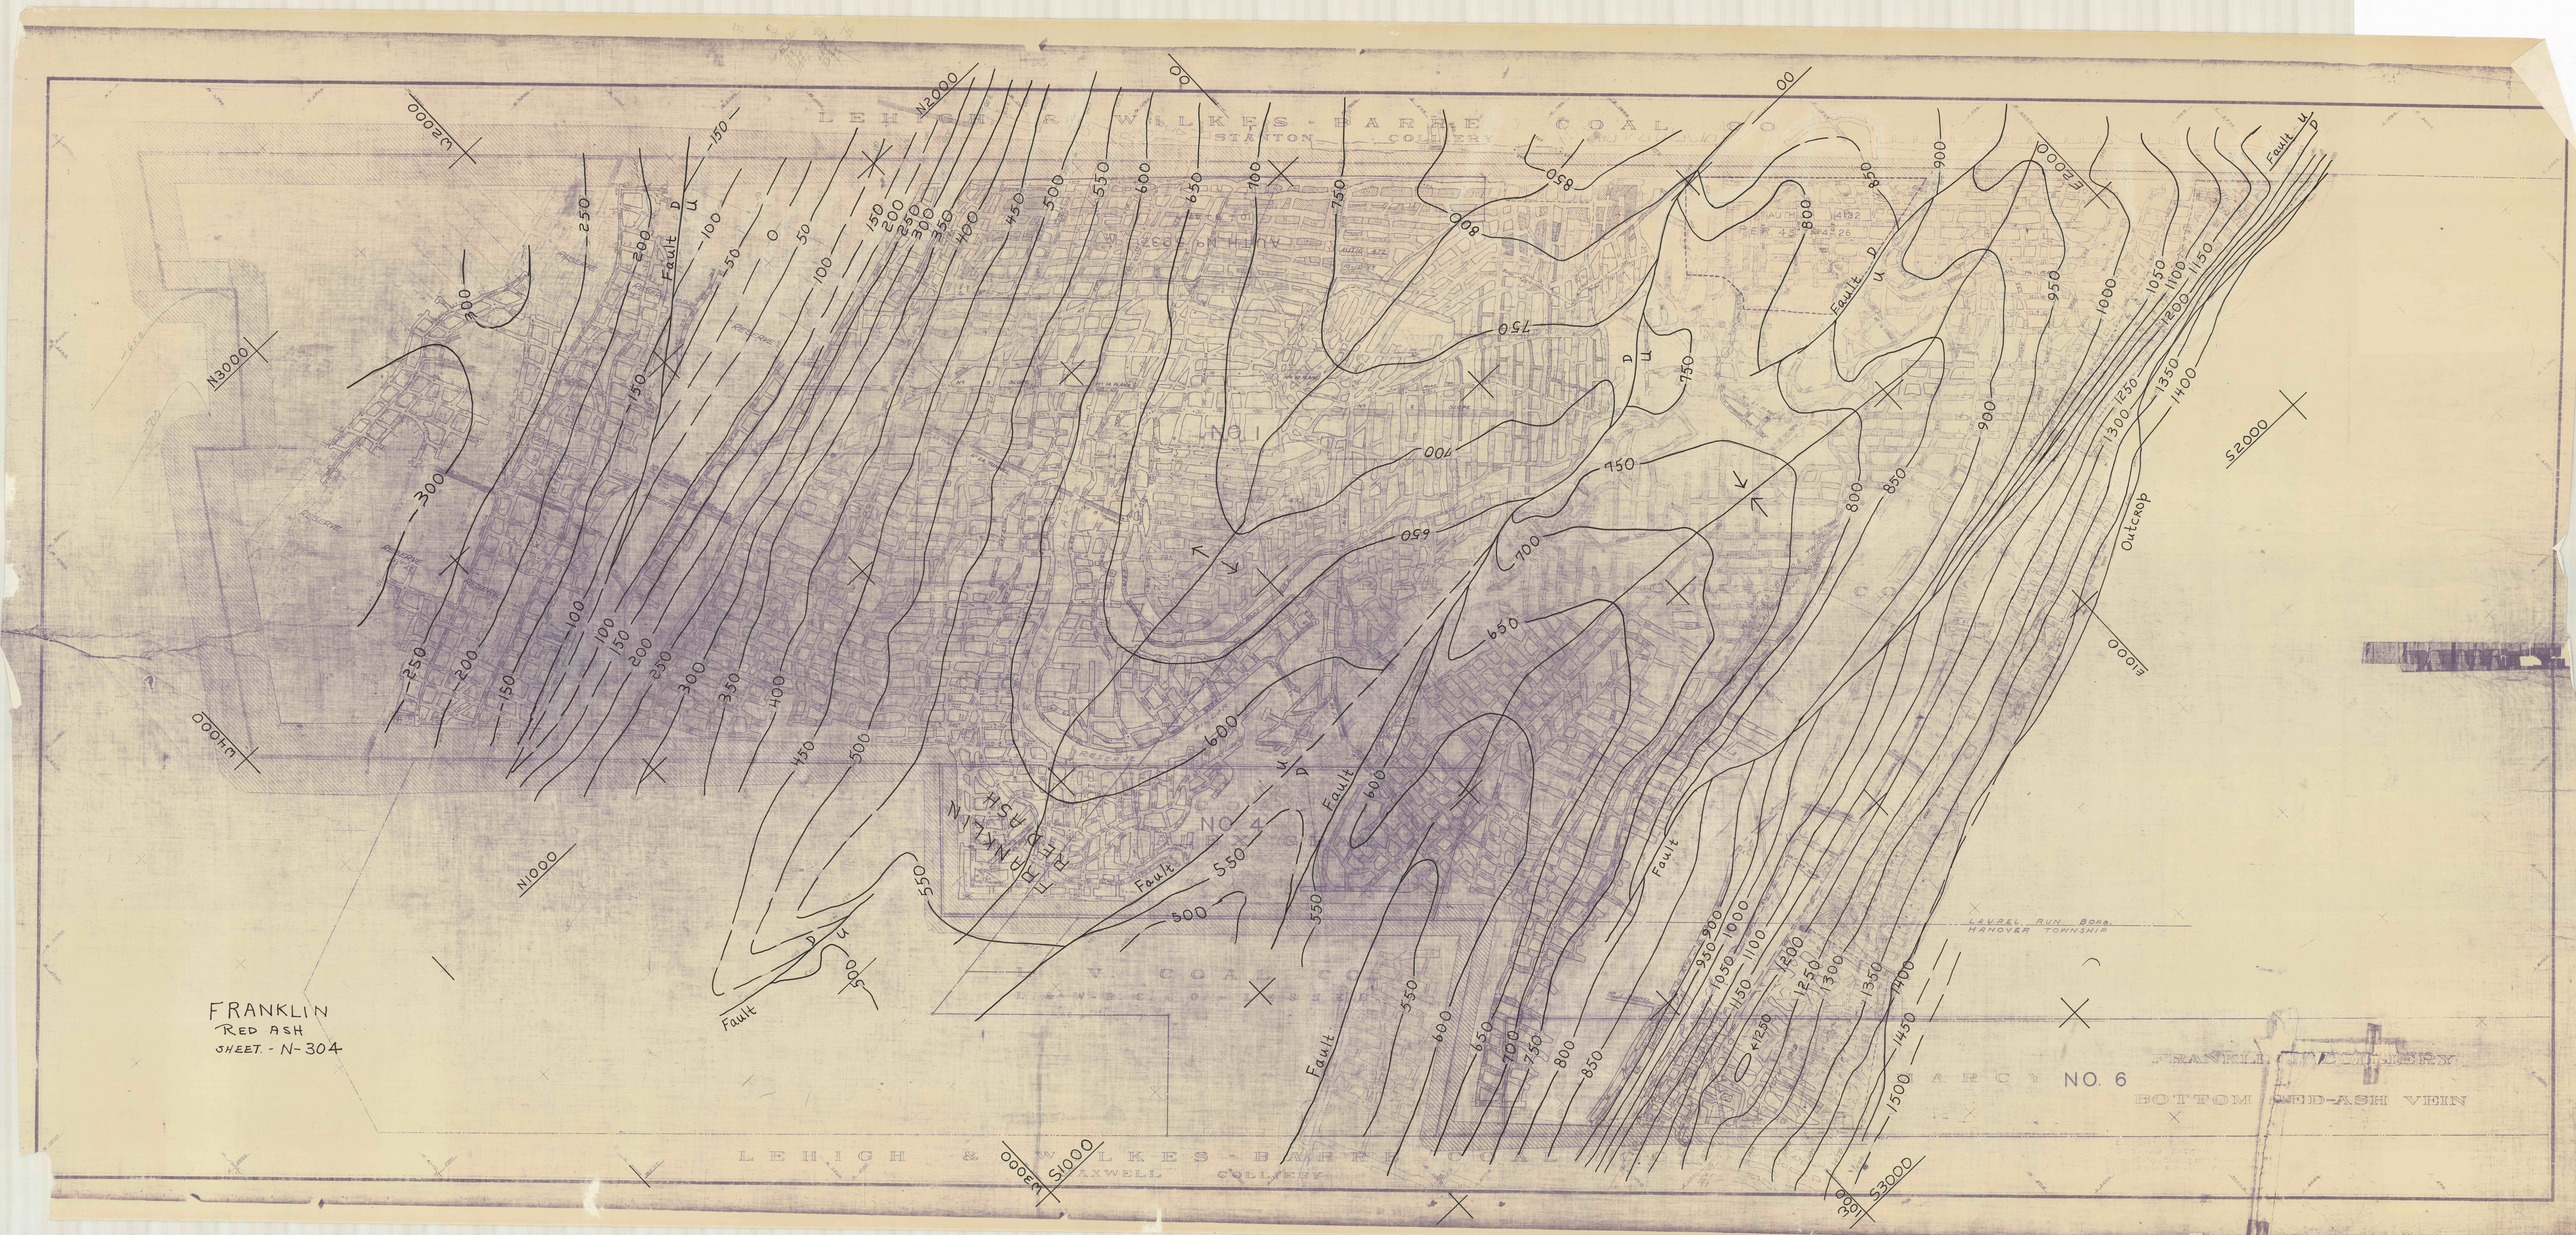

FRANKLIN
RED ASH
SHEET. - N-304
LEHIGH & WILKES-BARRE COAL CO.
STANTON COLLIERY
MAXWELL COLLIERY
FRANKLIN RED ASH
NO. 1
NO. 4
NO. 6
Fault
Outcrop
LAUREL RUN Boro.
HANOVER TOWNSHIP
FRANKLIN COLLIERY
BOTTOM RED-ASH VEIN
N2000
N3000
N1000
E2000
E1000
S2000
S3000
W1000
S1000