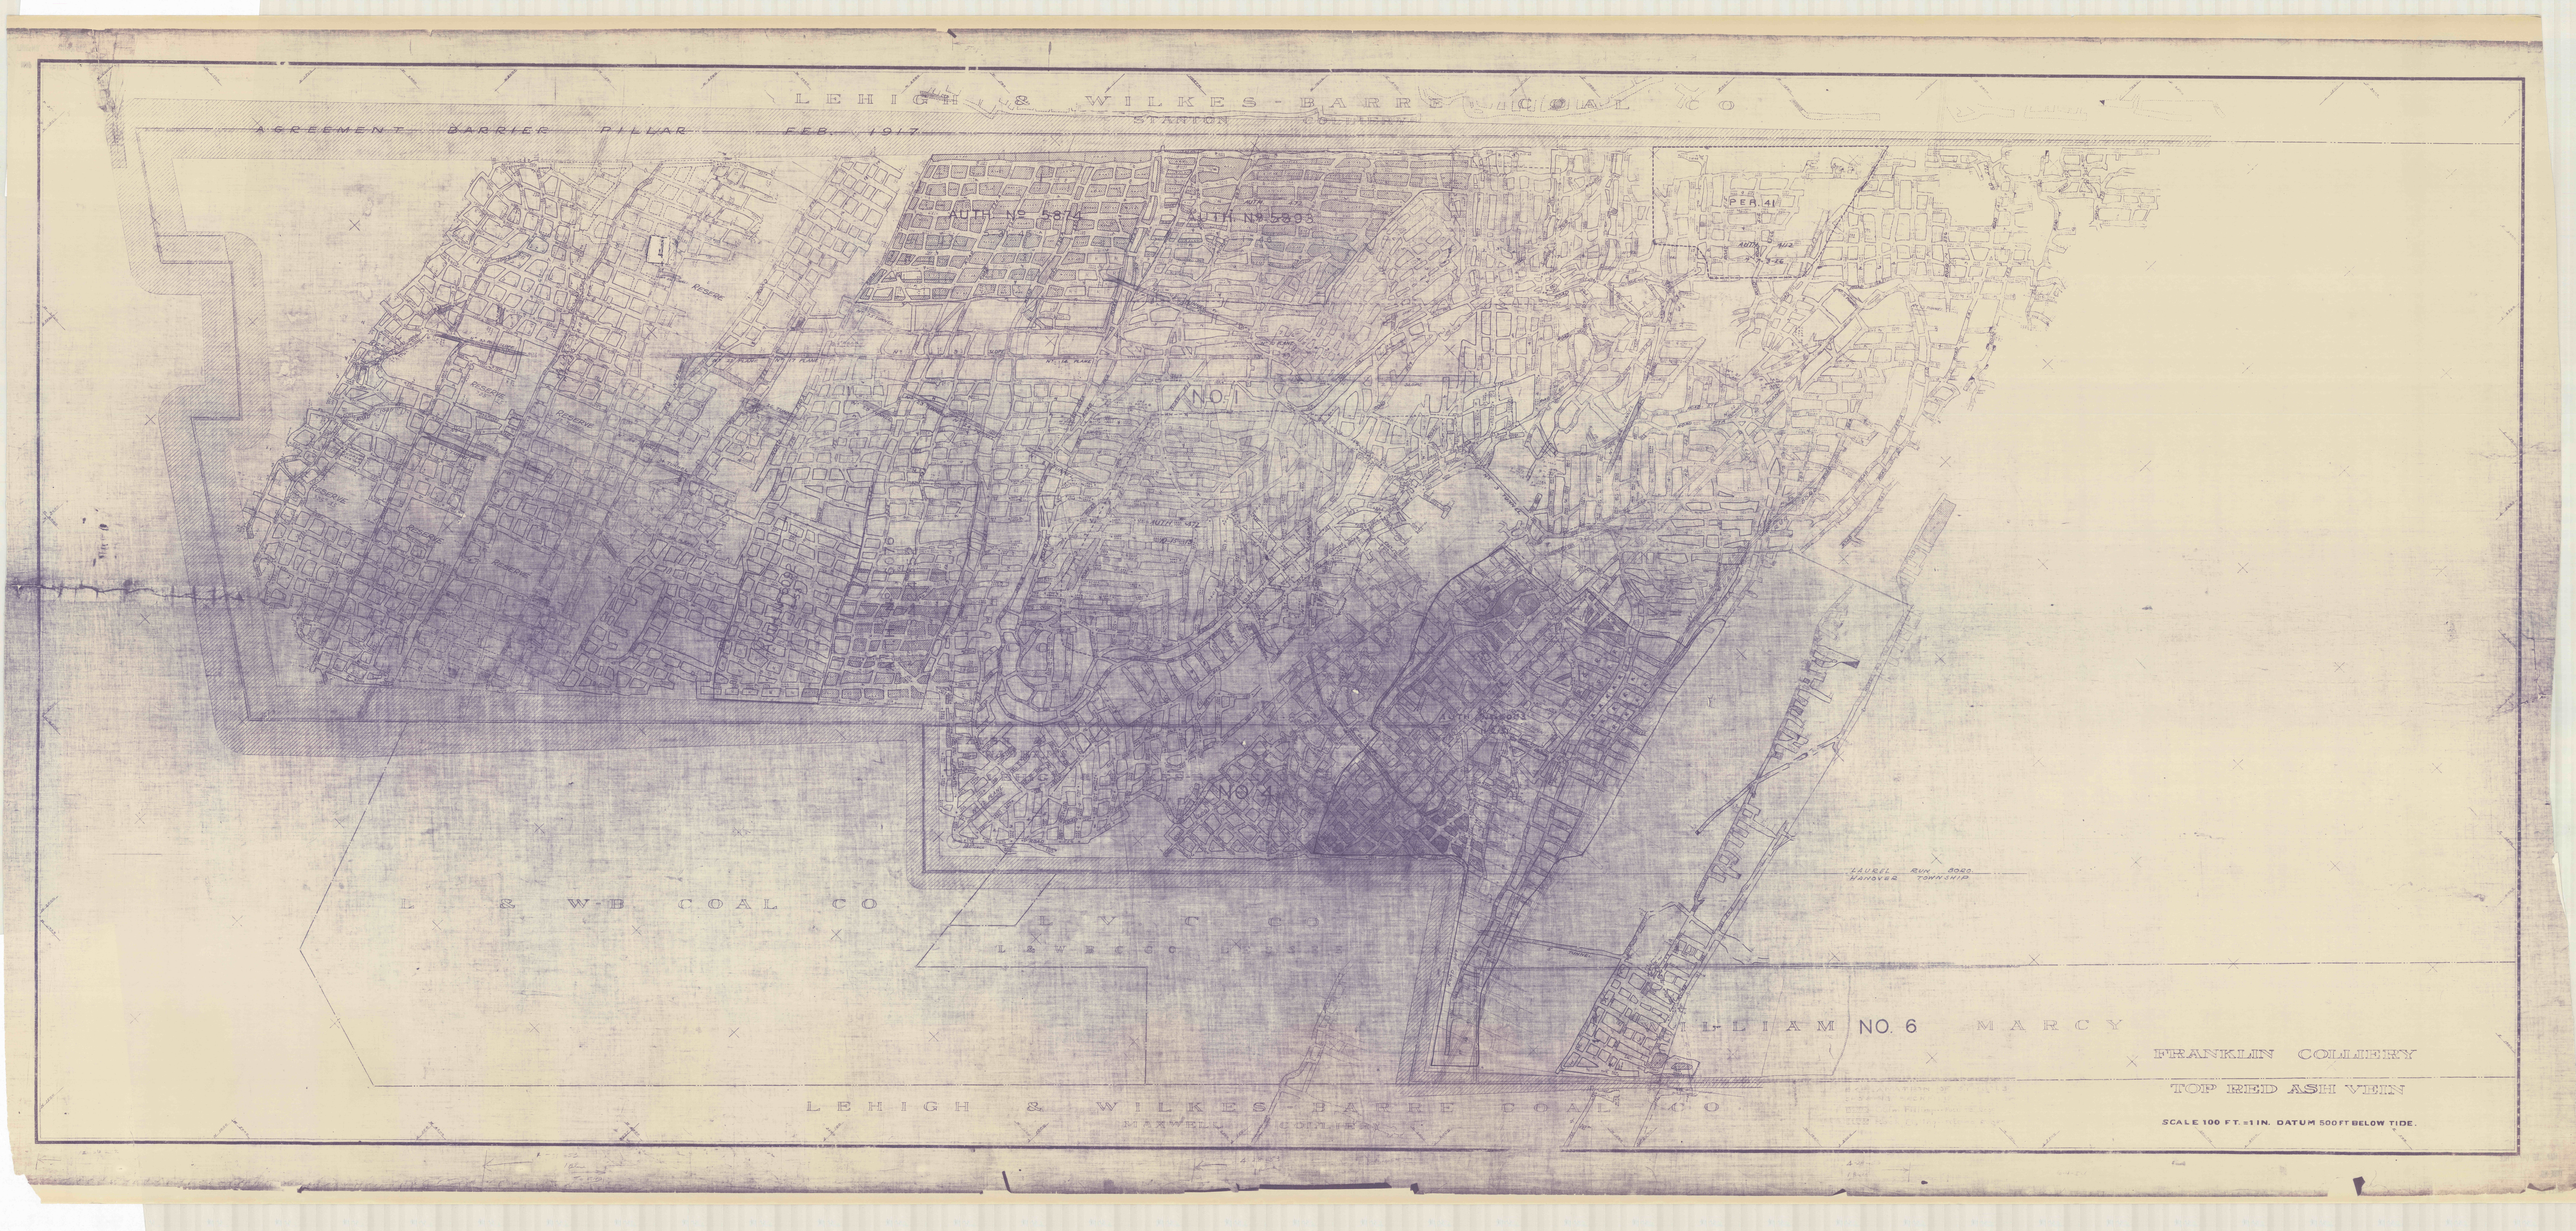
LEHIGH & WILKES-BARRE COAL CO
AGREEMENT BARRIER PILLAR FEB. 1917
AUTH. No. 5874
AUTH. No. 5893
FEB. 41
NO. 1
NO. 4
L & W-B COAL CO
L V T CO
LAWERENCE
WILLIAM NO. 6 MARCY
LEHIGH & WILKES-BARRE COAL CO
FRANKLIN COLLIERY
TOP RED ASH VEIN
SCALE 100 FT. = 1 IN. DATUM 500 FT BELOW TIDE.