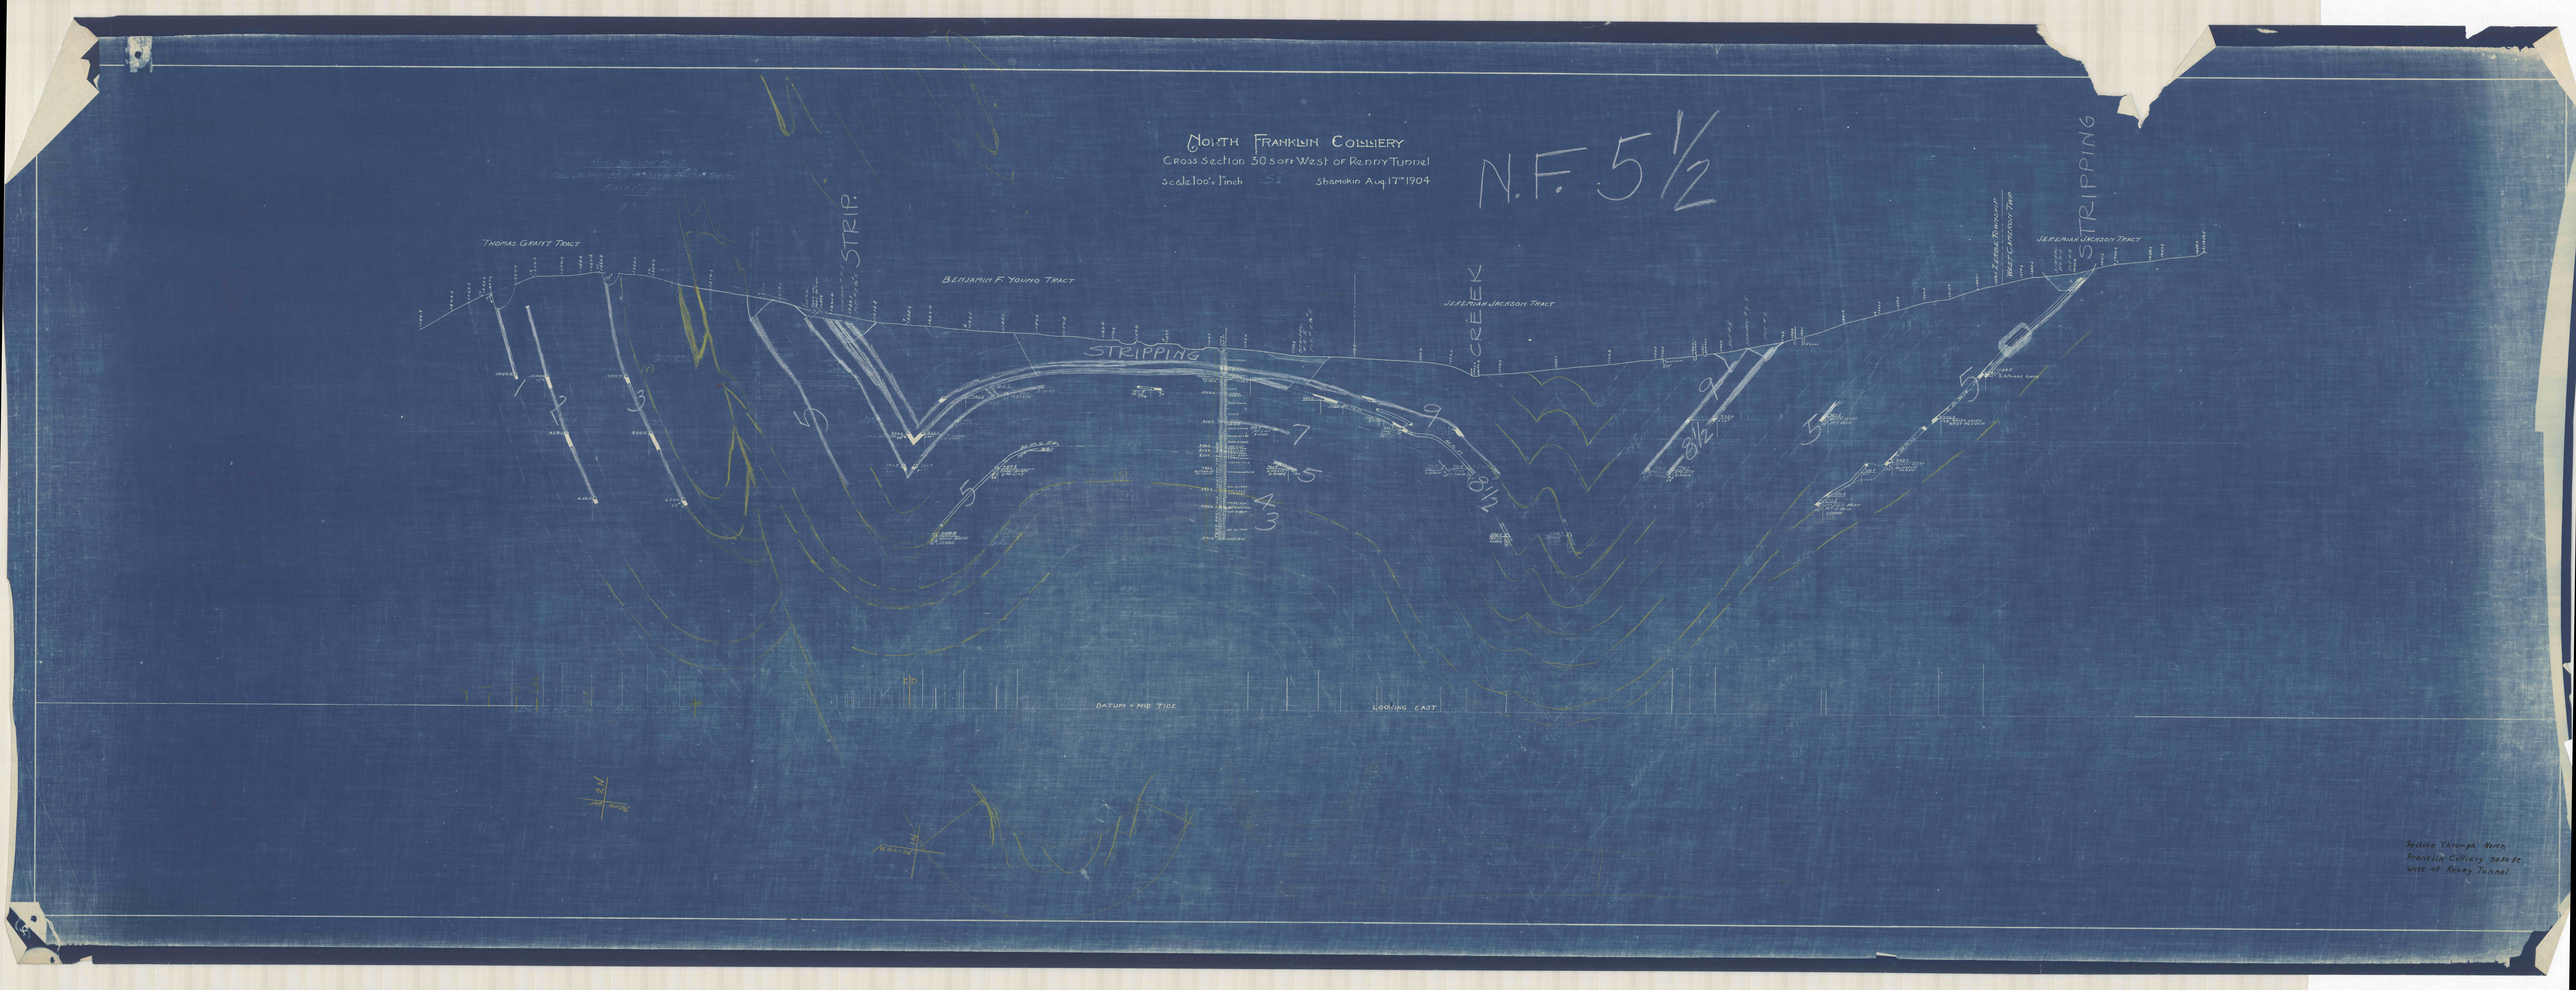

Section Through North Franklin Colliery 30 S Ft. West of Reddy Tunnel