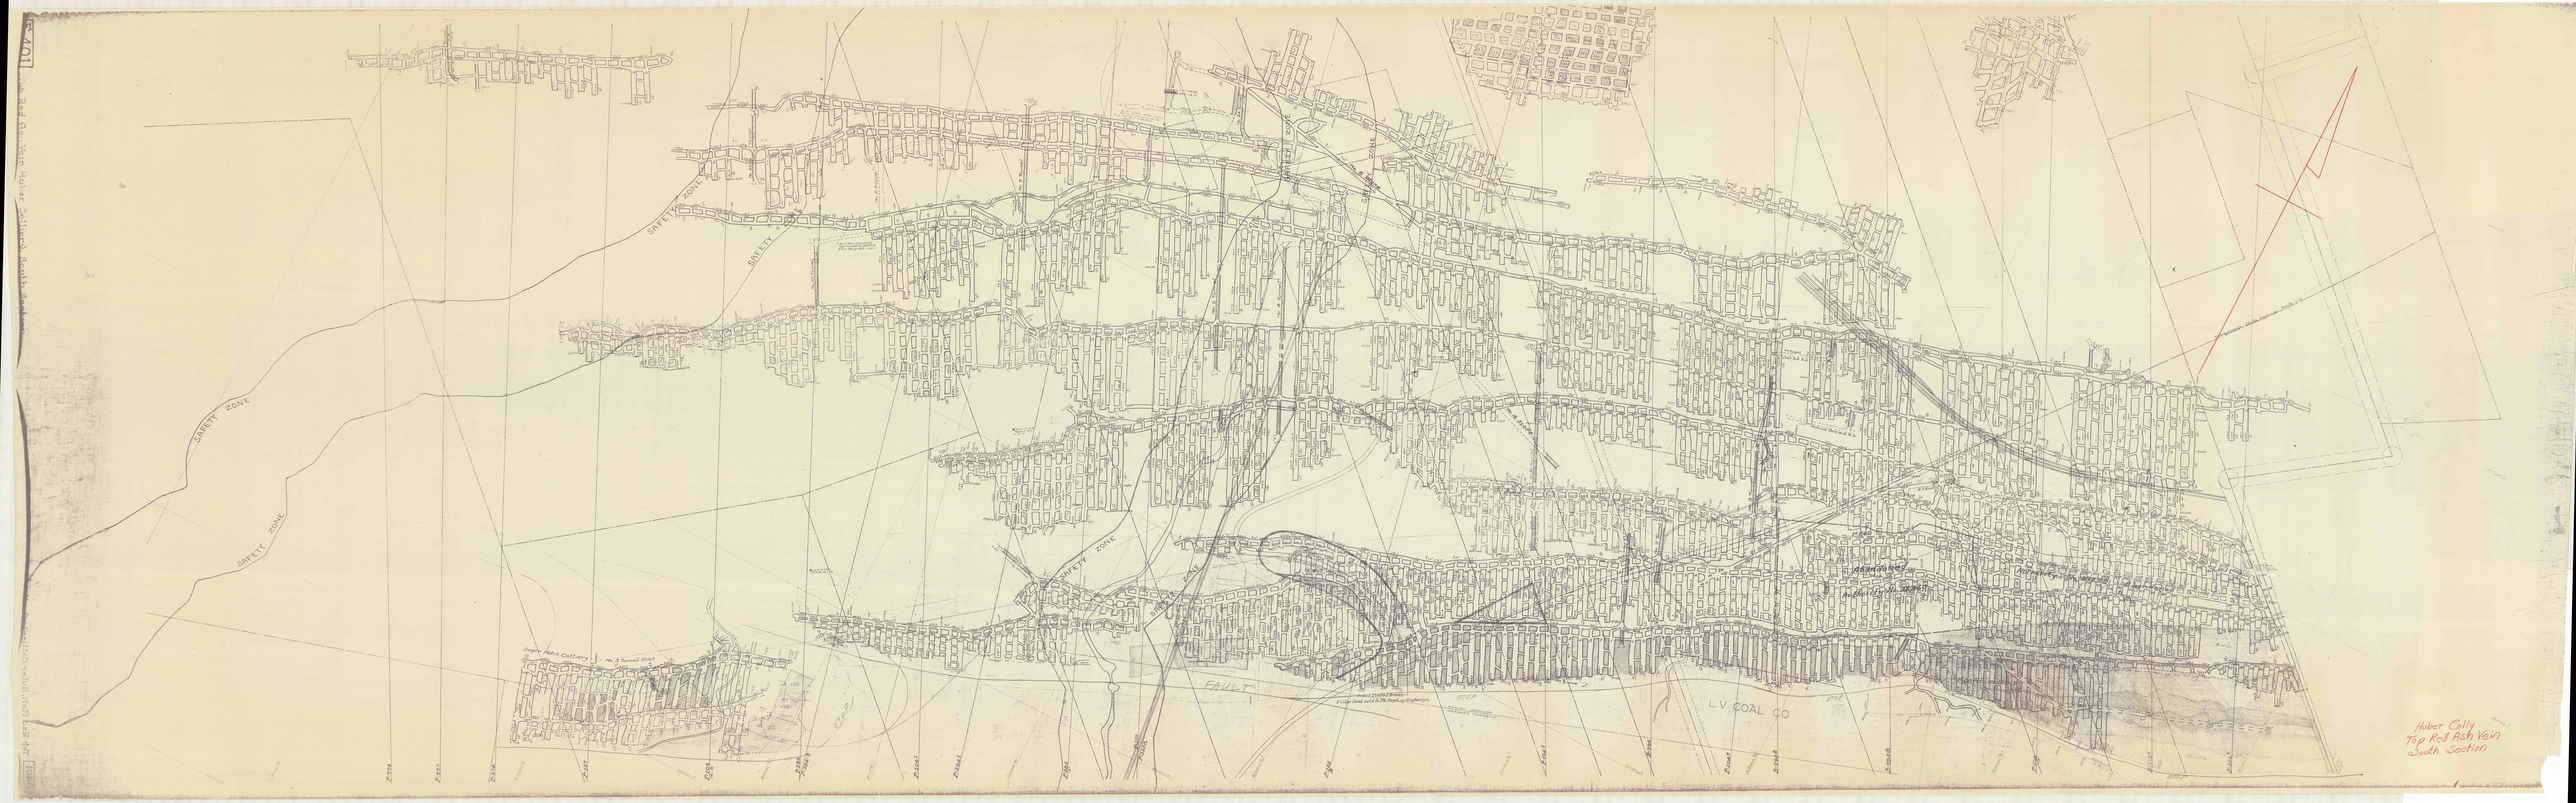
SAFETY ZONE
SAFETY ZONE
SAFETY ZONE
SAFETY ZONE
SAFETY ZONE
FAULT
L.V. COAL CO
Huber Colly
Top Red Ash Vein
South Section