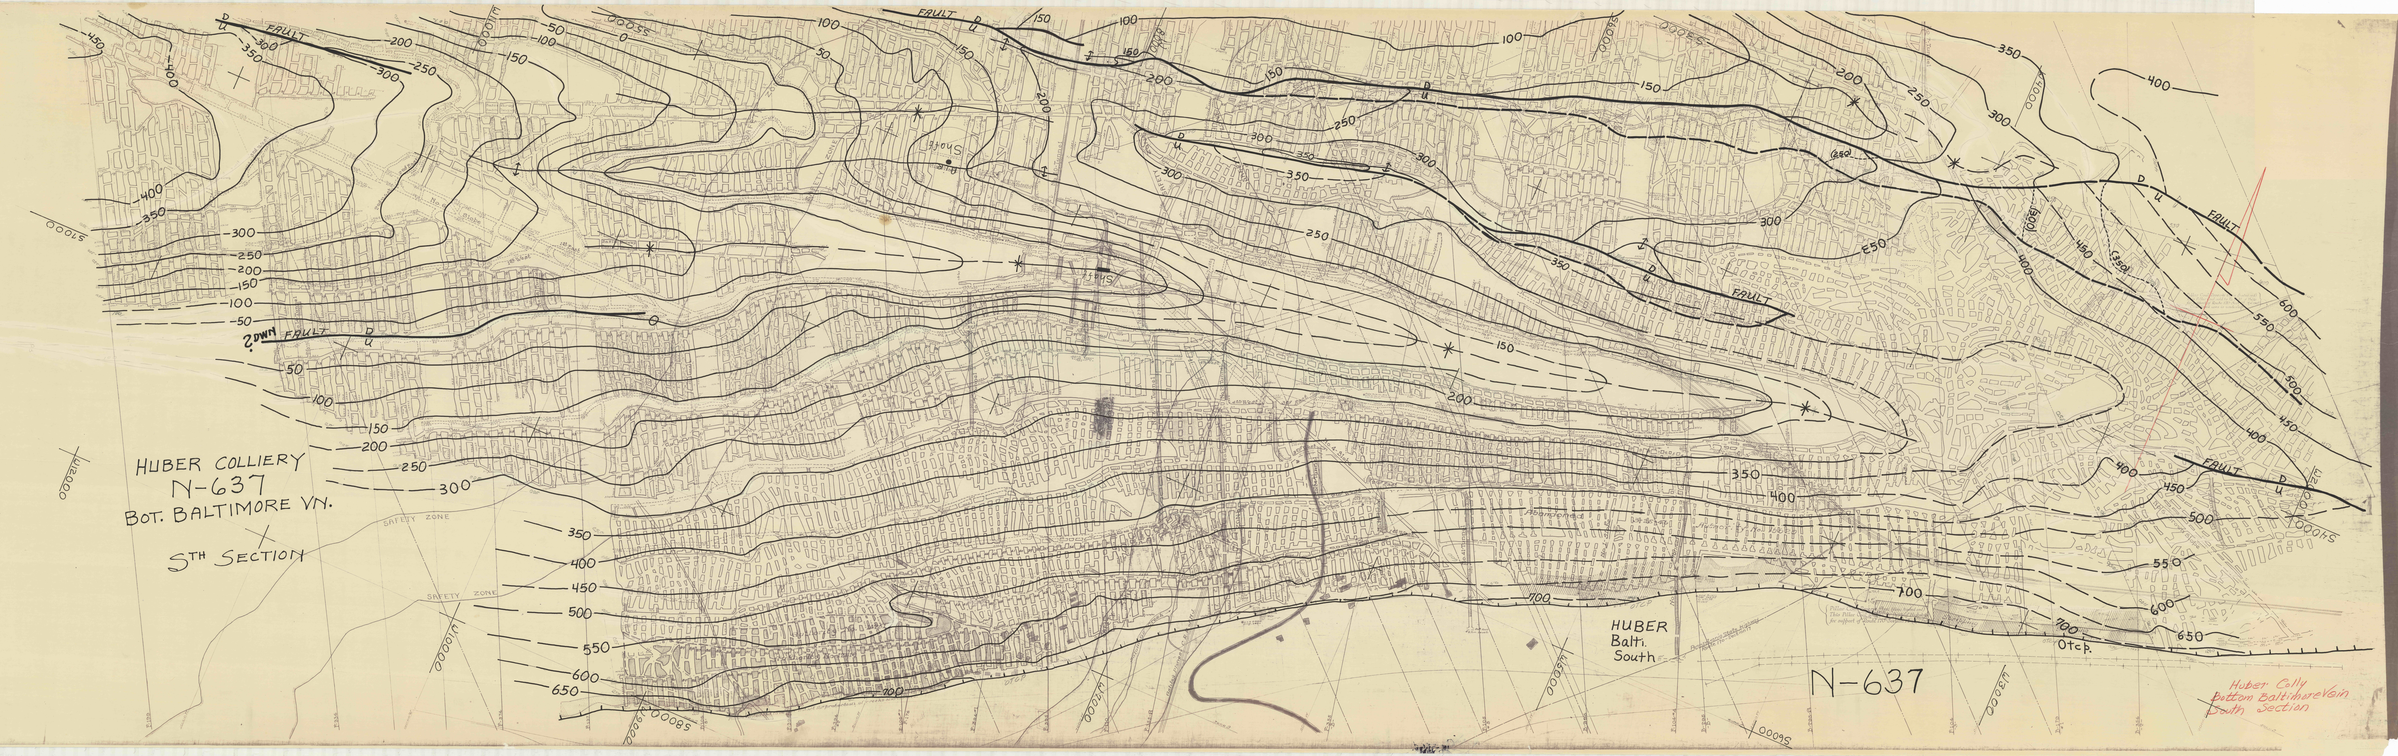

HUBER COLLIERY
N-637
BOT. BALTIMORE VN.
5TH SECTION
FAULT
2ND FAULT
HUBER
Balti.
South
N-637
Huber Colly
Bottom Baltimore Vein
South Section