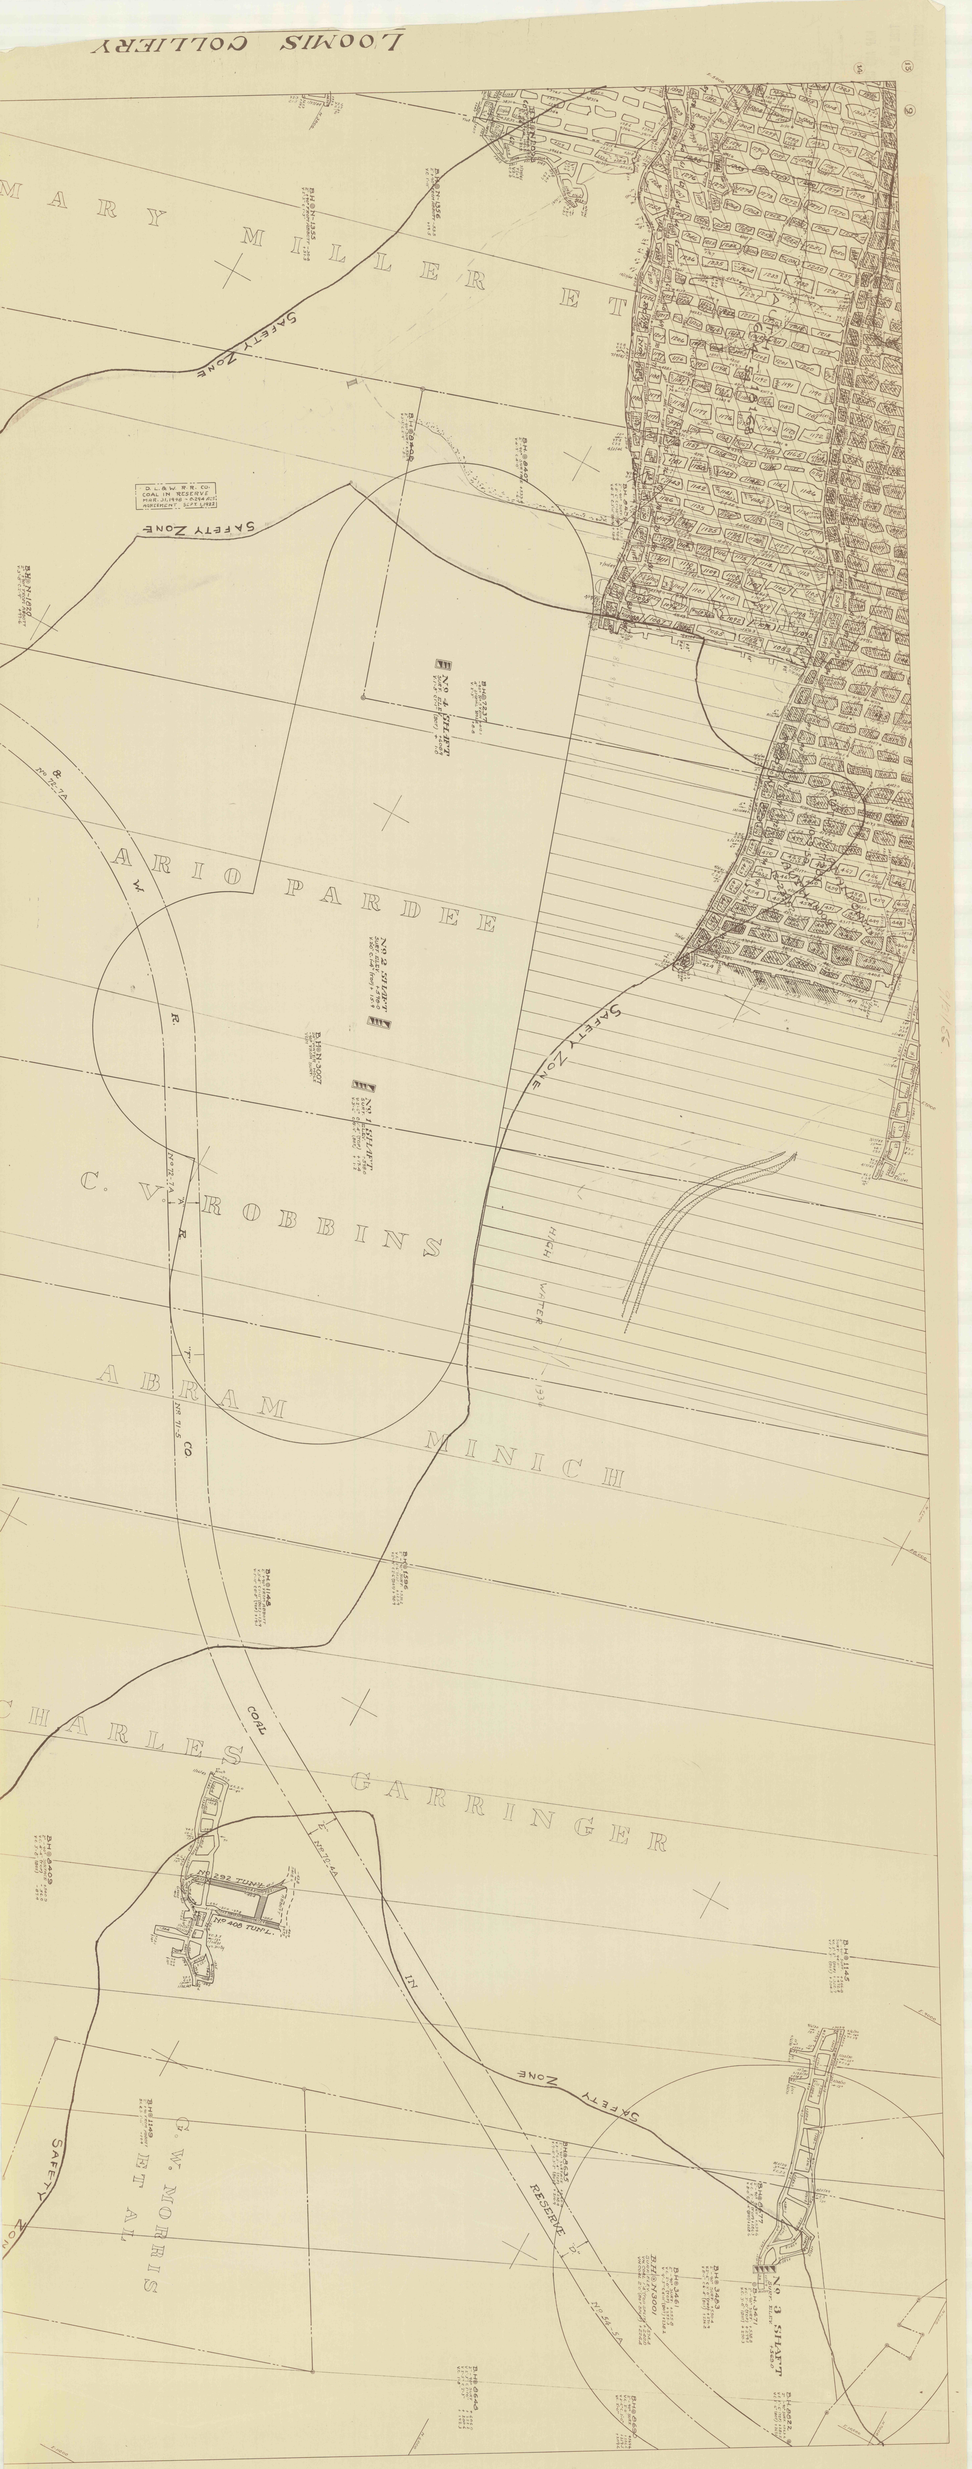

LOOMIS COLLIERY

GEORGE VEIN

No 10