


ABBOTT VEIN

NO 11

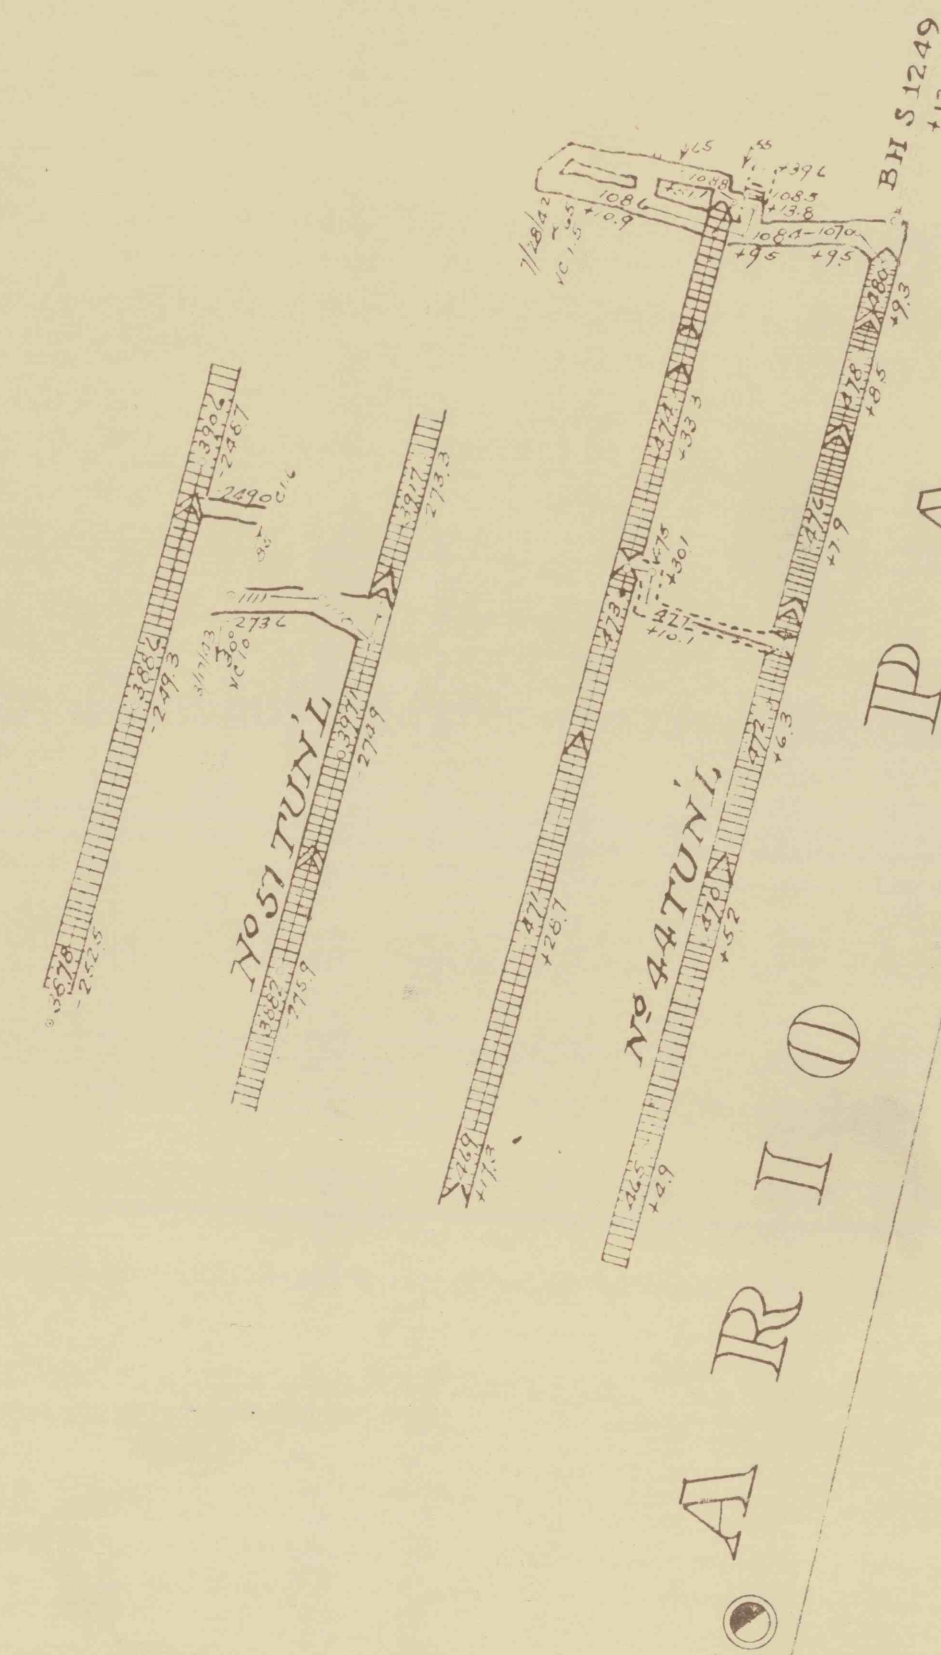

© BH S-1067
SURF. +565.7
YN 26 (TOP) +173.0
YN 24 (BOT) +138.5

B.H. S-1060
SURF 45476
VN 210 +103.0

AUTH

1020

IRIBINS

W I C H

SARAH

A. B. ANDONED

AUTH. 18345

©B.H. 3374
-90°
SURF. +580.9
VN. 4' 2" +58.2

MEIKER NO

COOMIS COLLERY

ABBOTT VEIN

NO 11