


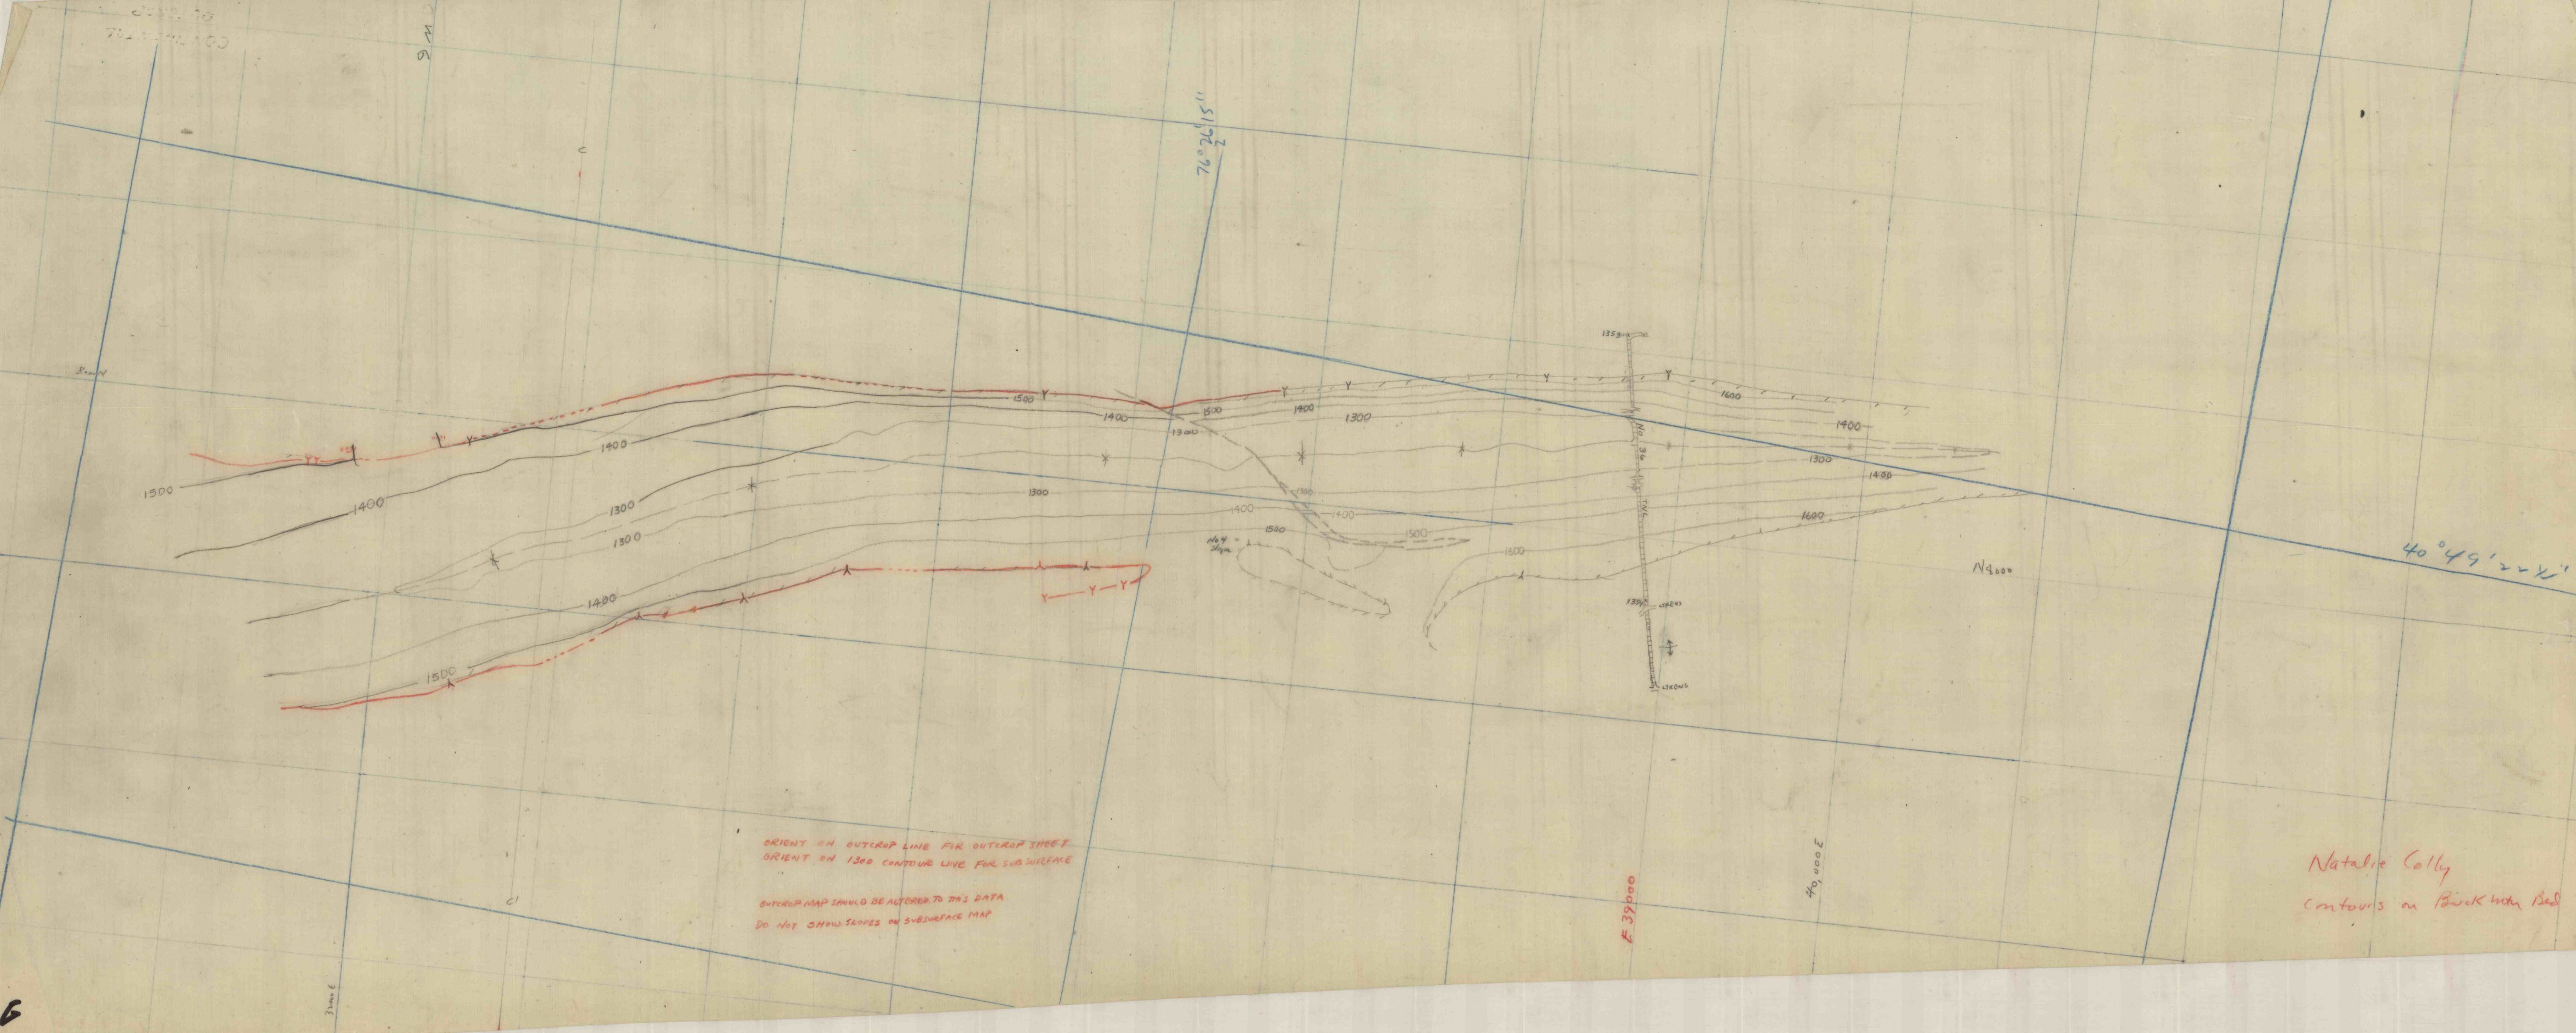

ORIENT ON OUTCROP LINE FOR OUTCROP SHEET
ORIENT ON 1300 CONTOUR LINE FOR SUBSURFACE
OUTCROP MAP SHOULD BE ALTERED TO THIS DATA
DO NOT SHOW SLOPES ON SUBSURFACE MAP

Natalie Cally
Contours on Blackwater Bend