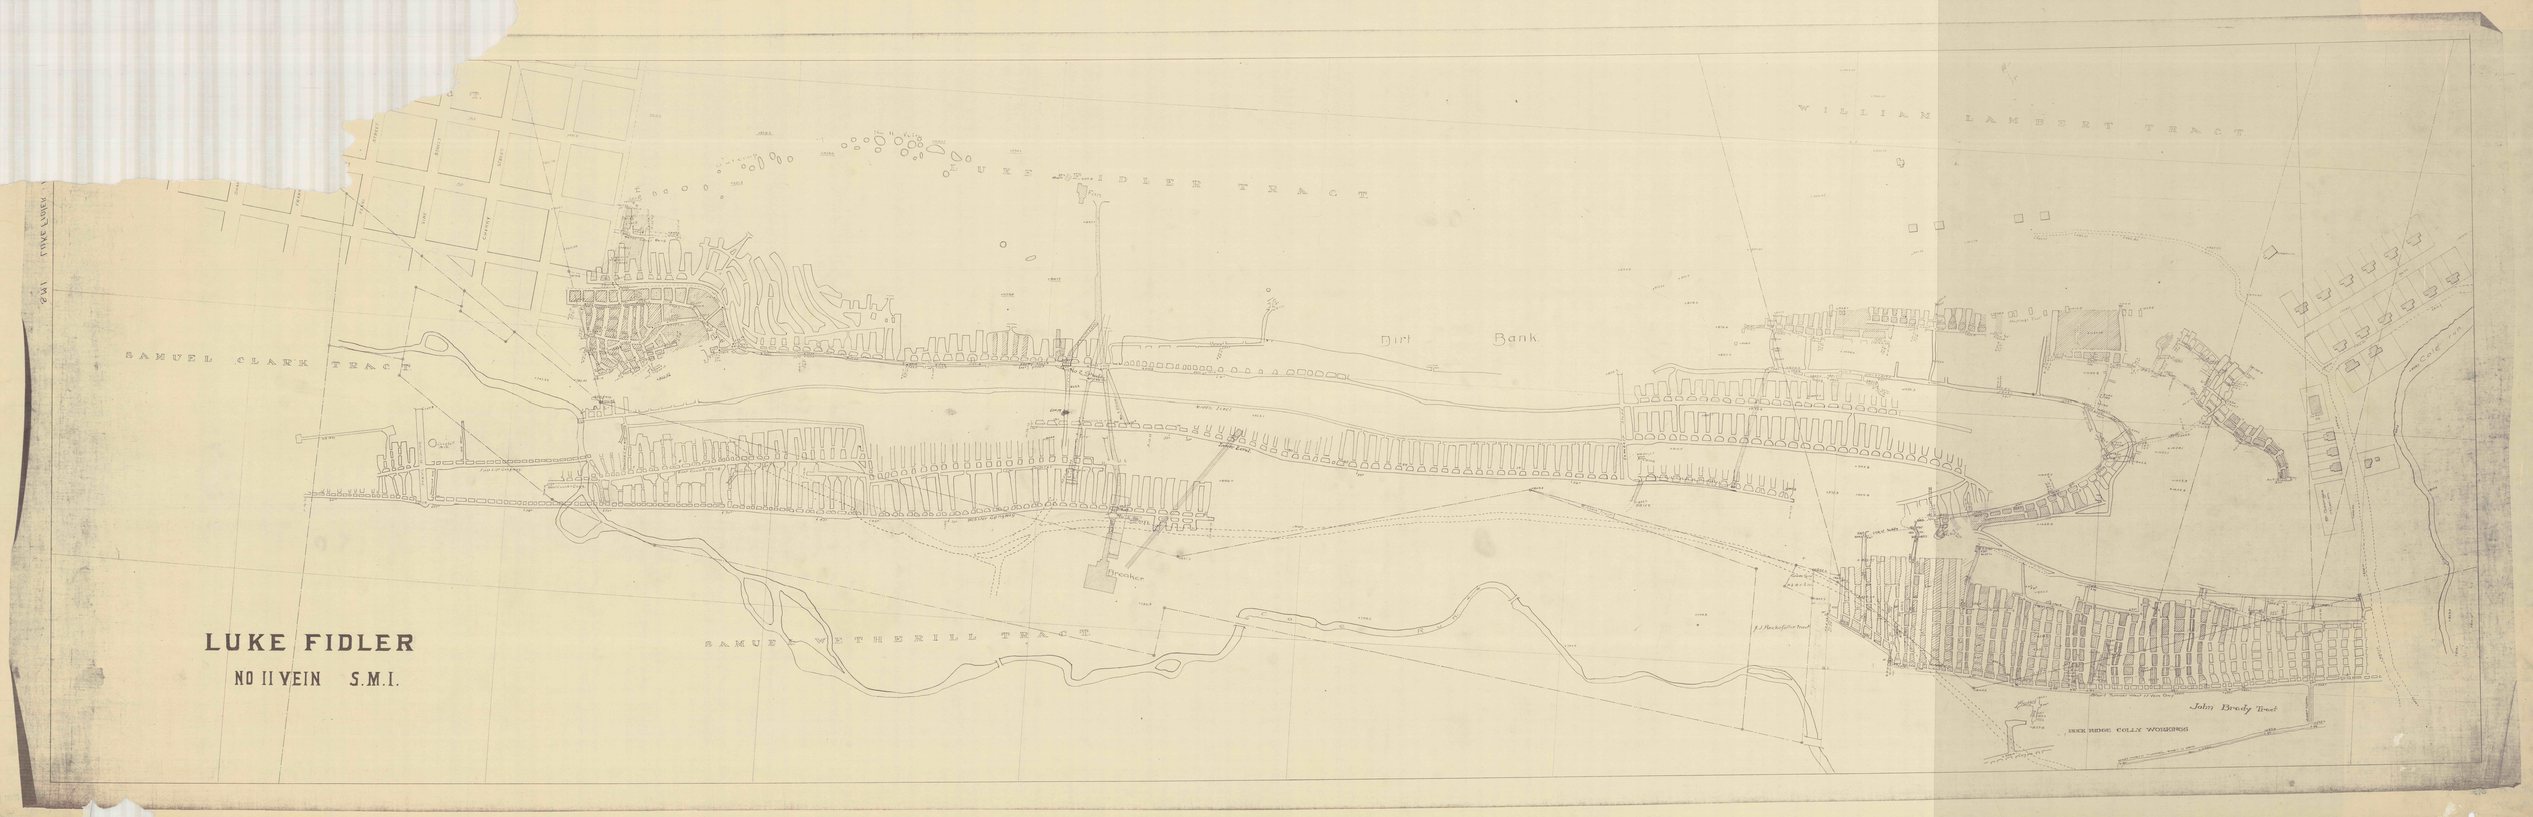
LUKE FIDLER
NO II VEIN S.M.I.
SAMUEL CLARK TRACT
LUKE FIDLER TRACT
WILLIAM LAMBERT TRACT
Dirt Bank
Breaker
SAMUEL WETHERILL TRACT
John Brady Tract
BOX RIDGE COLLY WORKINGS