


LOOKING EAST
SECTION NO. 3

2 1/3

FLT 50° N

FLT 50° N

1874 DIAMOND DRILL HOLE NO. 3

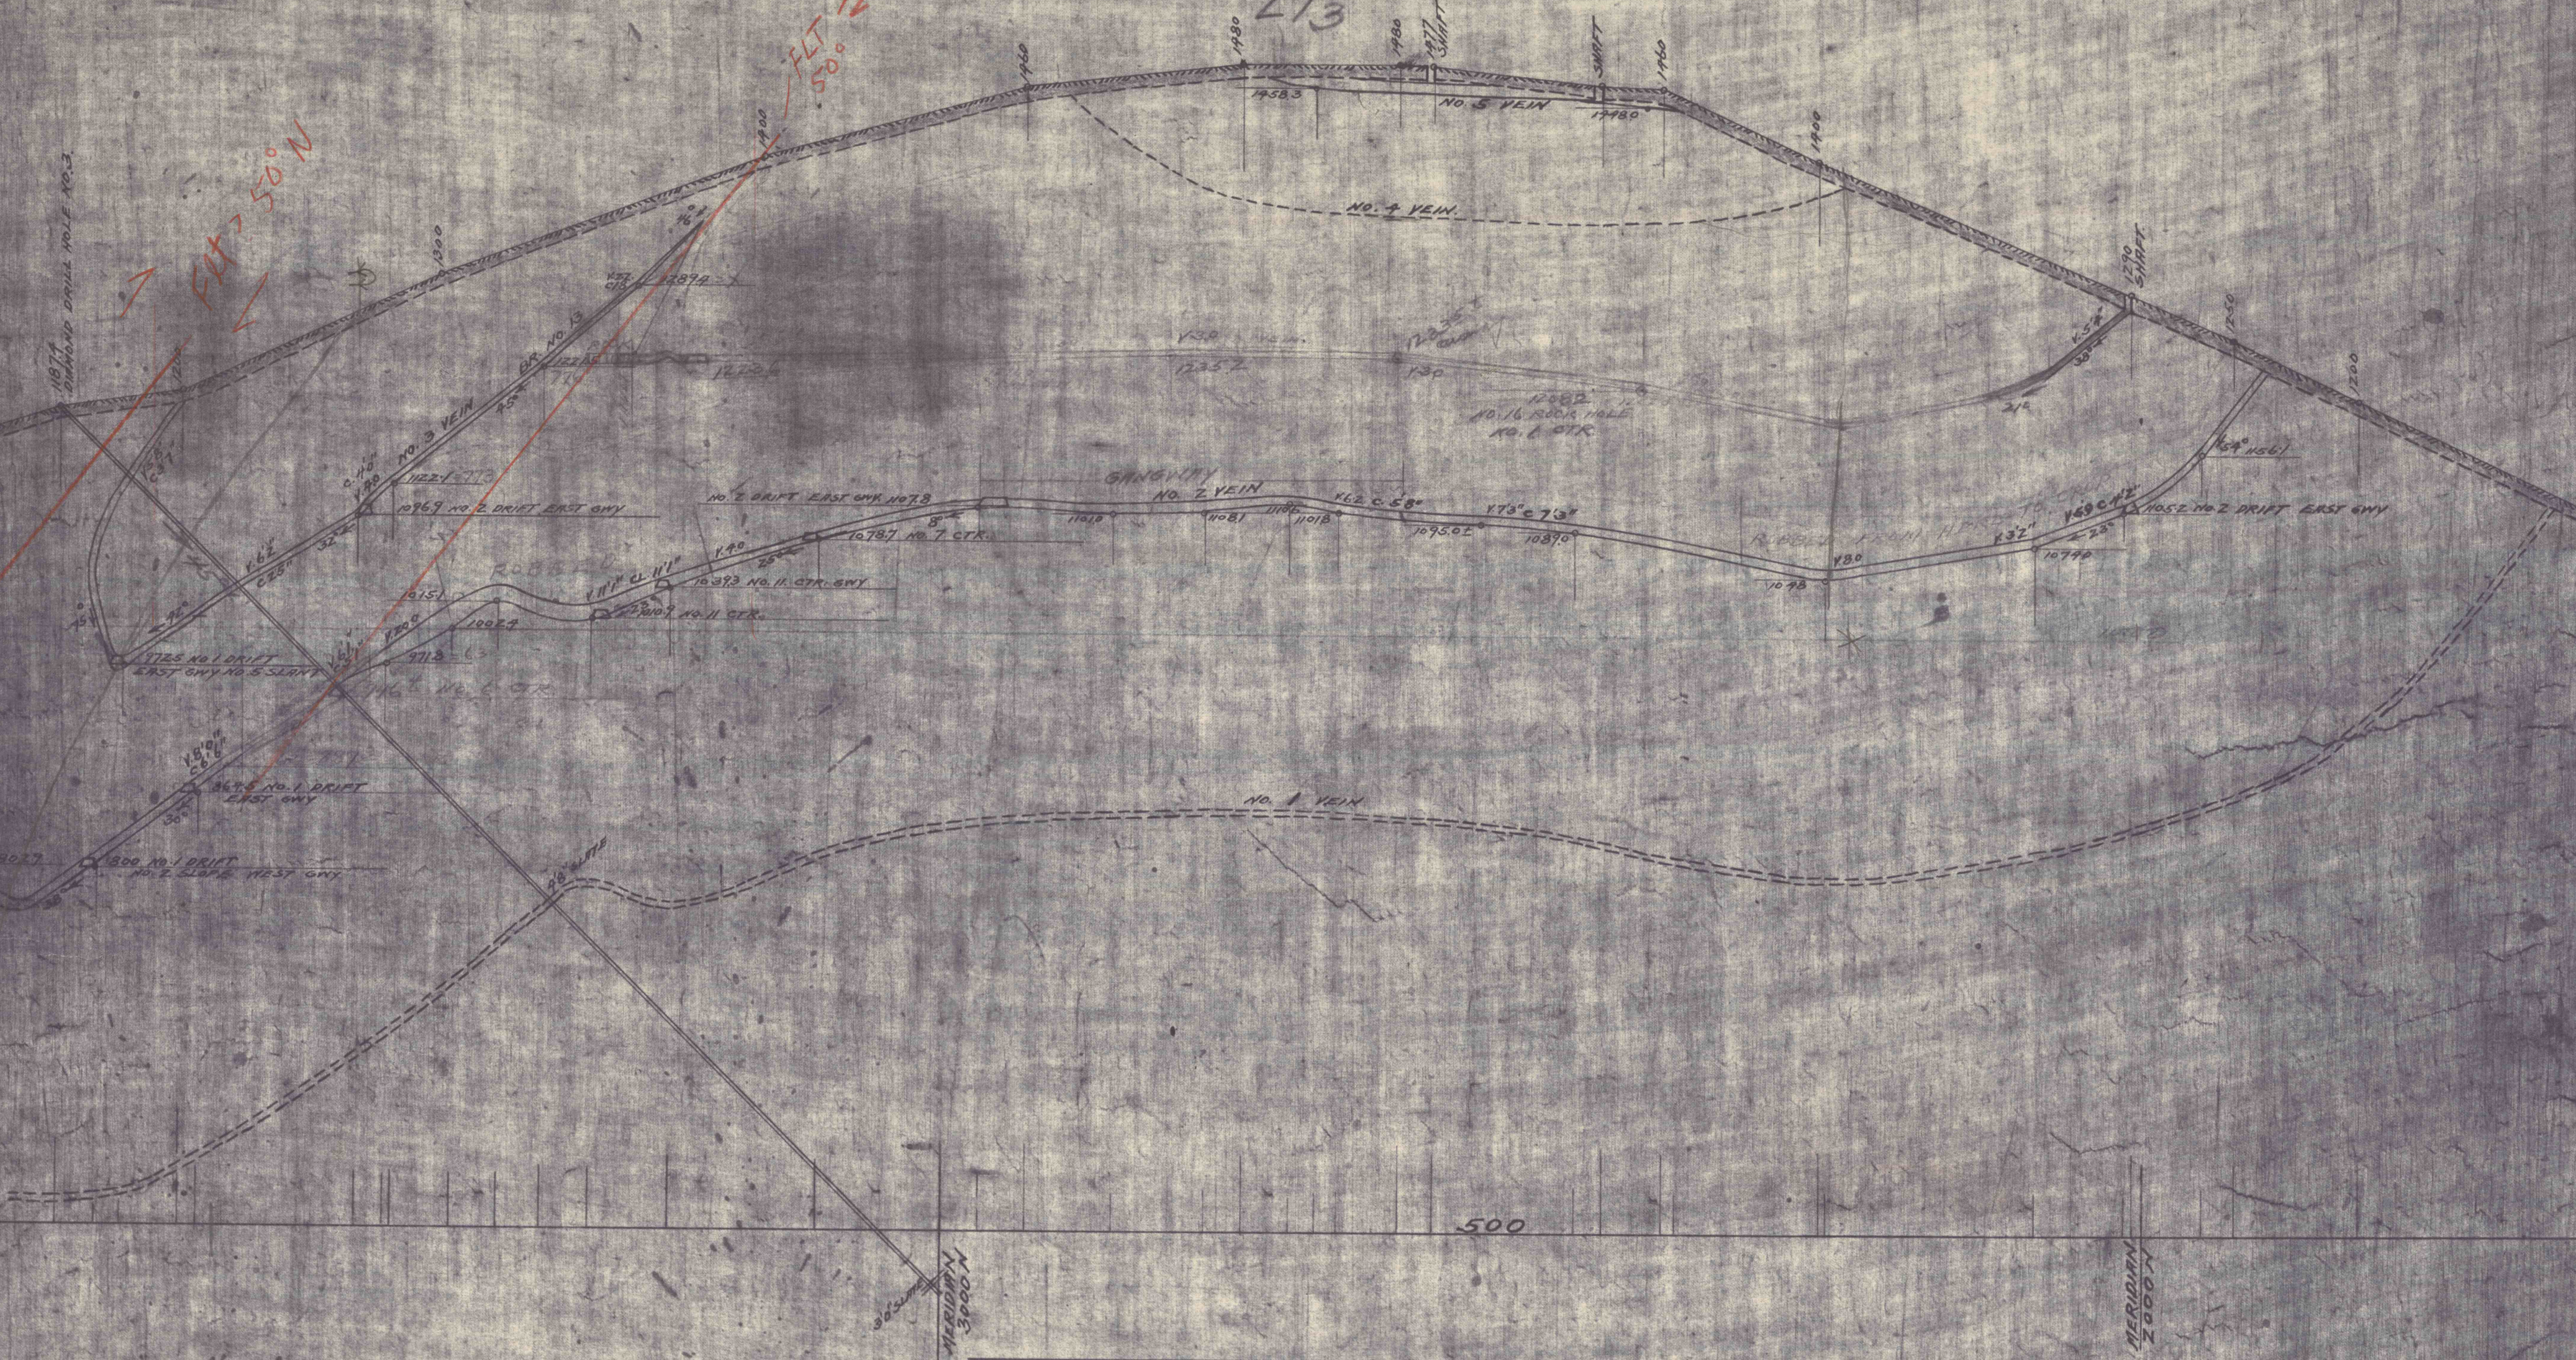

KATHERINE COLLIERY

CROSS SECTION 80 FEET WEST OF AND PARALLEL TO MERIDIAN LINE 6000 EAST.

SCALE 1"=100'

DUNKELBERGERS, JR.

TREYORTON COLLIERY CO.

MARCH 11-1918

CLEVELAND, OHIO.

W.S. BOYD

ENGR.