



KATHERINE COLLIERY
CROSS SECTION 270 FEET WEST OF AND PARALLEL TO EASTERN BARRIER PILLAR LINE
TREVORTON COLLIERY CO.

DUNKLEBERGERS, P.A.

MARCH 30-1923

INDEX NO. 2138

LOOKING EAST

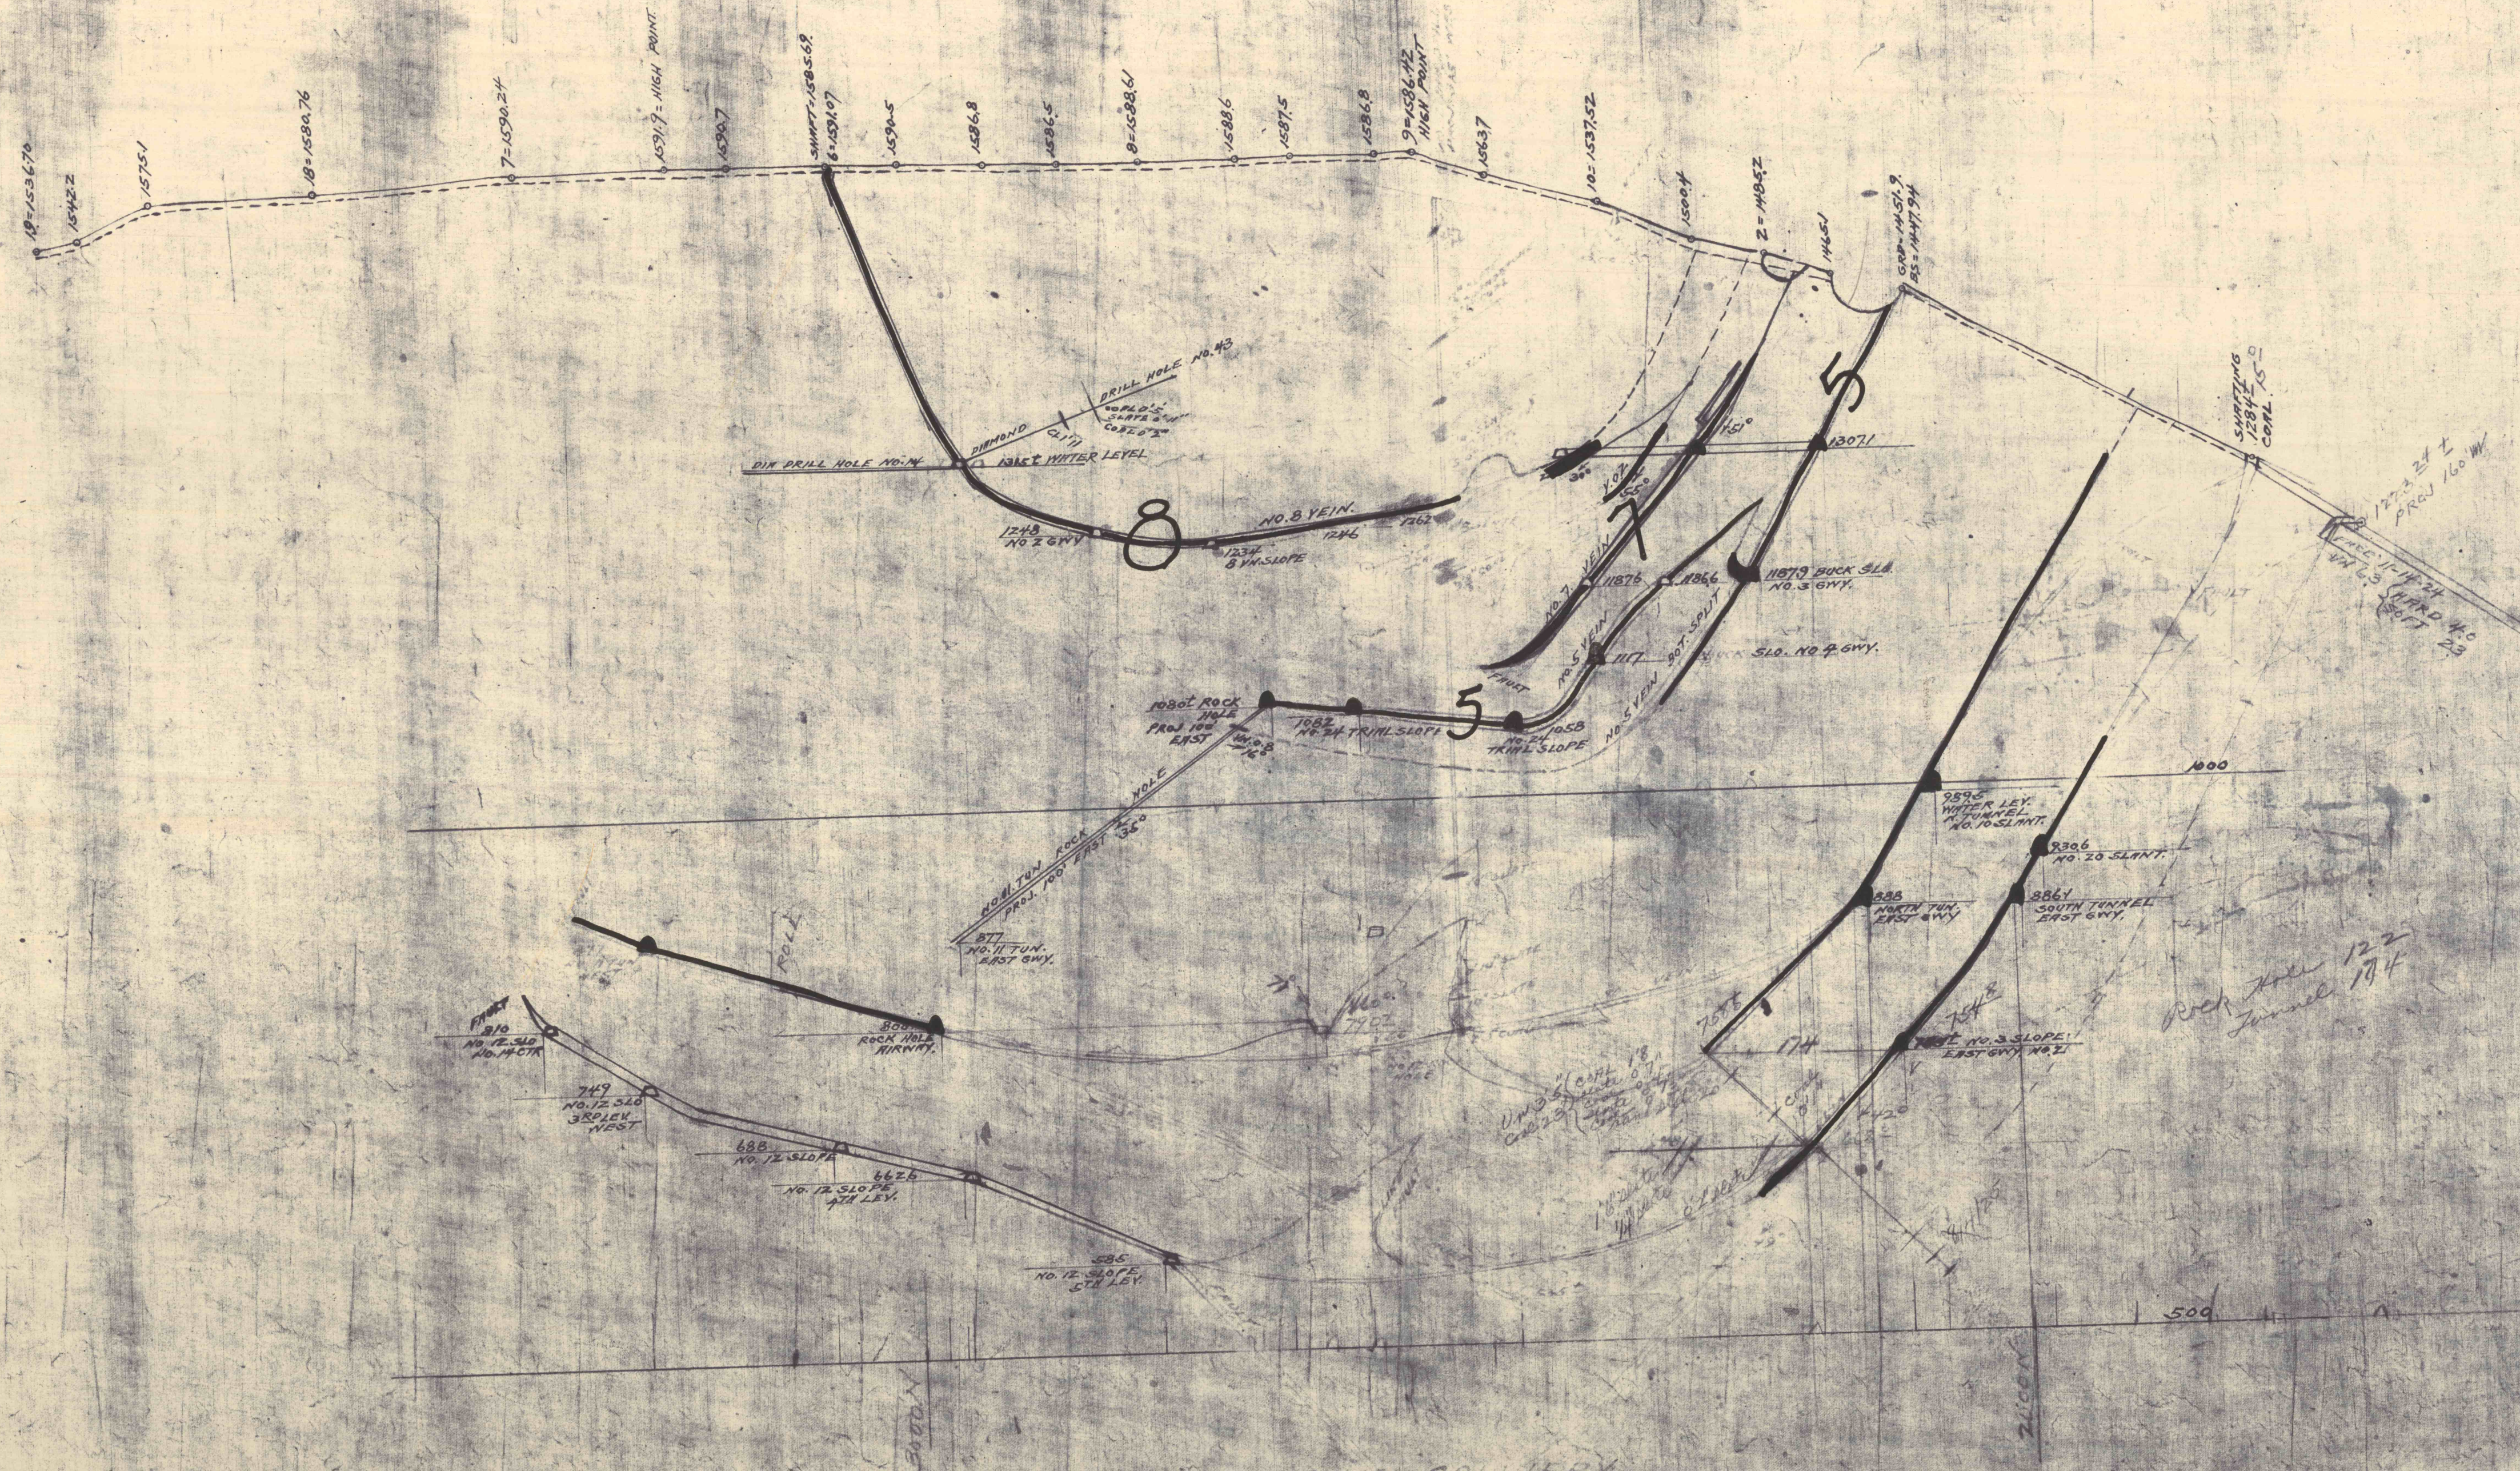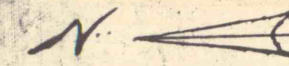

KATHERINE COLLIERY
CROSS SECTION 270 FEET WEST OF AND PARALLEL TO THE EASTERN BARRIER PILLAR LINE
TREVORTON COLLIERY CO.
DUNKLEBERGERS, P.A.
MARCH 30-1923
INDEX NO. 2138
LOOKING EAST