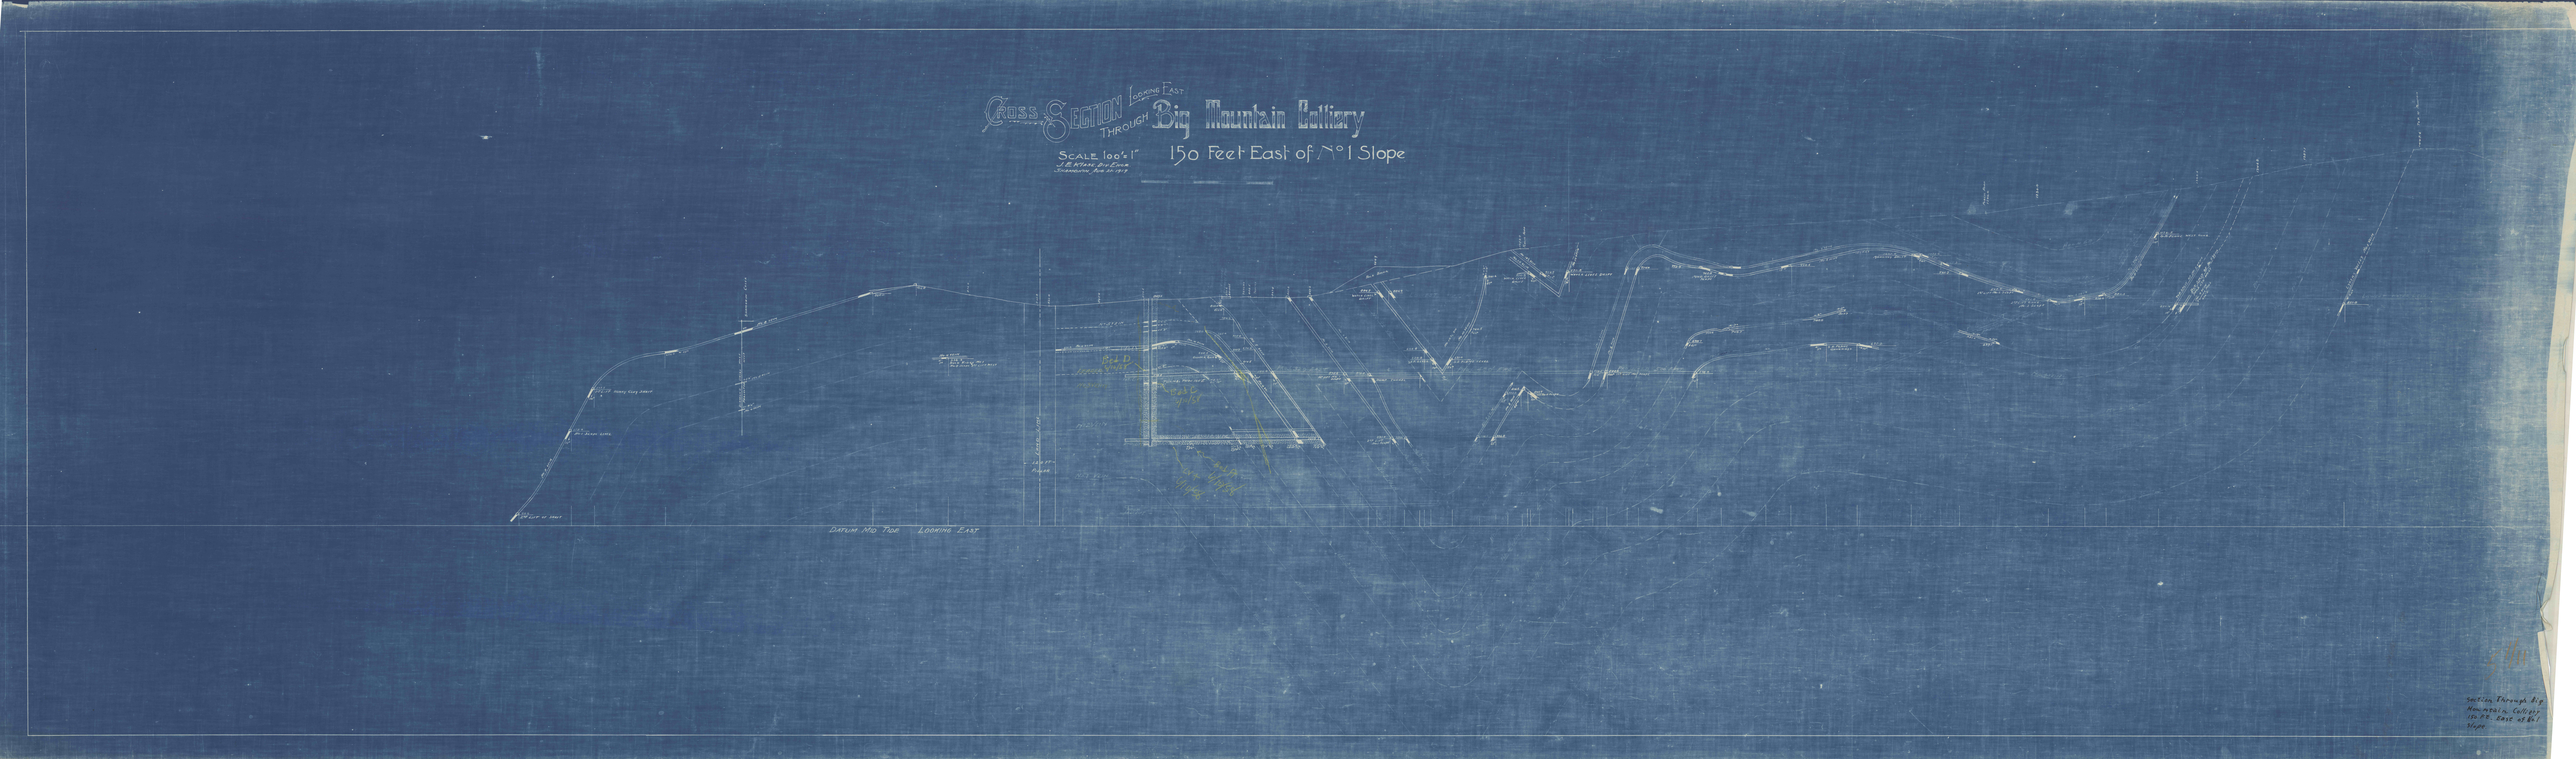
Cross Section Looking East Through Big Mountain Colliery
Scale 100'=1"
J. E. Kipp, Div. Engr.
Scranton, Jan. 31, 1919
150 Feet East of No 1 Slope
Datum Mid Tide Looking East
Section Through Big Mountain Colliery 150 Ft. East of No 1 Slope