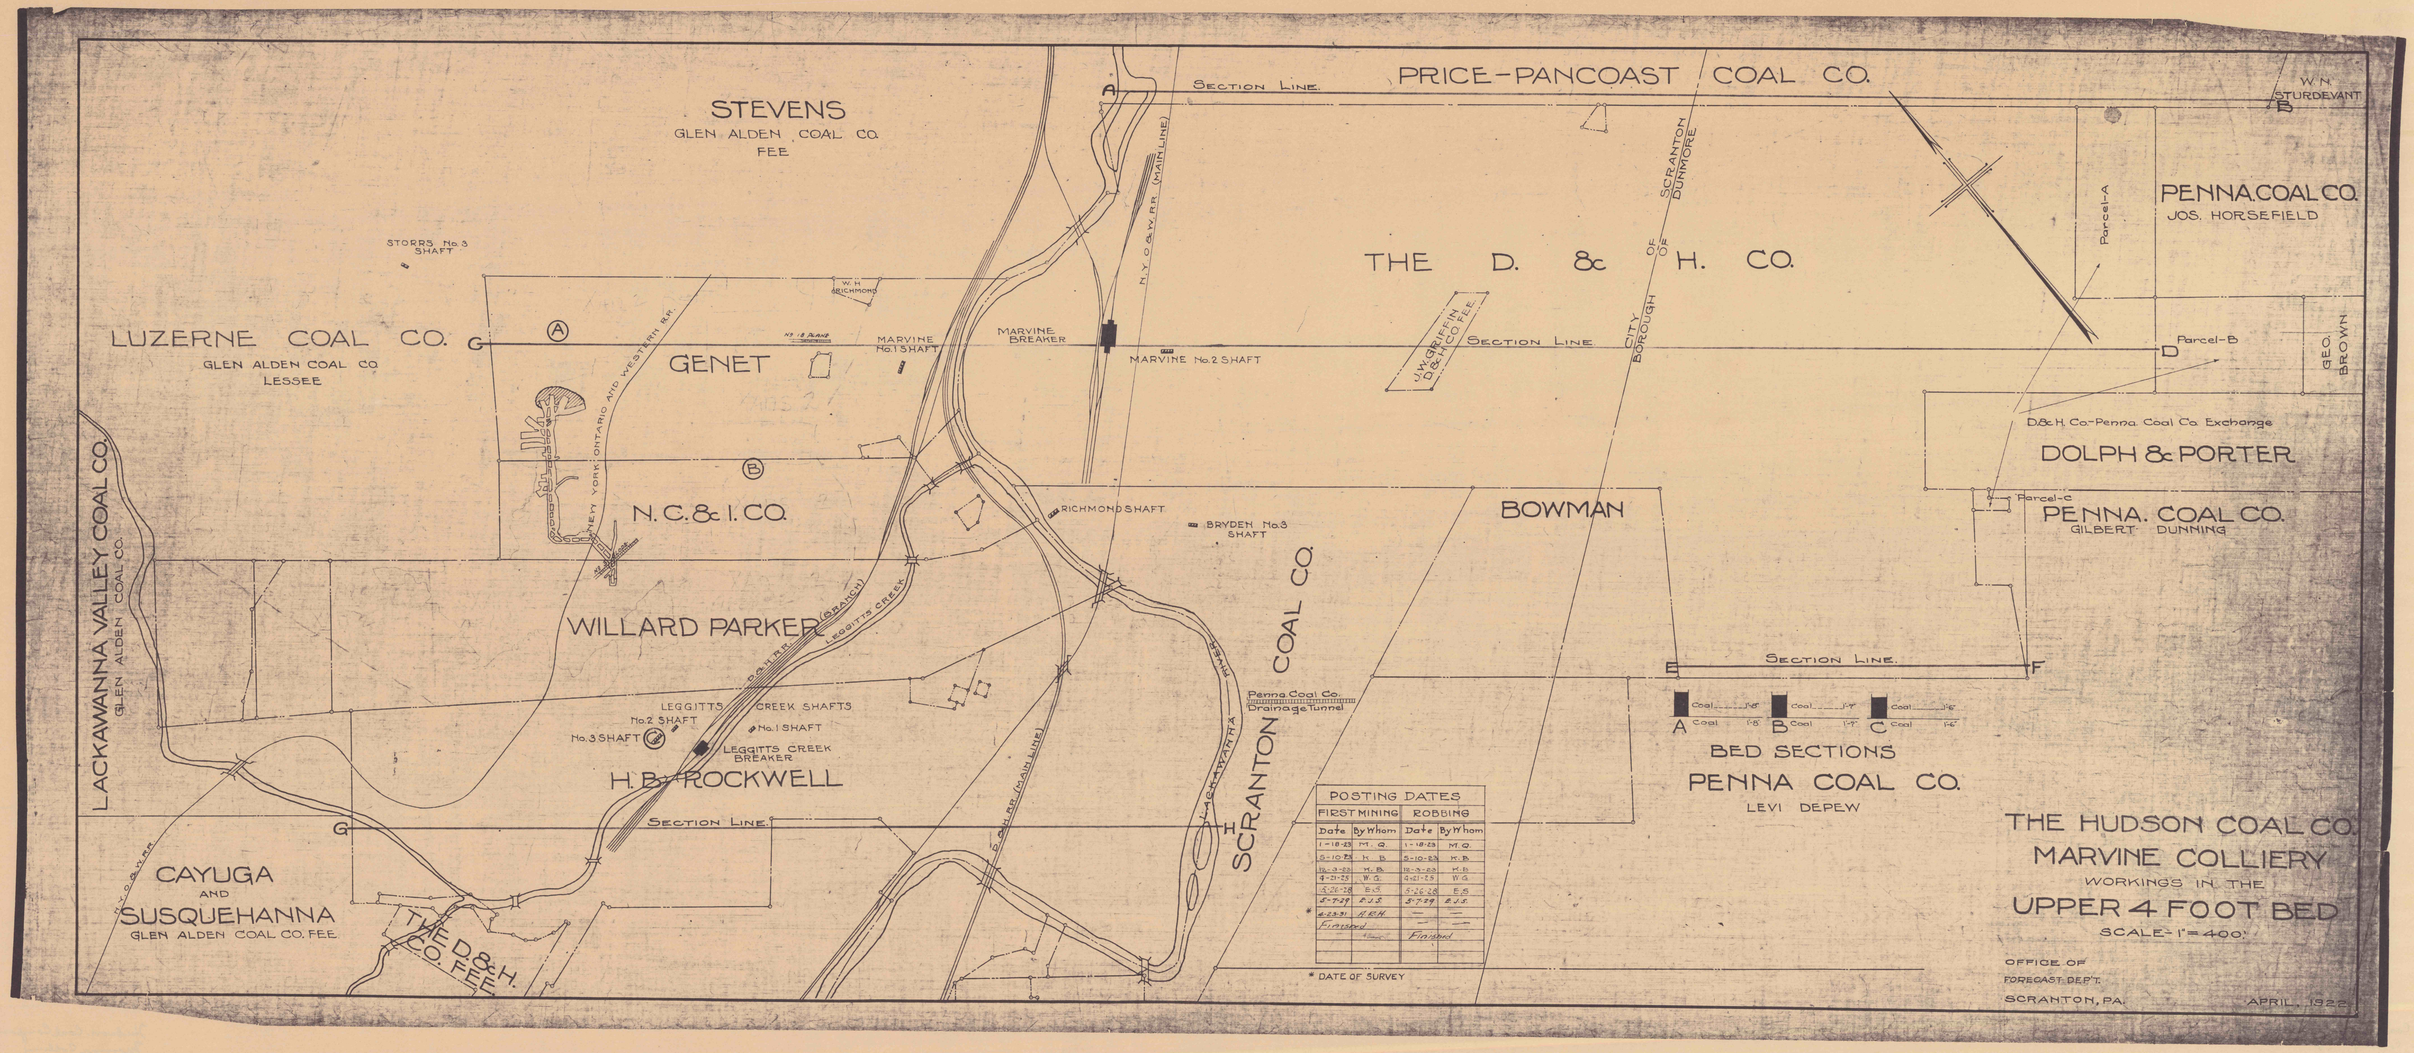
STEVENS
GLEN ALDEN COAL CO.
FEE
PRICE-PANCOAST COAL CO.
SECTION LINE
W.N. STURDEVANT
PENNA. COAL CO.
JOS. HORSEFIELD
Parcel-A
Parcel-B
GEO. BROWN
THE D. & H. CO.
SCRANTON DUNMORE
CITY OF BOROUGH OF
STORRS No. 3 SHAFT
W.H. RICHMOND
LUZERNE COAL CO.
GLEN ALDEN COAL CO.
LESSEE
GENET
MARVINE No. 1 SHAFT
MARVINE BREAKER
MARVINE No. 2 SHAFT
N.Y. O. & W. RR. (MAIN LINE)
J.W. GRIFFIN D.&H. CO. FEE
D.&H. Co.-Penna. Coal Co. Exchange
DOLPH & PORTER
Parcel-C
PENNA. COAL CO.
GILBERT DUNNING
NEW YORK ONTARIO AND WESTERN RR.
N.C. & I. CO.
RICHMOND SHAFT
BRYDEN No. 3 SHAFT
BOWMAN
LACKAWANNA VALLEY COAL CO.
GLEN ALDEN COAL CO.
WILLARD PARKER
D.&H. RR. (BRANCH)
LEGGITTS CREEK
LACKAWANNA RIVER
SCRANTON COAL CO.
Penna. Coal Co. Drainage Tunnel
LEGGITTS CREEK SHAFTS
No. 2 SHAFT
No. 1 SHAFT
No. 3 SHAFT
LEGGITTS CREEK BREAKER
H. B. ROCKWELL
SECTION LINE
E. & W. RR. (MAIN LINE)
CAYUGA AND SUSQUEHANNA
GLEN ALDEN COAL CO. FEE
THE D.&H. CO. FEE
POSTING DATES
FIRST MINING
ROBBING
Date
By Whom
1-18-23 M.Q.
5-10-23 H.B.
12-3-23 H.B.
4-21-25 W.G.
5-20-28 E.S.
5-7-29 E.J.S.
6-23-31 H.E.H.
Finished
* DATE OF SURVEY
Coal 1'-8"
Coal 1'-9"
Coal 1'-6"
A
B
C
BED SECTIONS
PENNA COAL CO.
LEVI DEPEW
THE HUDSON COAL CO.
MARVINE COLLIERY
WORKINGS IN THE
UPPER 4 FOOT BED
SCALE-1"=400'
OFFICE OF
FORECAST DEP'T.
SCRANTON, PA.
APRIL, 1922